


1 TREX DECK FRAMING PLAN - RETAIL A

1/4" = 1'-0"

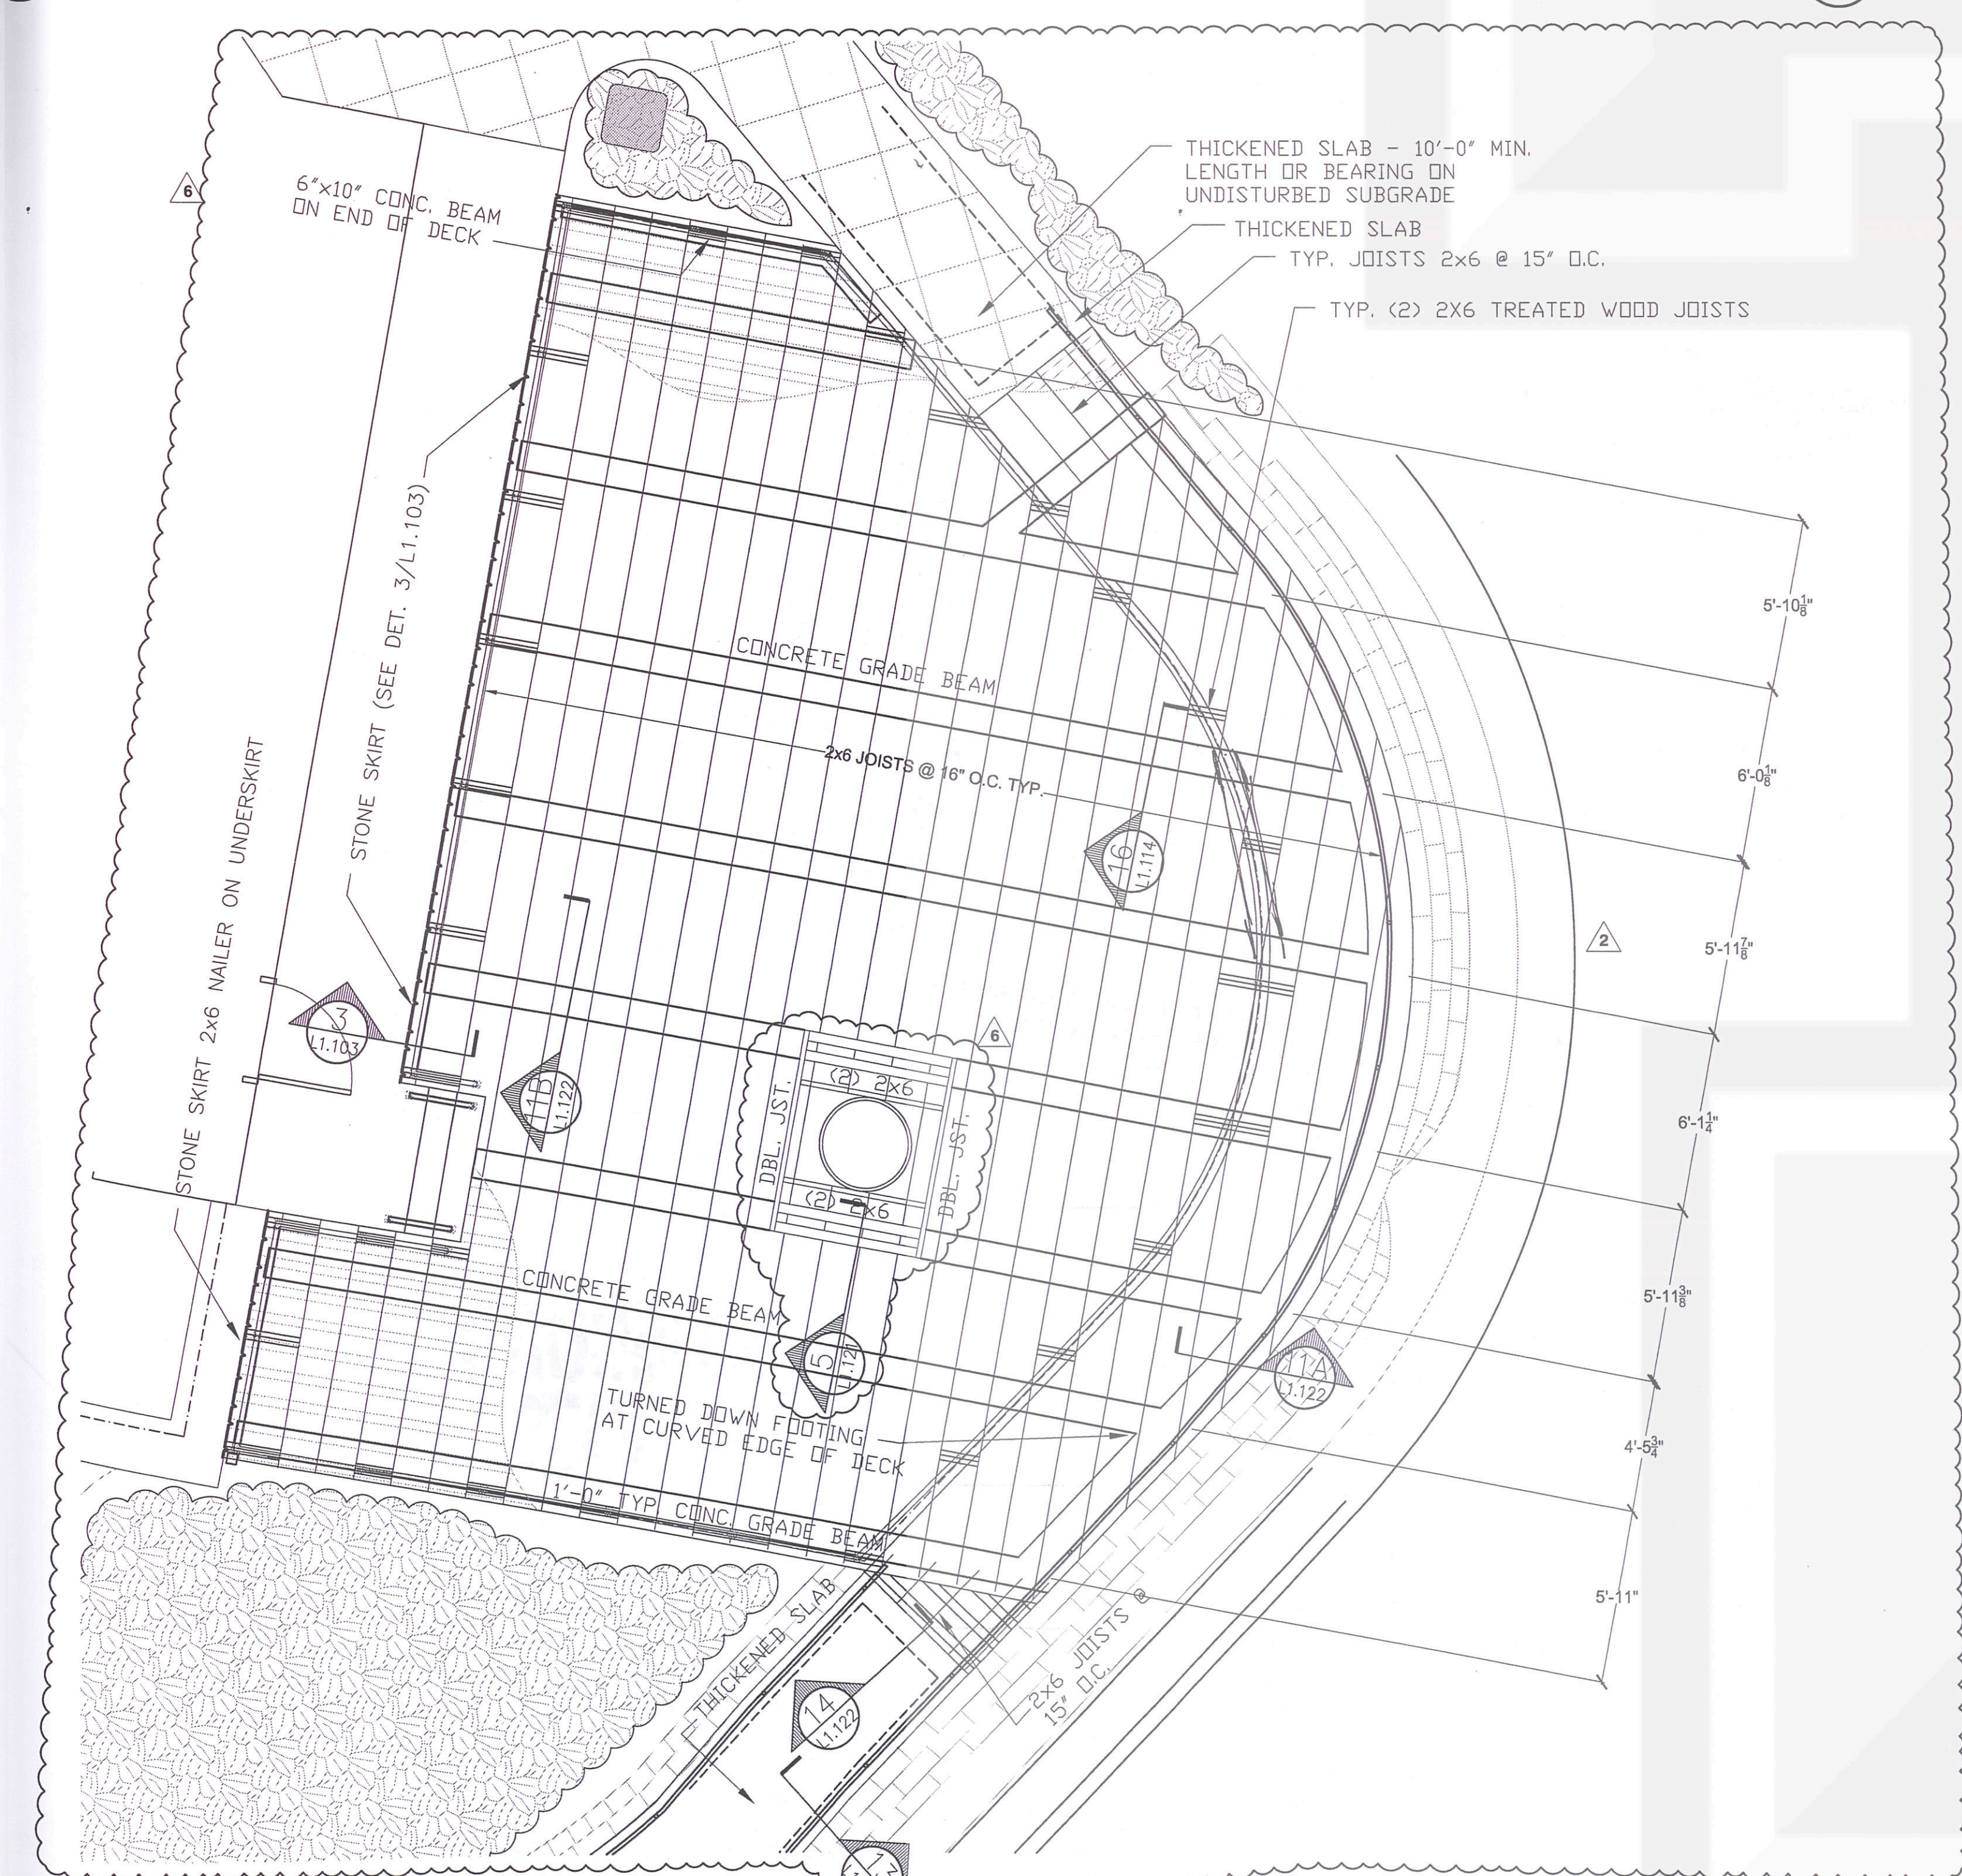


3 TREX DECK FRAMING PLAN - RESTAURANT 1

1/4" = 1'-0"

2 TREX DECK FRAMING PLAN - SHADY GROVE

1/4" = 1'-0"

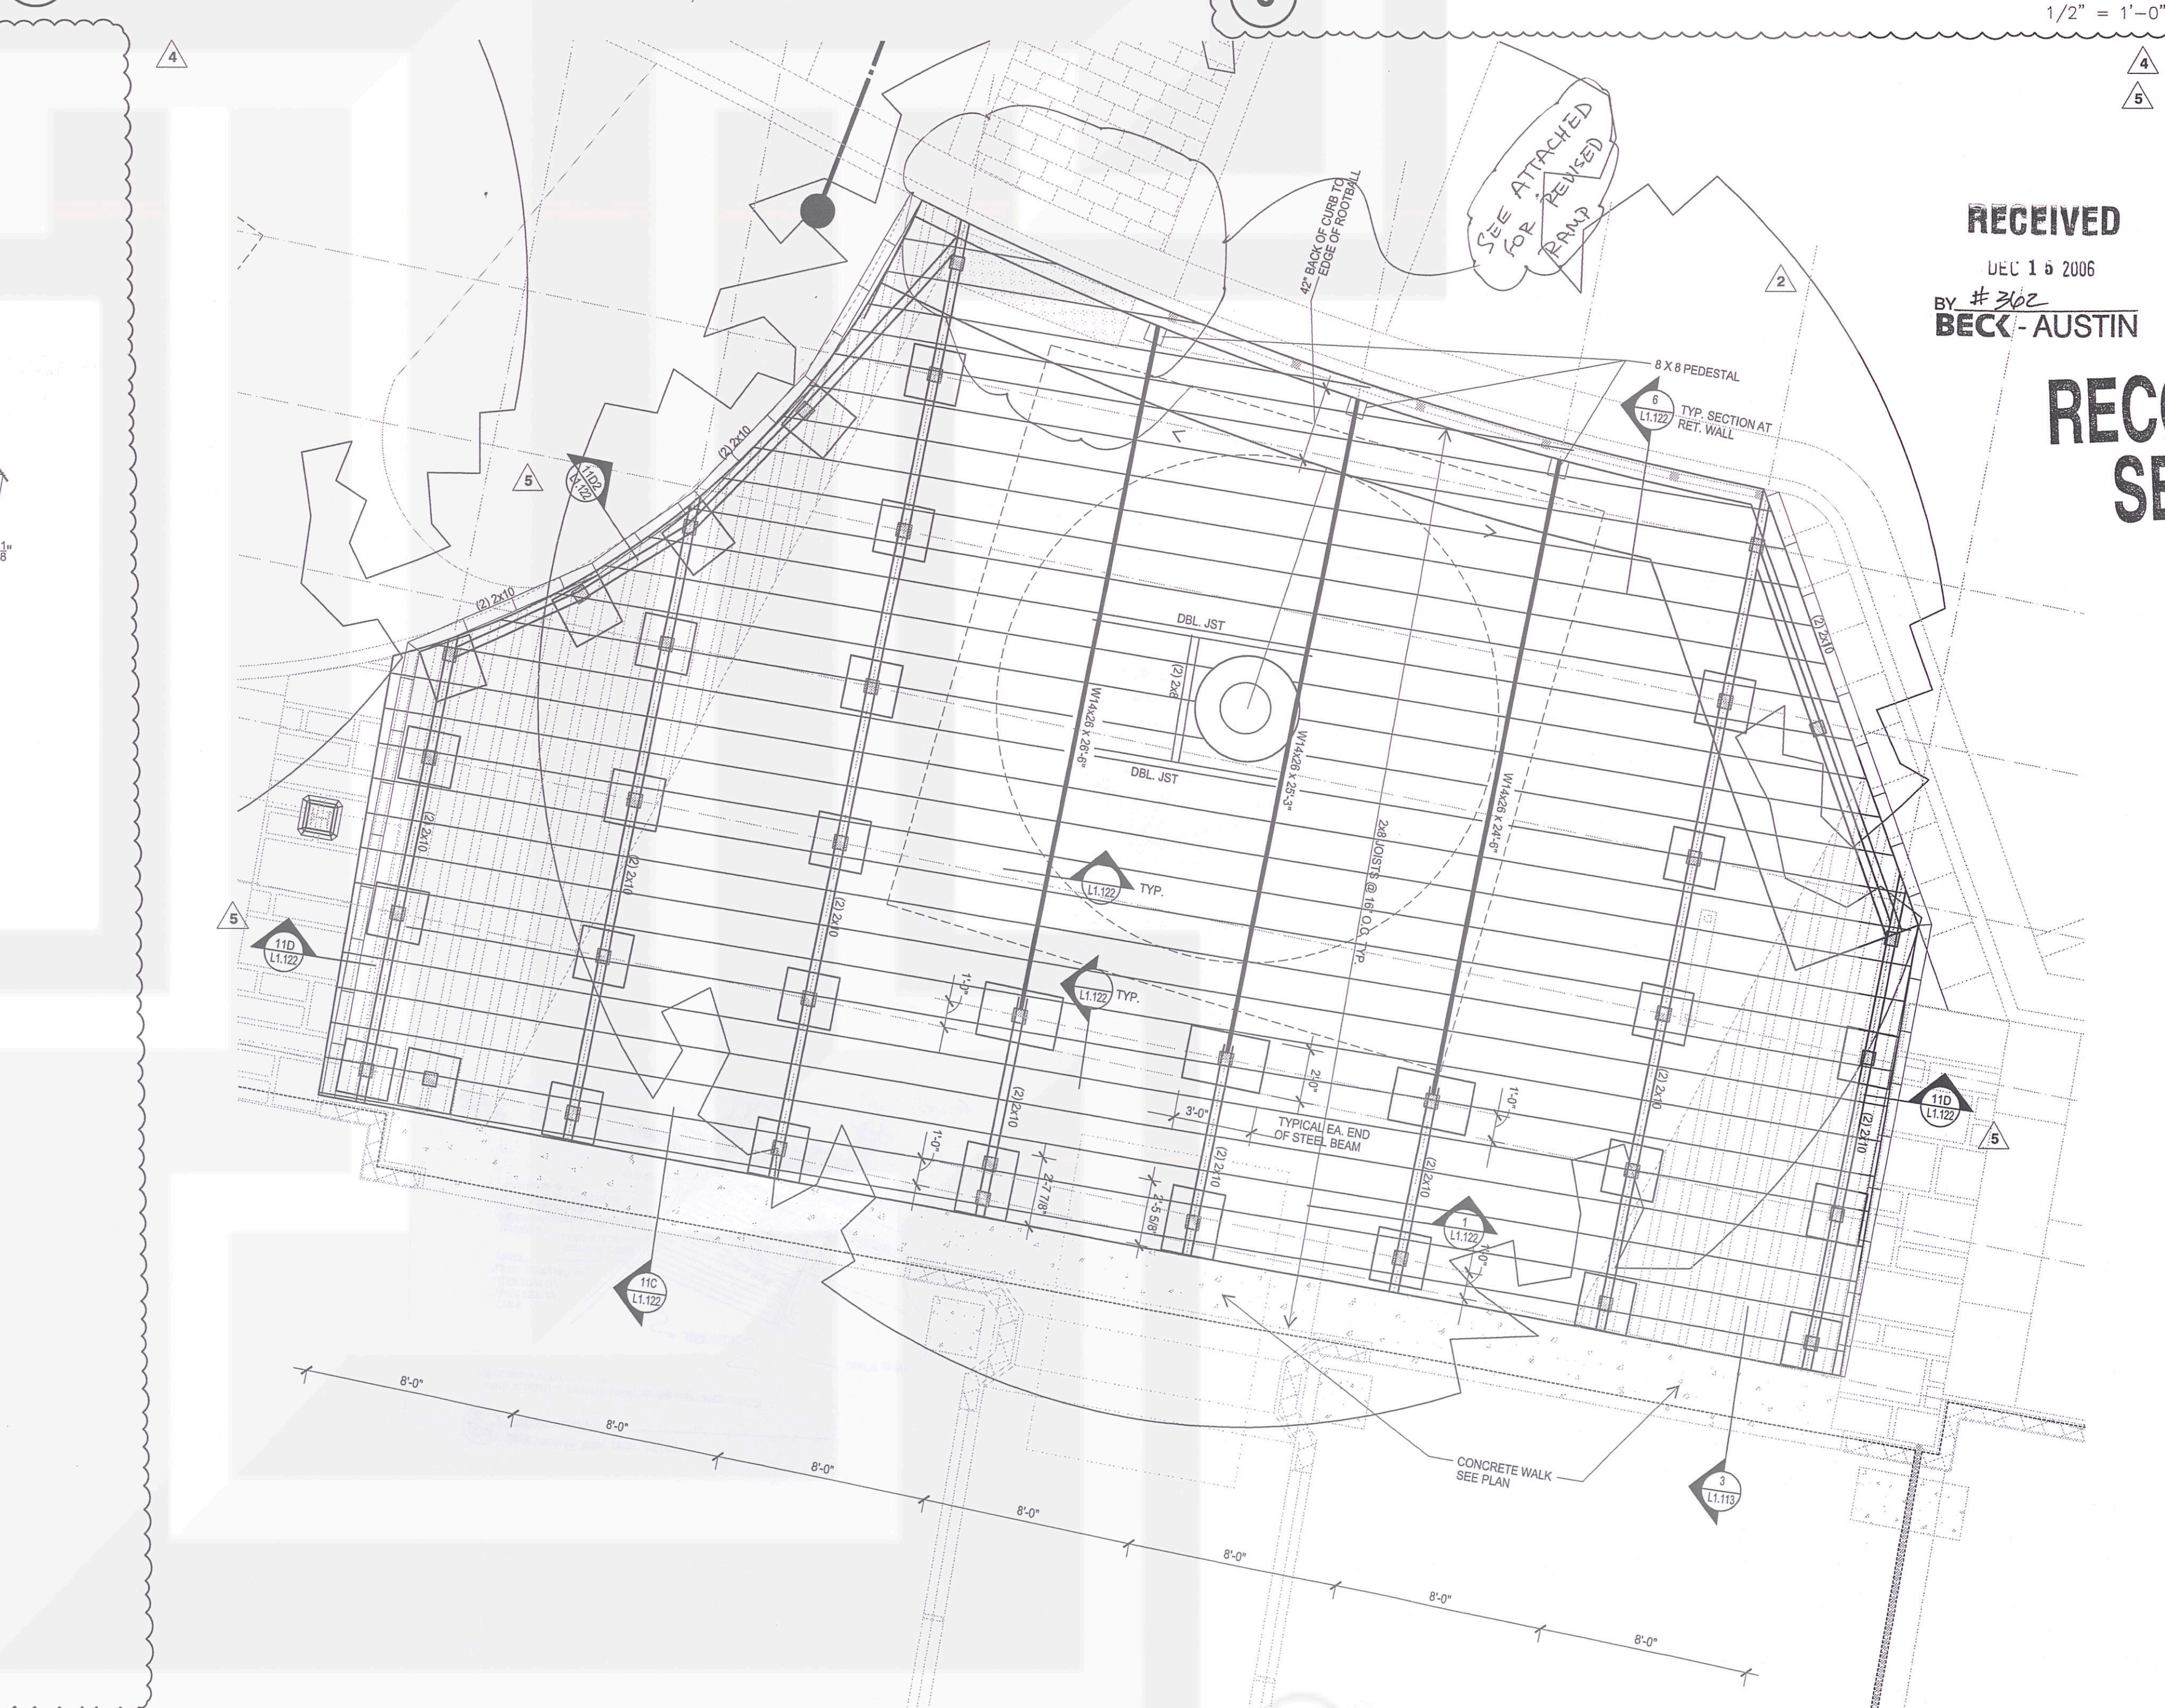


4 TREX DECK FRAMING PLAN - RETAIL L1 & L2

1/4" = 1'-0"

5 PLAN - TYP. DECK AT TREE ROOTS AT REST. #1

1/2" = 1'-0"

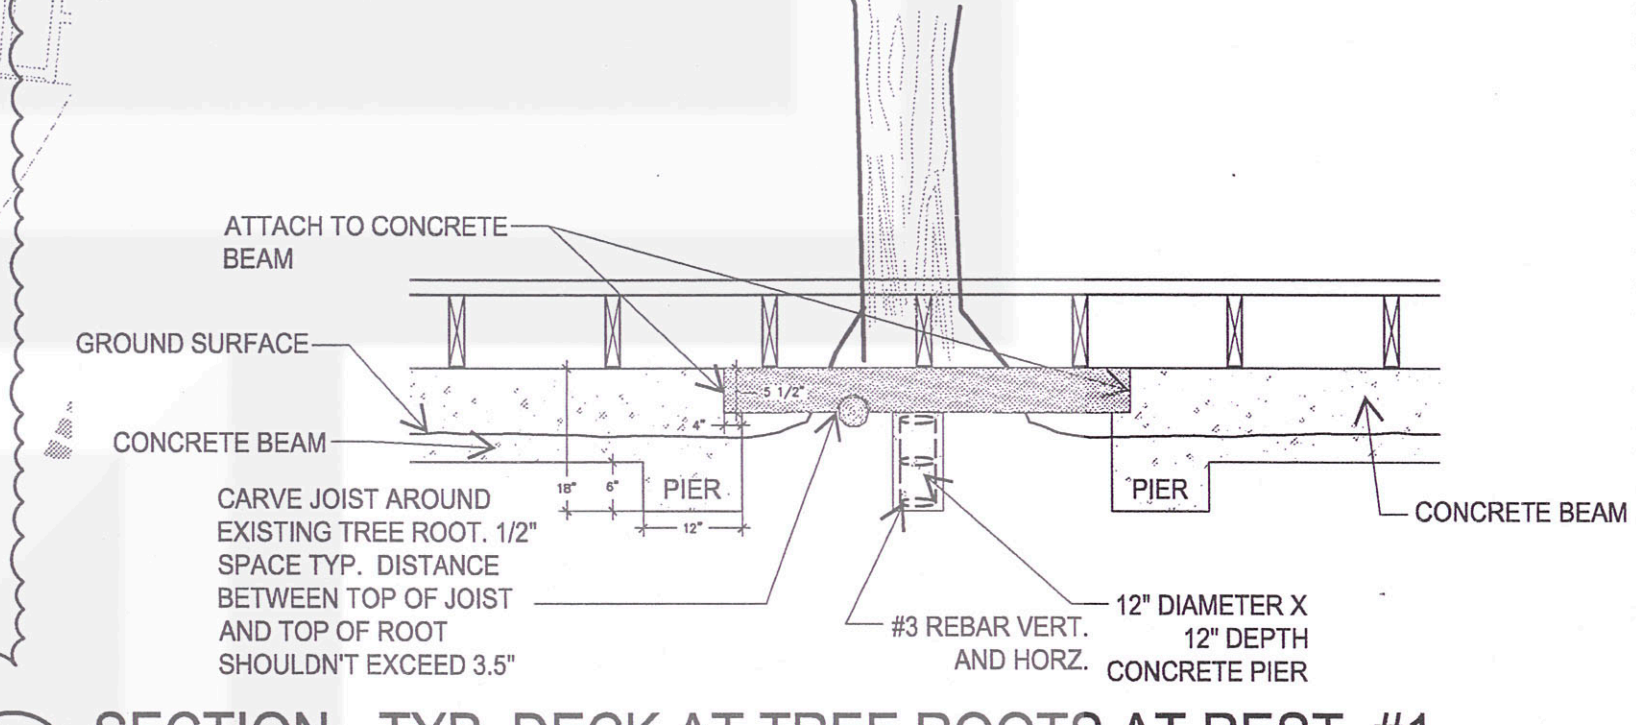

6 SECTION - TYP. DECK AT TREE ROOTS AT REST. #1

1/2" = 1'-0"

REVISIONS		
DELTA	DATE	DESCRIPTION
1	04/24/06	REVISE DETAILS DUE TO VARIOUS CHANGES (OWNER-REQUESTED, CIVIL, ARCHITECTURAL)
2	05/10/06	REVISE DETAILS DUE TO VARIOUS CHANGES (OWNER-REQUESTED, CIVIL, ARCHITECTURAL)
3	08/09/06	REVISE DETAILS DUE TO VARIOUS CHANGES (OWNER-REQUESTED, CIVIL, ARCHITECTURAL)
4	09/27/06	REVISE DETAILS DUE TO VARIOUS CHANGES (OWNER-REQUESTED, CIVIL, ARCHITECTURAL)
5	10/19/06	CLARIFIED DRY STACK RETAINING WALLS AT DECK 1 AND 4, NOTE CALLOUTS
6	11/13/06	ADDED DETAILS FOR DECK STRUCTURE AT REST. #1; MODIFIED 3/L1.121.

A JOINT VENTURE OF:

SIMON **ENDEAVOR**

REAL ESTATE GROUP

J. Robert Anderson, FASLA

landscape architects, austin, texas.

3718 MANCHACA ROAD
AUSTIN, TEXAS 78704
512.440.1049
440-8000 FAX

RECEIVED
DEC 18 2006
BY #262
BECK-AUSTIN

RECORD SET

11/13/06

Project:

the domain
AUSTIN, TEXAS

JPRO ARCHITECTS

31000 Northwestern Suite 100
Farmington Hills Michigan 48334-2585
phone 248.737.0000 fax 248.737.9161

SHEET TITLE:
DECK DETAILS

Sheet No.
L1.121