
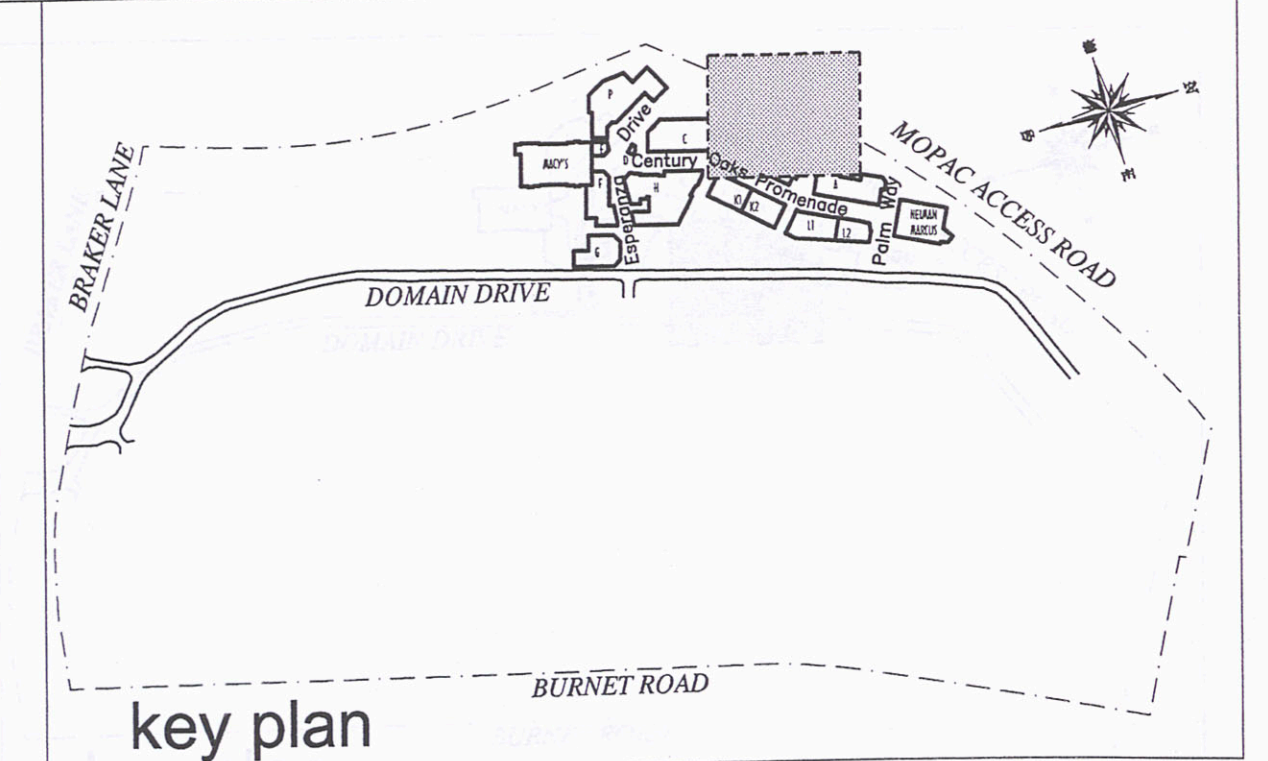


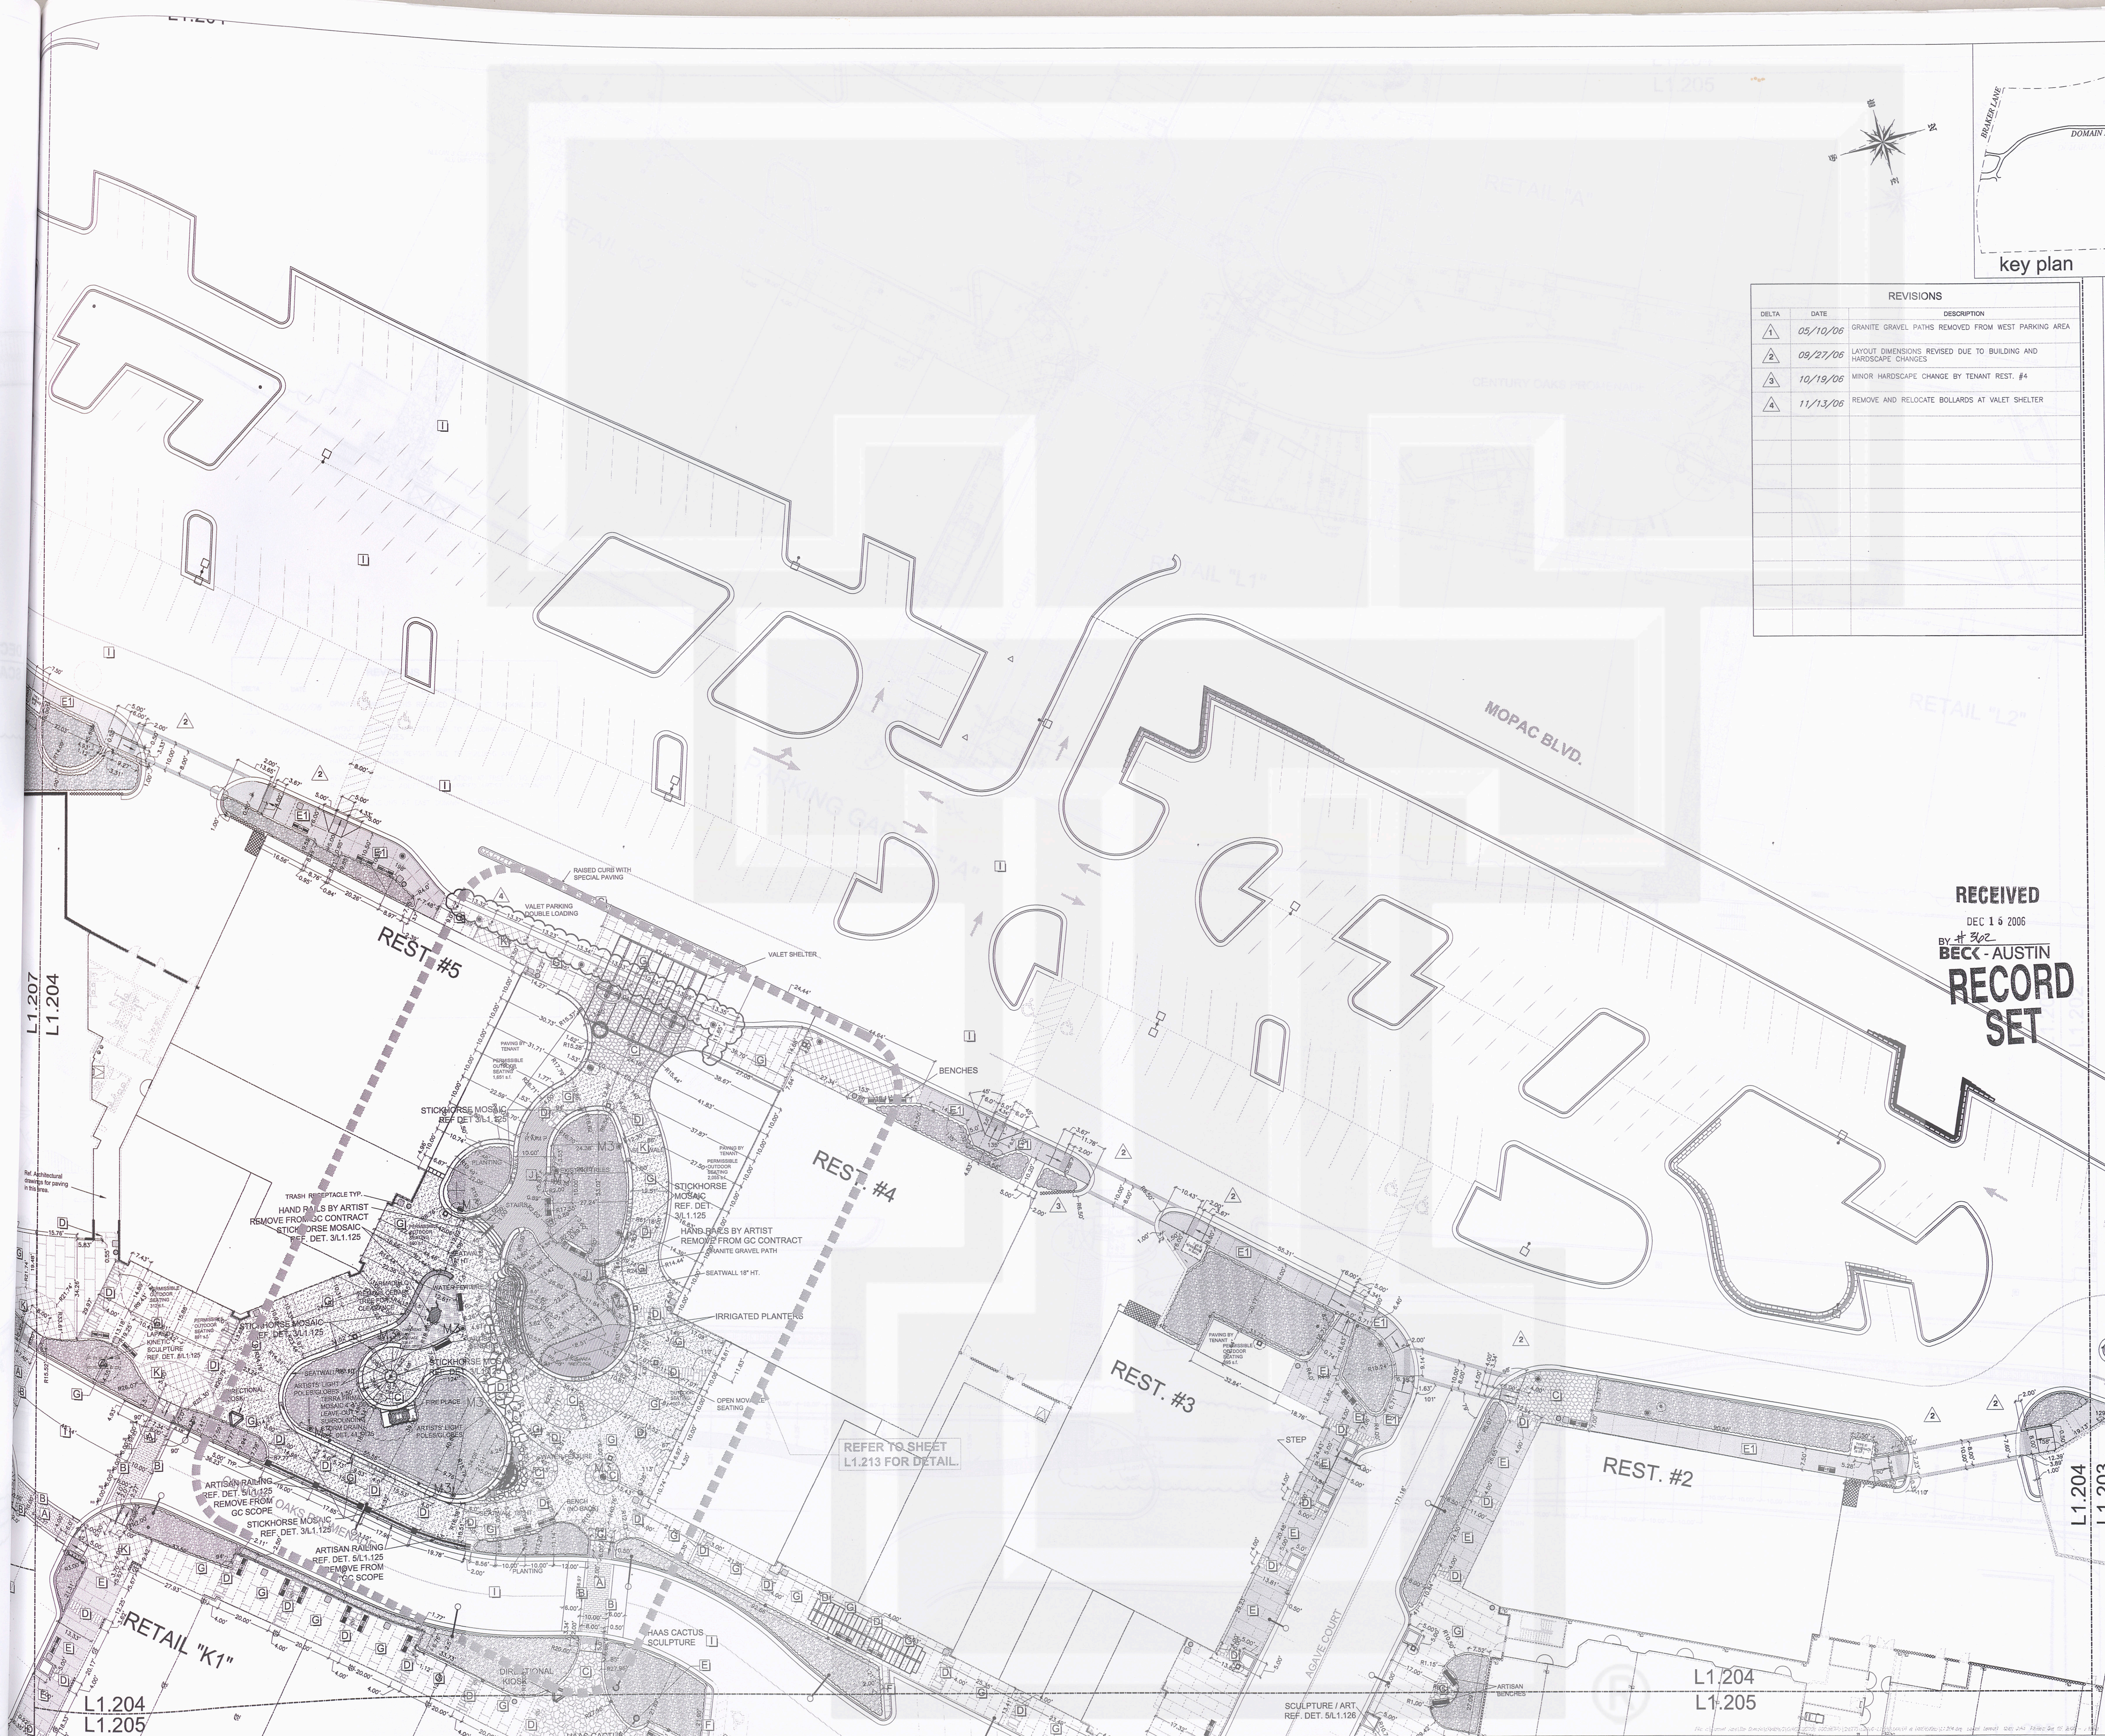


REVISIONS		
DELTA	DATE	DESCRIPTION
1	05/10/06	GRANITE GRAVEL PATHS REMOVED FROM WEST PARKING AREA
2	09/27/06	LAYOUT DIMENSIONS REVISED DUE TO BUILDING AND HARDSCAPE CHANGES
3	10/19/06	MINOR HARDSCAPE CHANGE BY TENANT REST. #4
4	11/13/06	REMOVE AND RELOCATE BOLLARDS AT VALET SHELTER

RECEIVED
DEC 16 2006
By: *[Signature]*
BECK - AUSTIN
RECORD SET

A JOINT VENTURE OF:

SIMON | **ENDEAVOR**
REAL ESTATE GROUP

J. Robert Anderson, FASLA
landscape architects • austin, texas •
3719 MANCHACA ROAD
AUSTIN, TEXAS 78704
512.440.1049
440-8000 FAX

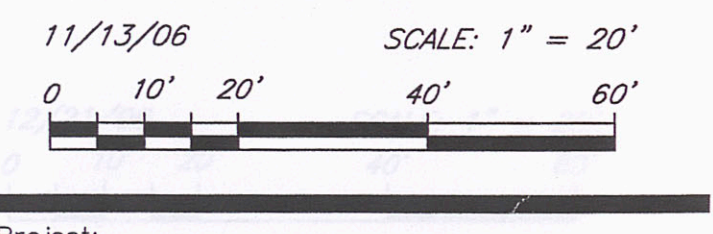

Project:

the domain
AUSTIN, TEXAS

JPR ARCHITECTS
31000 Northwestern Suite 100
Farmingington Hills Michigan 48334-2585
phone 248 737 0180 fax 248 737 9161

SHEET TITLE:
LAYOUT & DIMENSIONS PLAN
Sheet No.
L1.204