


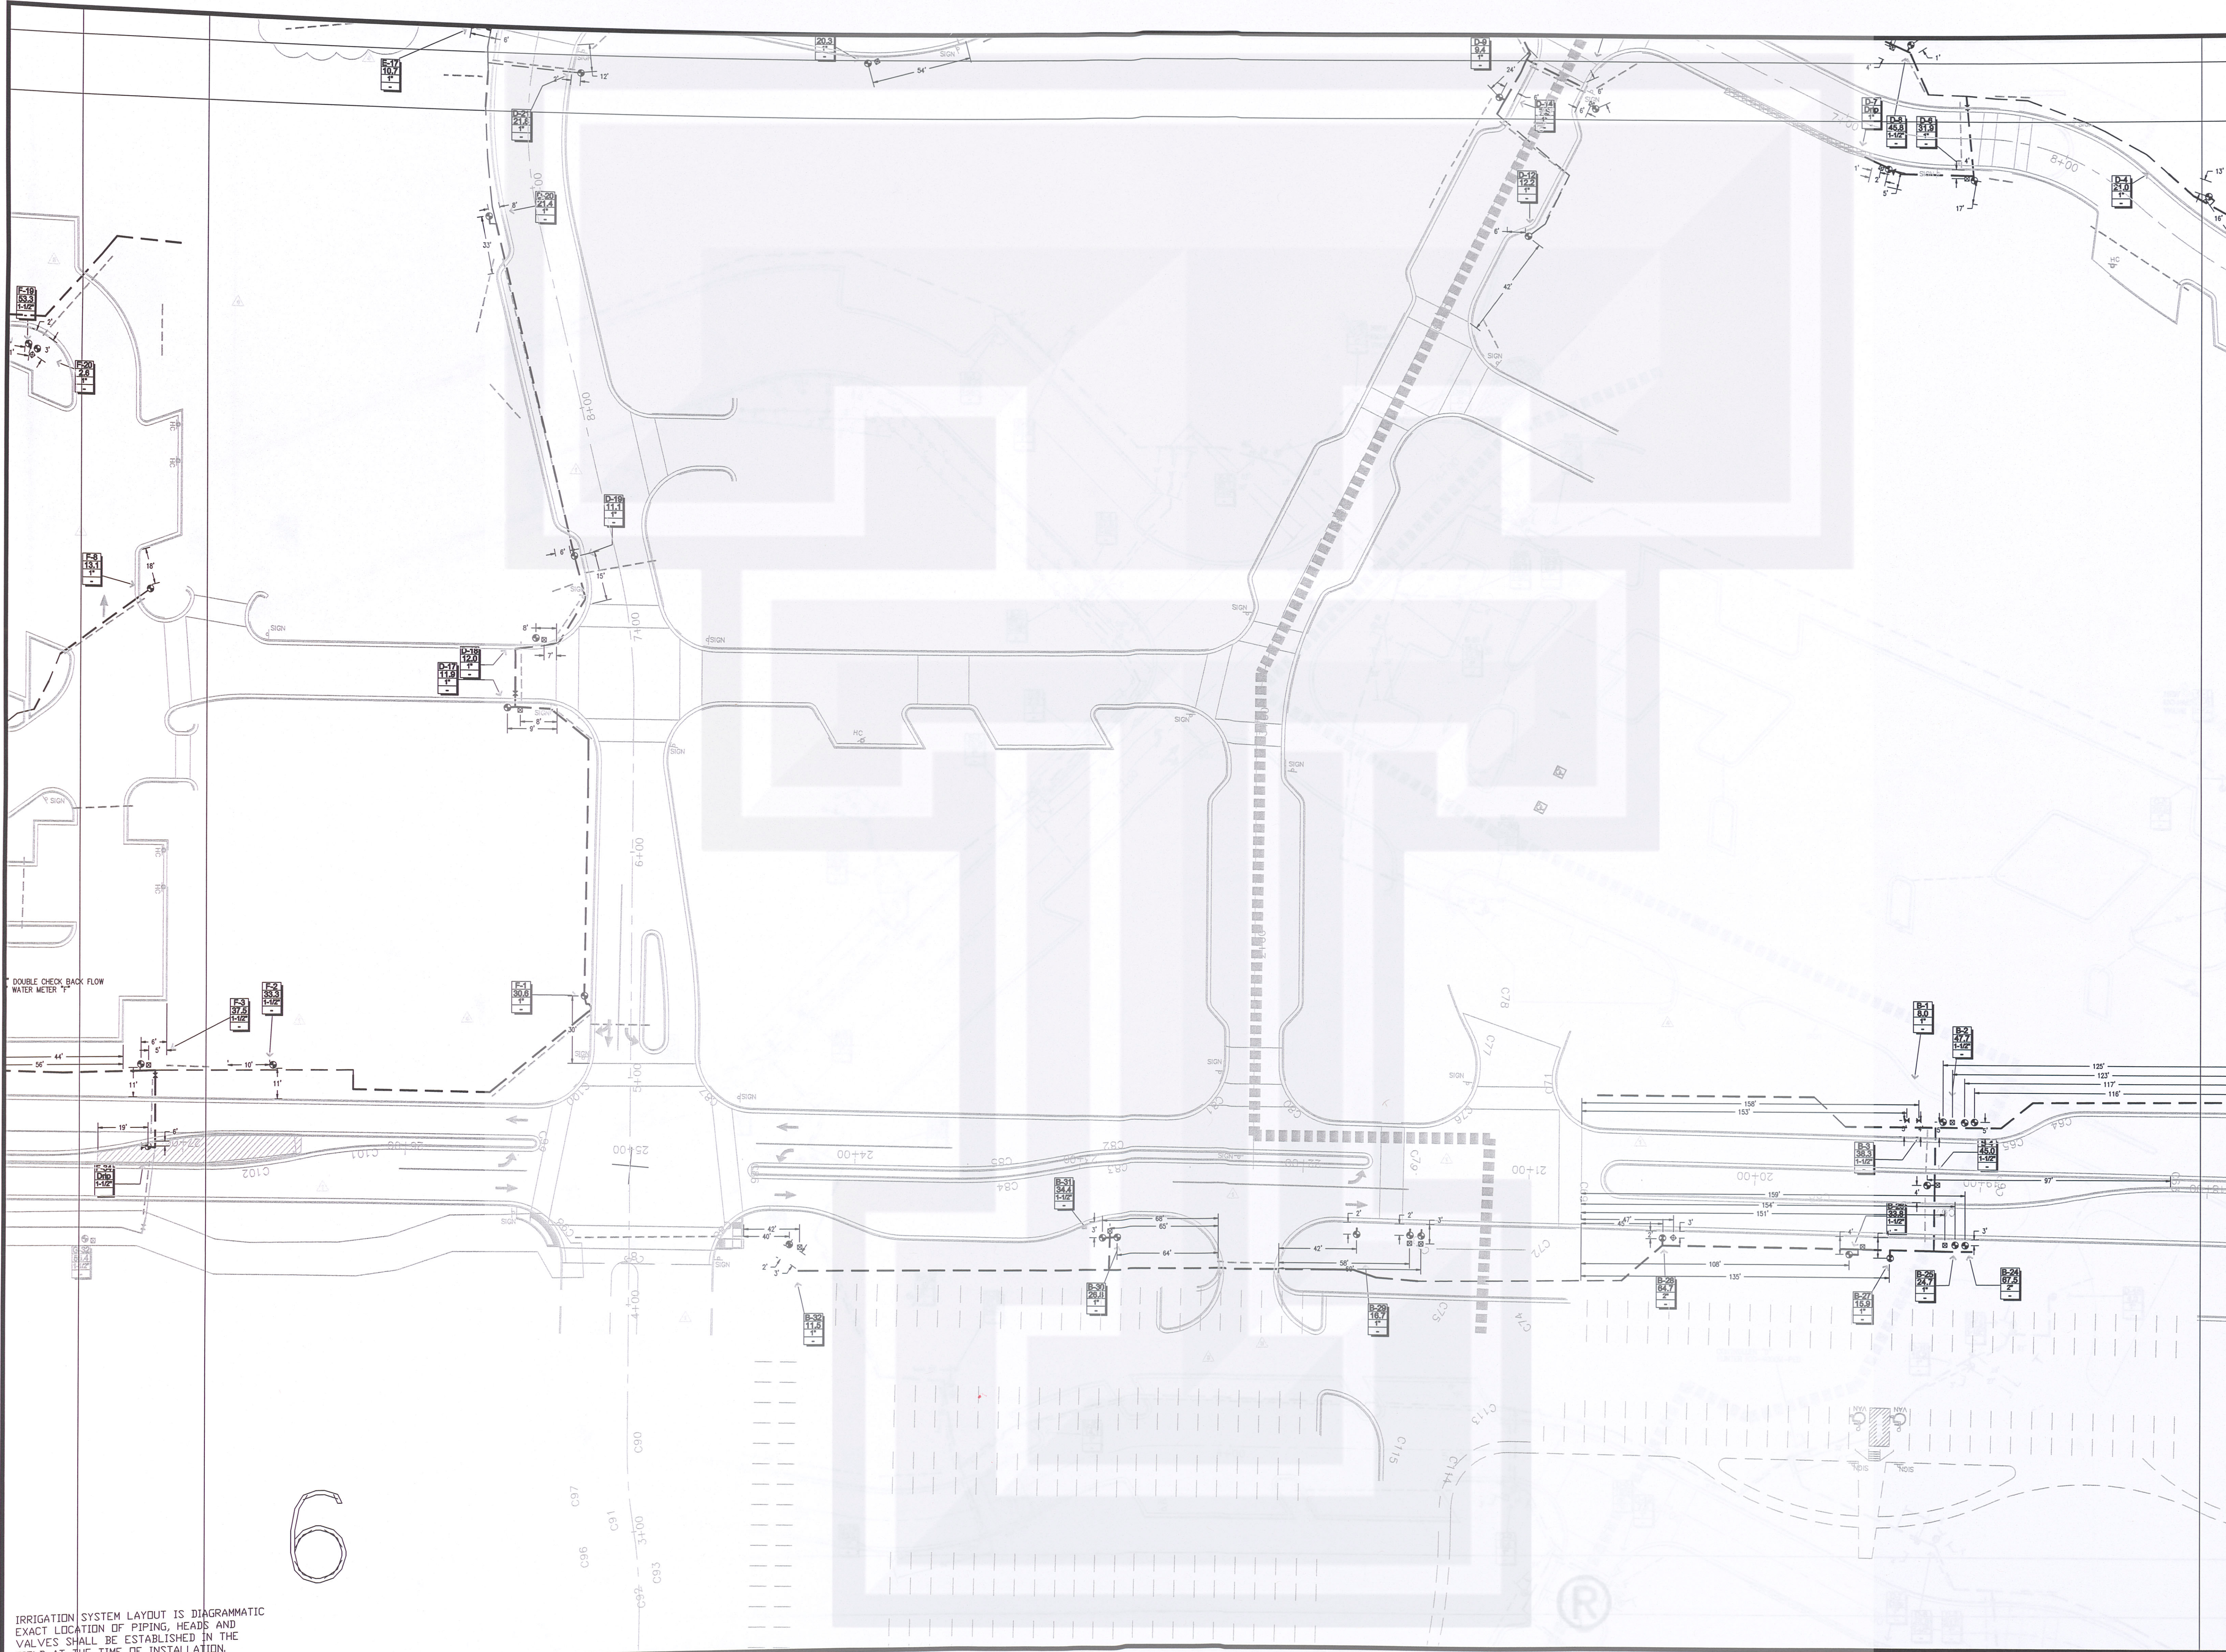

 PHOENIX IRRIGATION	AUSTIN, TX (512) 282-7394 SAN ANTONIO, TX (210) 496-5185	DATE: 06/15/07 SCALE: 1"=30' PAGE 6 OF 10	PROJECT: The Domain AUSTIN, TEXAS
	AS-BUILT		