
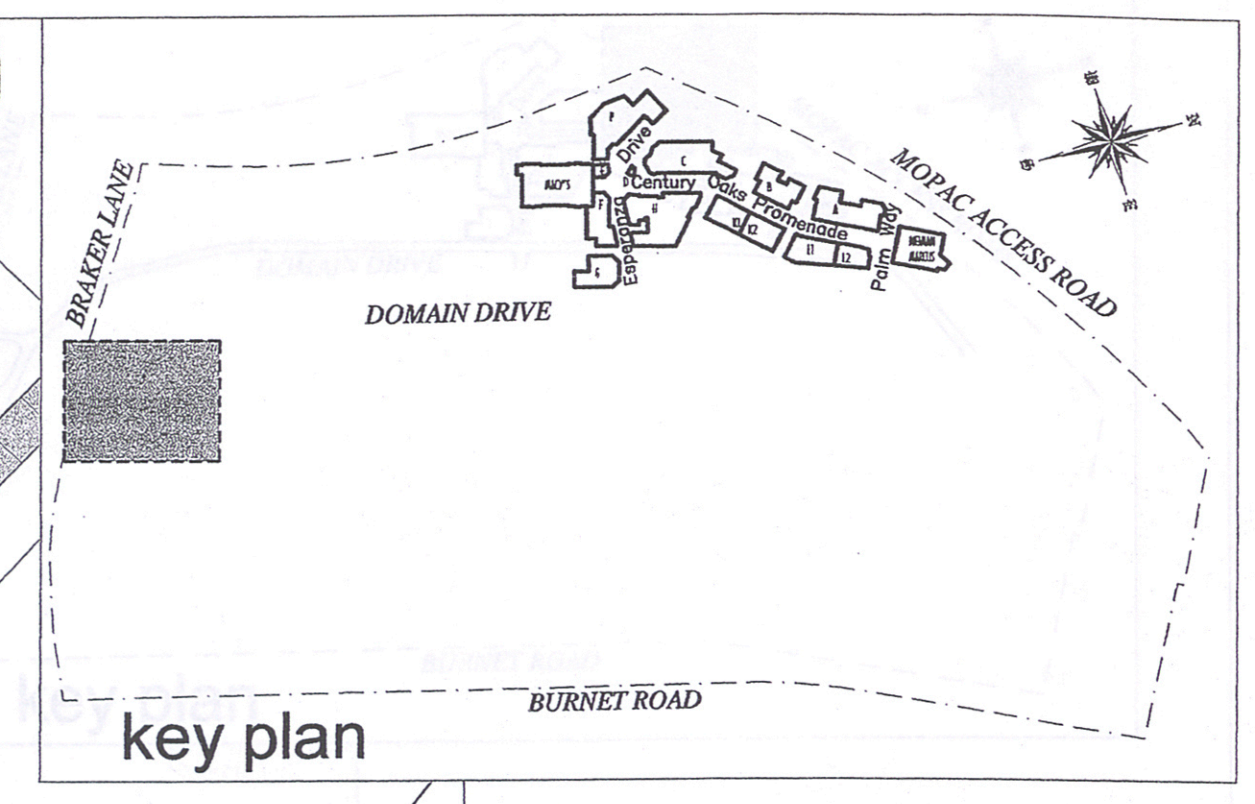


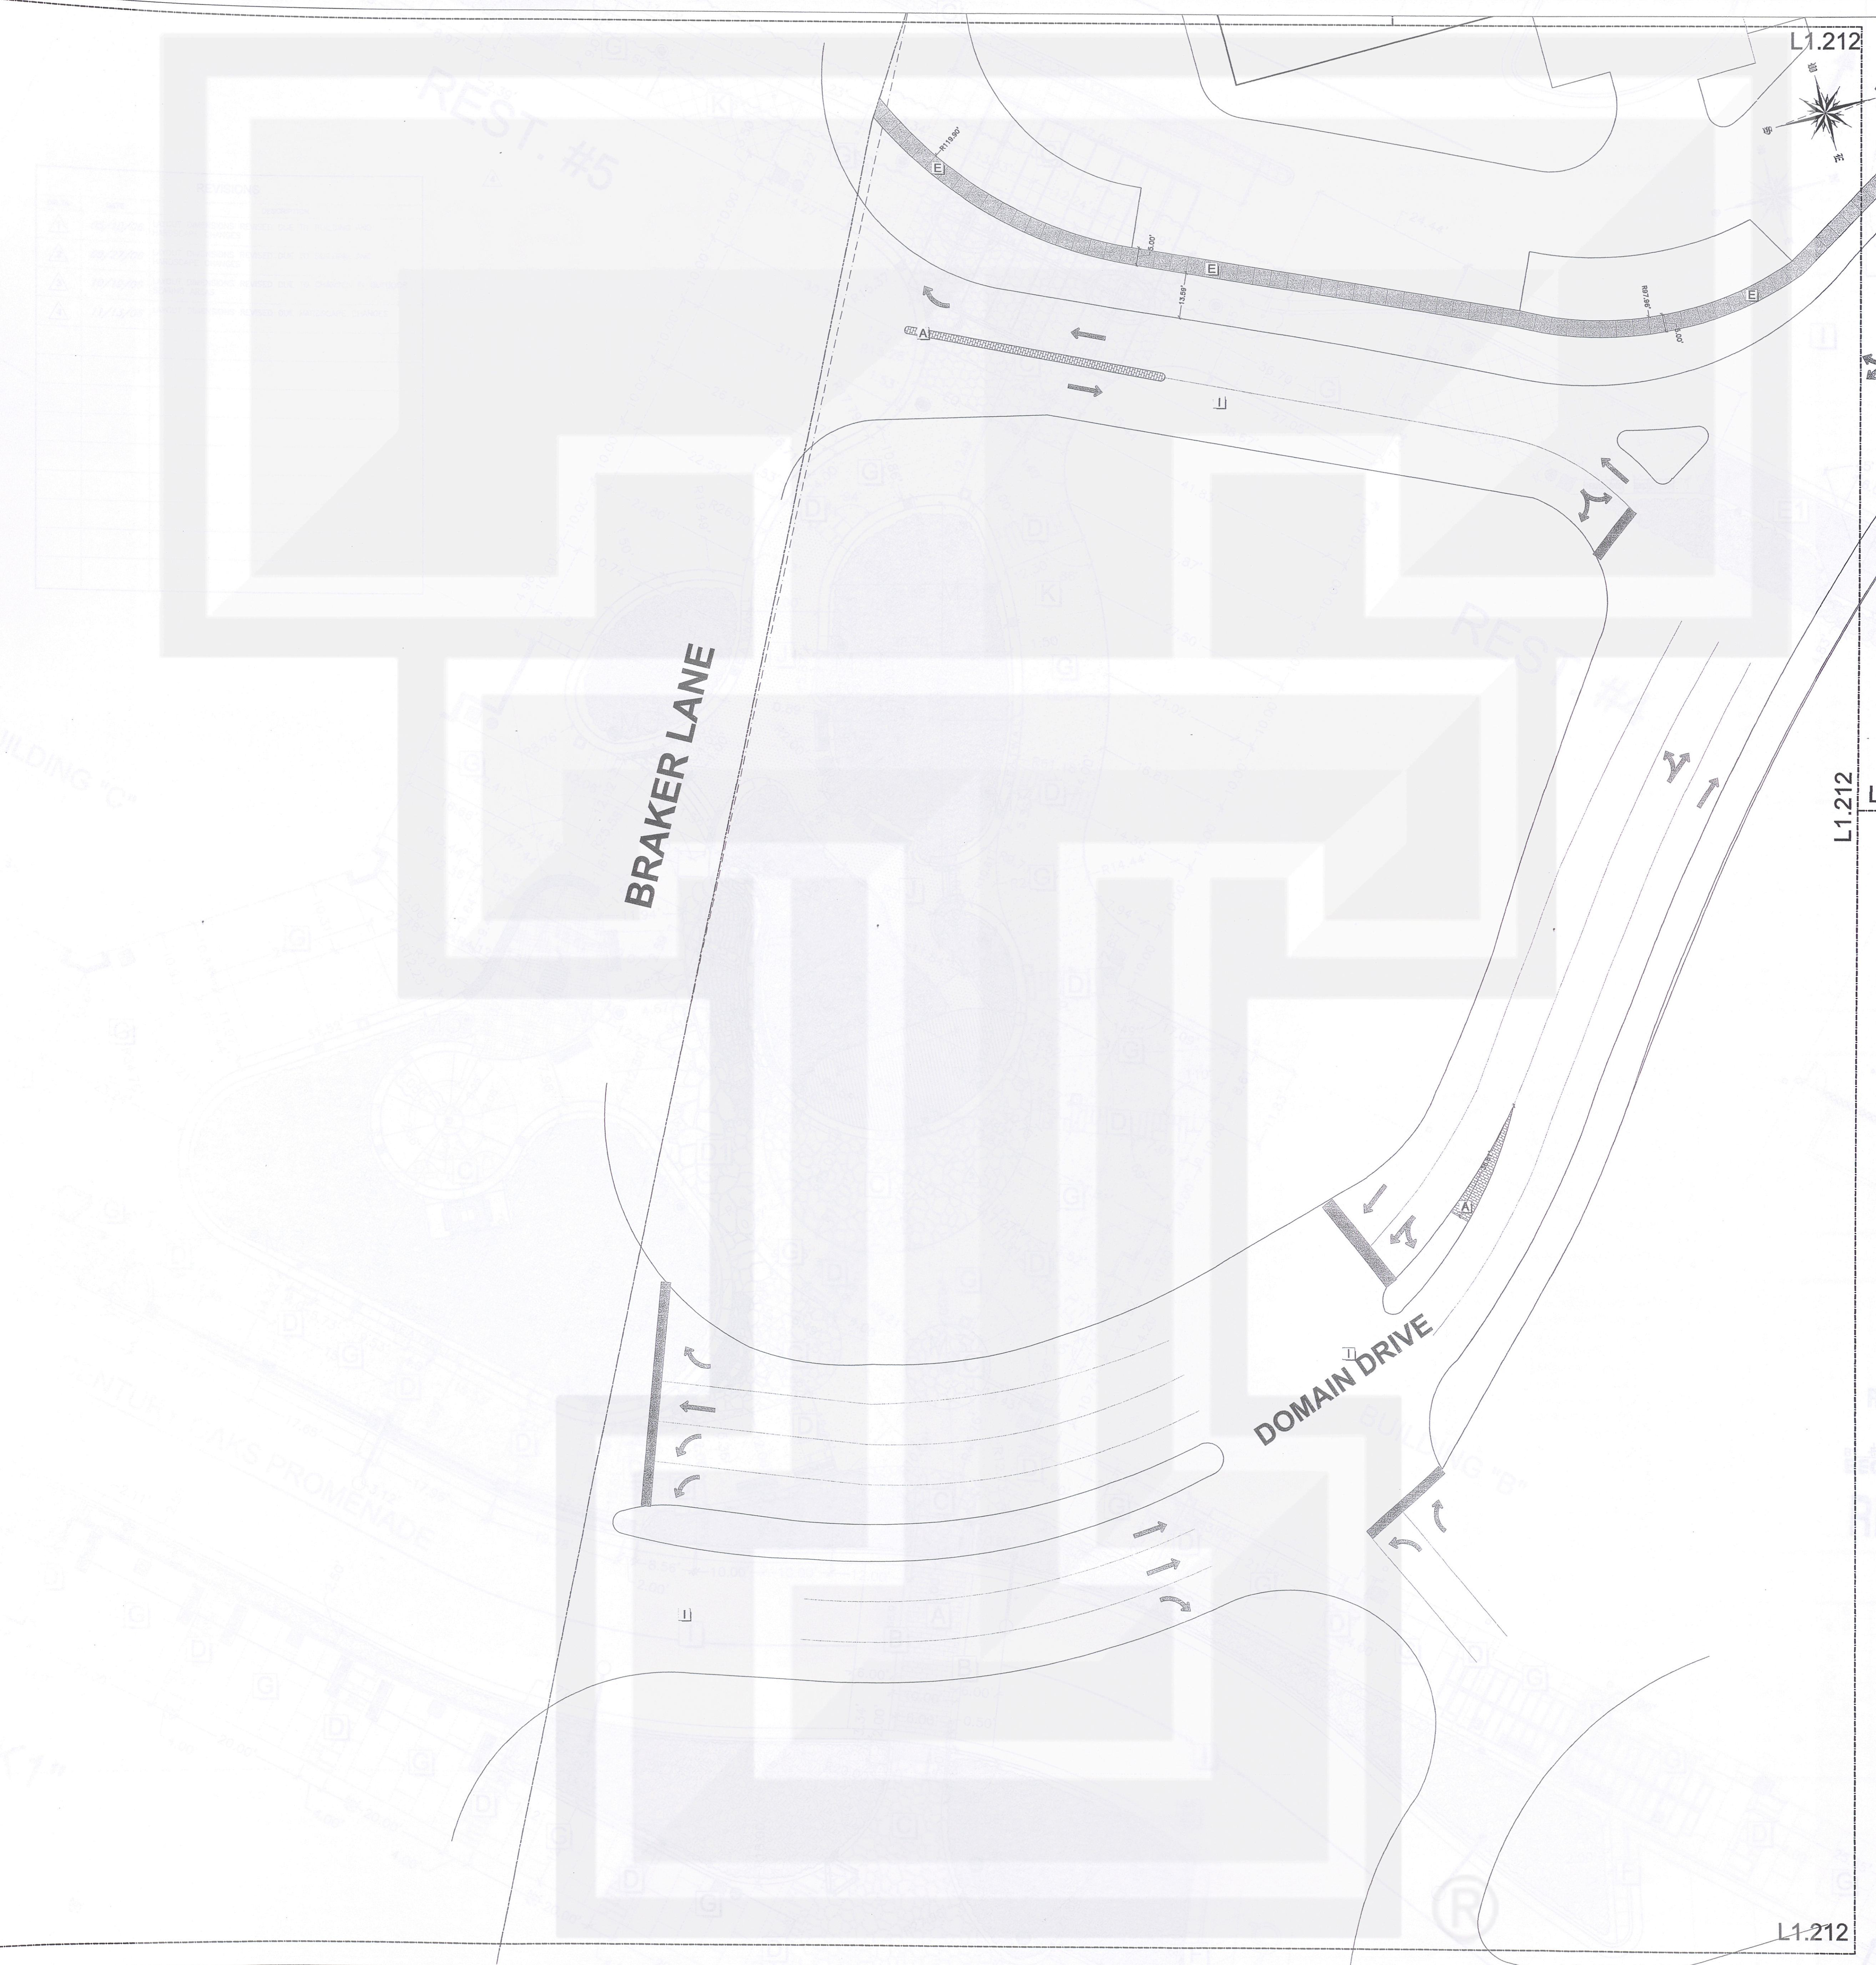

key plan

BRAKER LANE

DOMAIN DRIVE

L1.212

L1.211

L1.212

A JOINT VENTURE OF:
SIMON
ENDEAVOR
REAL ESTATE GROUP

J. Robert Anderson, FASLA
landscape architects . austin, texas .
3718 MANCHACA ROAD
AUSTIN, TEXAS 78704
512.440.1049
440-8000 FAX



02/10/06 SCALE: 1" = 20'
0 10' 20' 40' 60'

Project:

the domain
AUSTIN, TEXAS

RECEIVED
FEB 15 2006
BY
BECK - AUSTIN
RECORD SET
JPRA ARCHITECTS
31000 Northwestern Suite 100
Farmington Hills Michigan 48334-2585
phone 248 737 0100 fax 248 737 9161

SHEET TITLE:
LAYOUT & DIMENSIONS PLAN
Sheet No.
L1.212