


IRRIGATION SYSTEM LAYOUT IS DIAGRAMMATIC
EXACT LOCATION OF PIPING, HEADS AND
VALVES SHALL BE ESTABLISHED IN THE
FIELD AT THE TIME OF INSTALLATION.

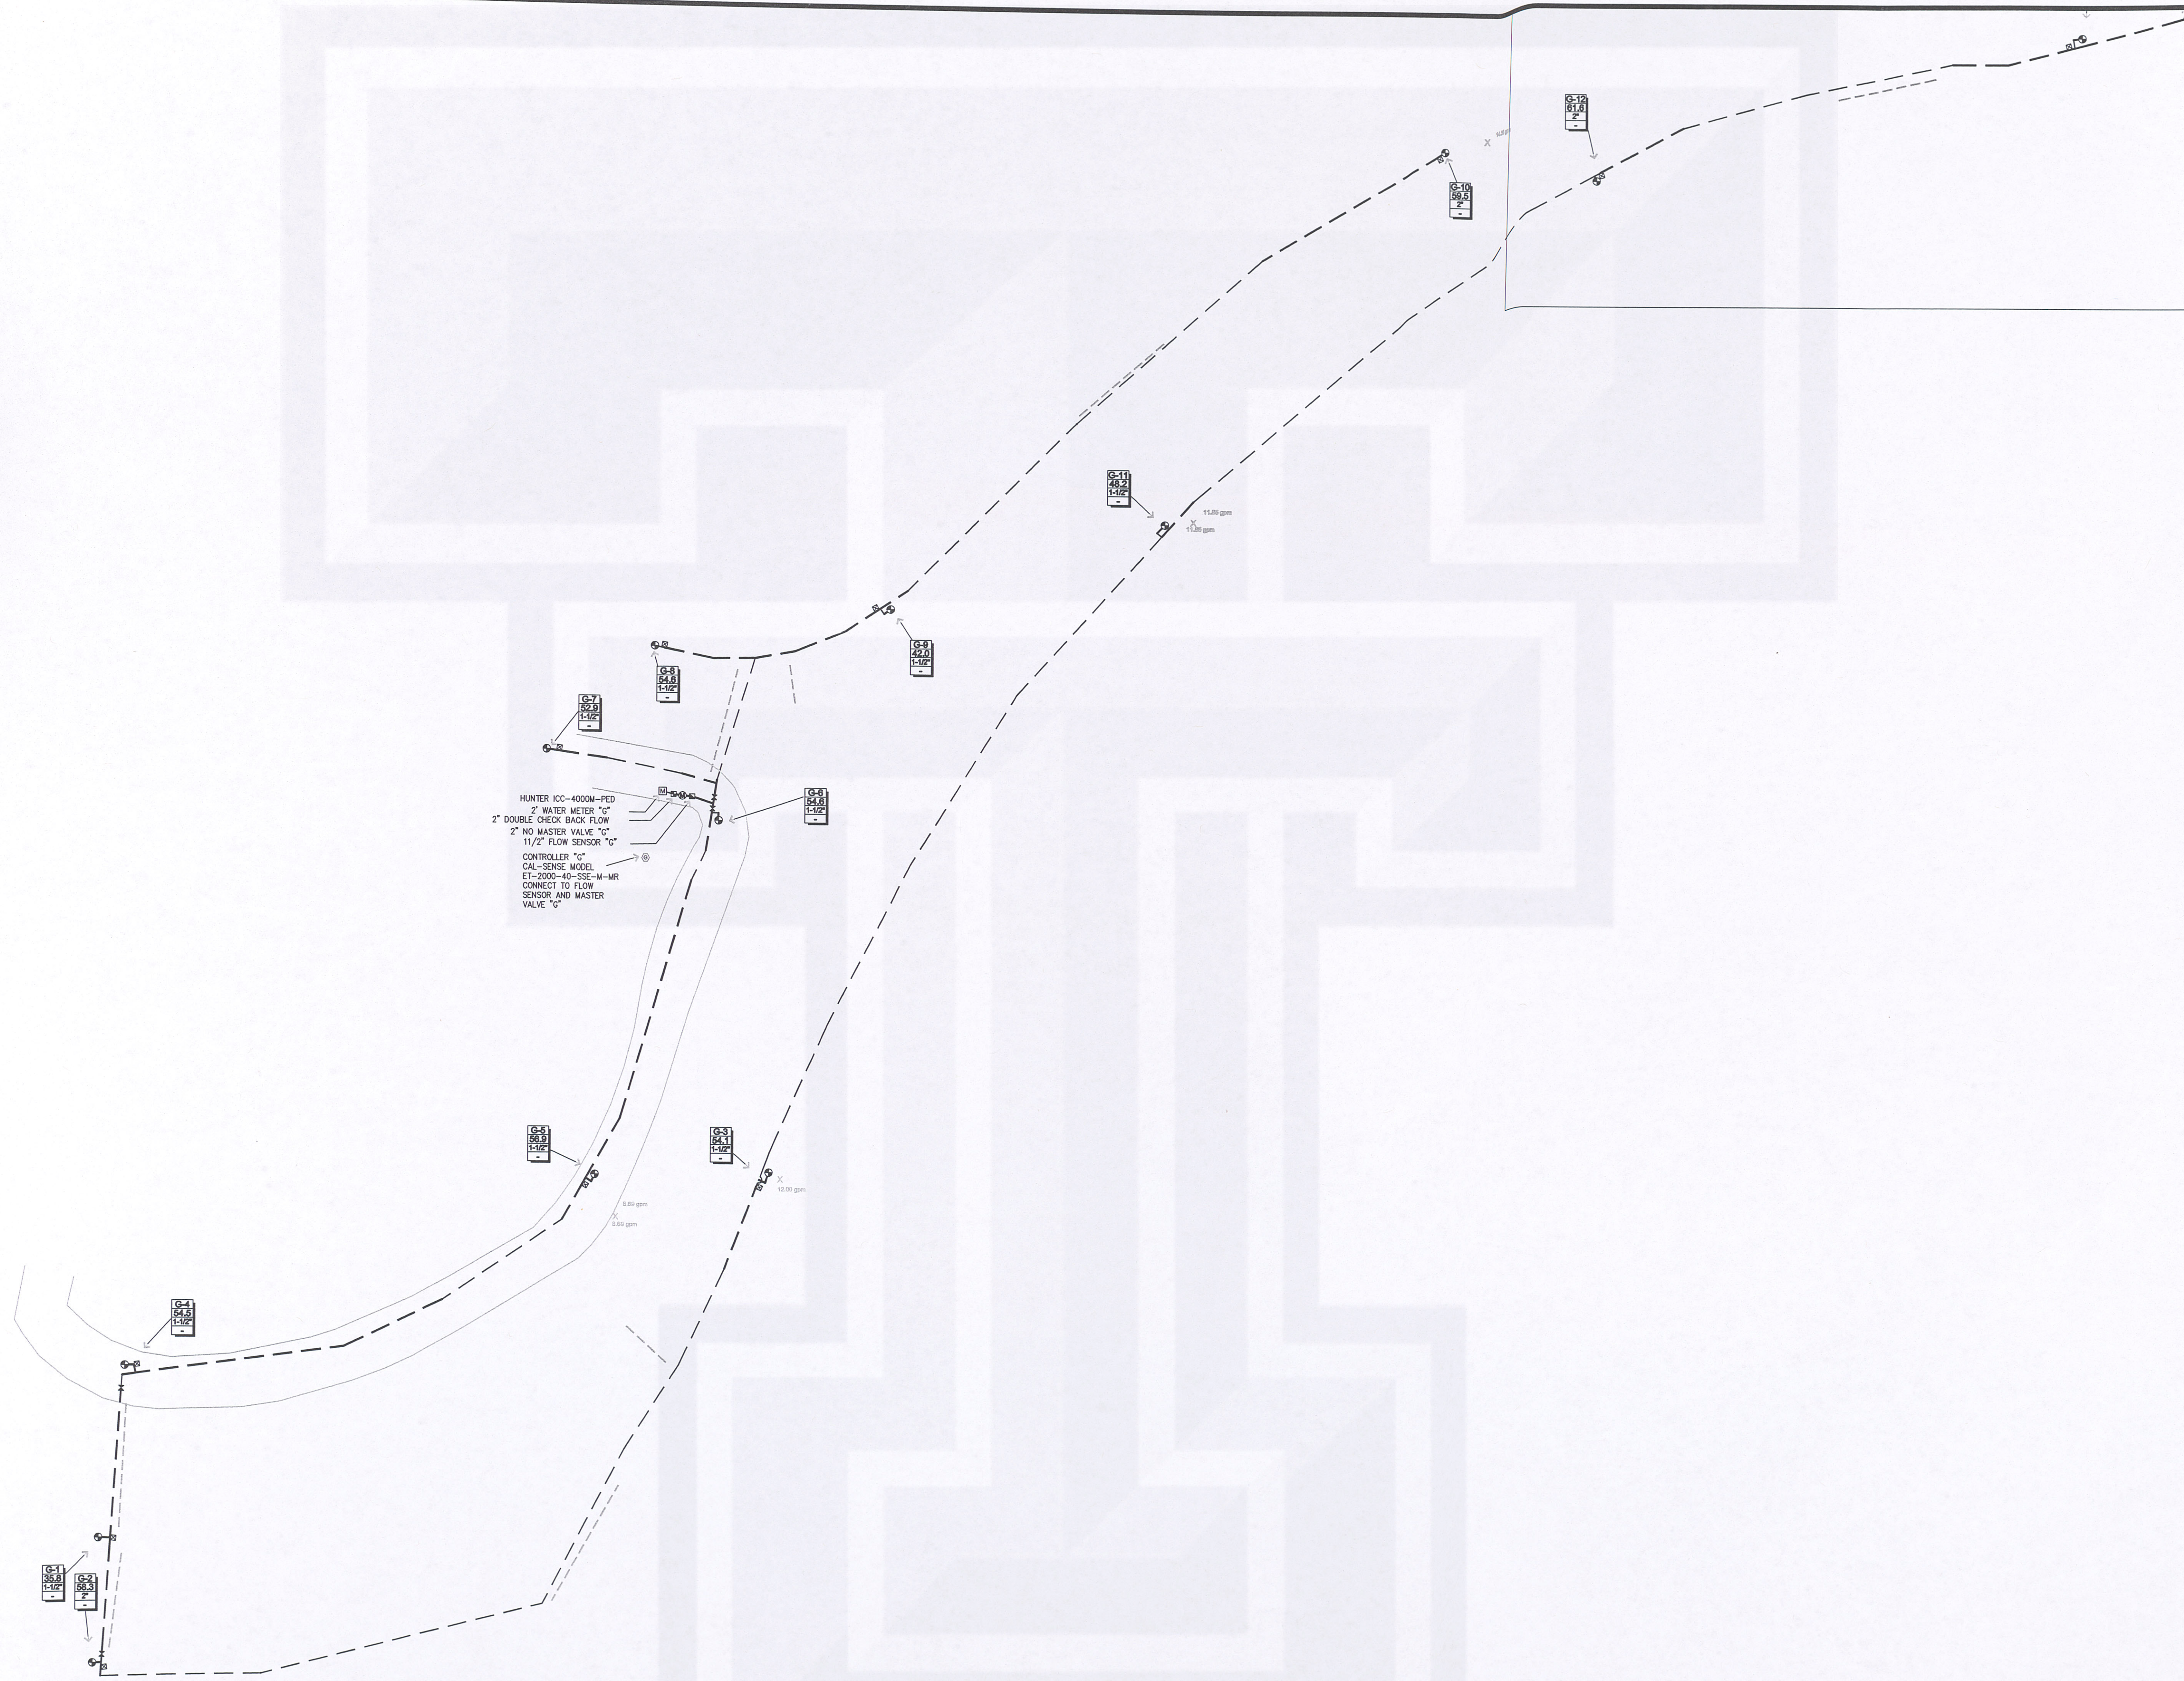

AUSTIN, TX
(512) 282-7394
SAN ANTONIO, TX
(210) 496-5185

DATE: 06/15/07

SCALE: 1"=30'0"

PAGE 1 OF 10

AS-BUILT

U i n o d e T

AUSTIN, TEXAS