



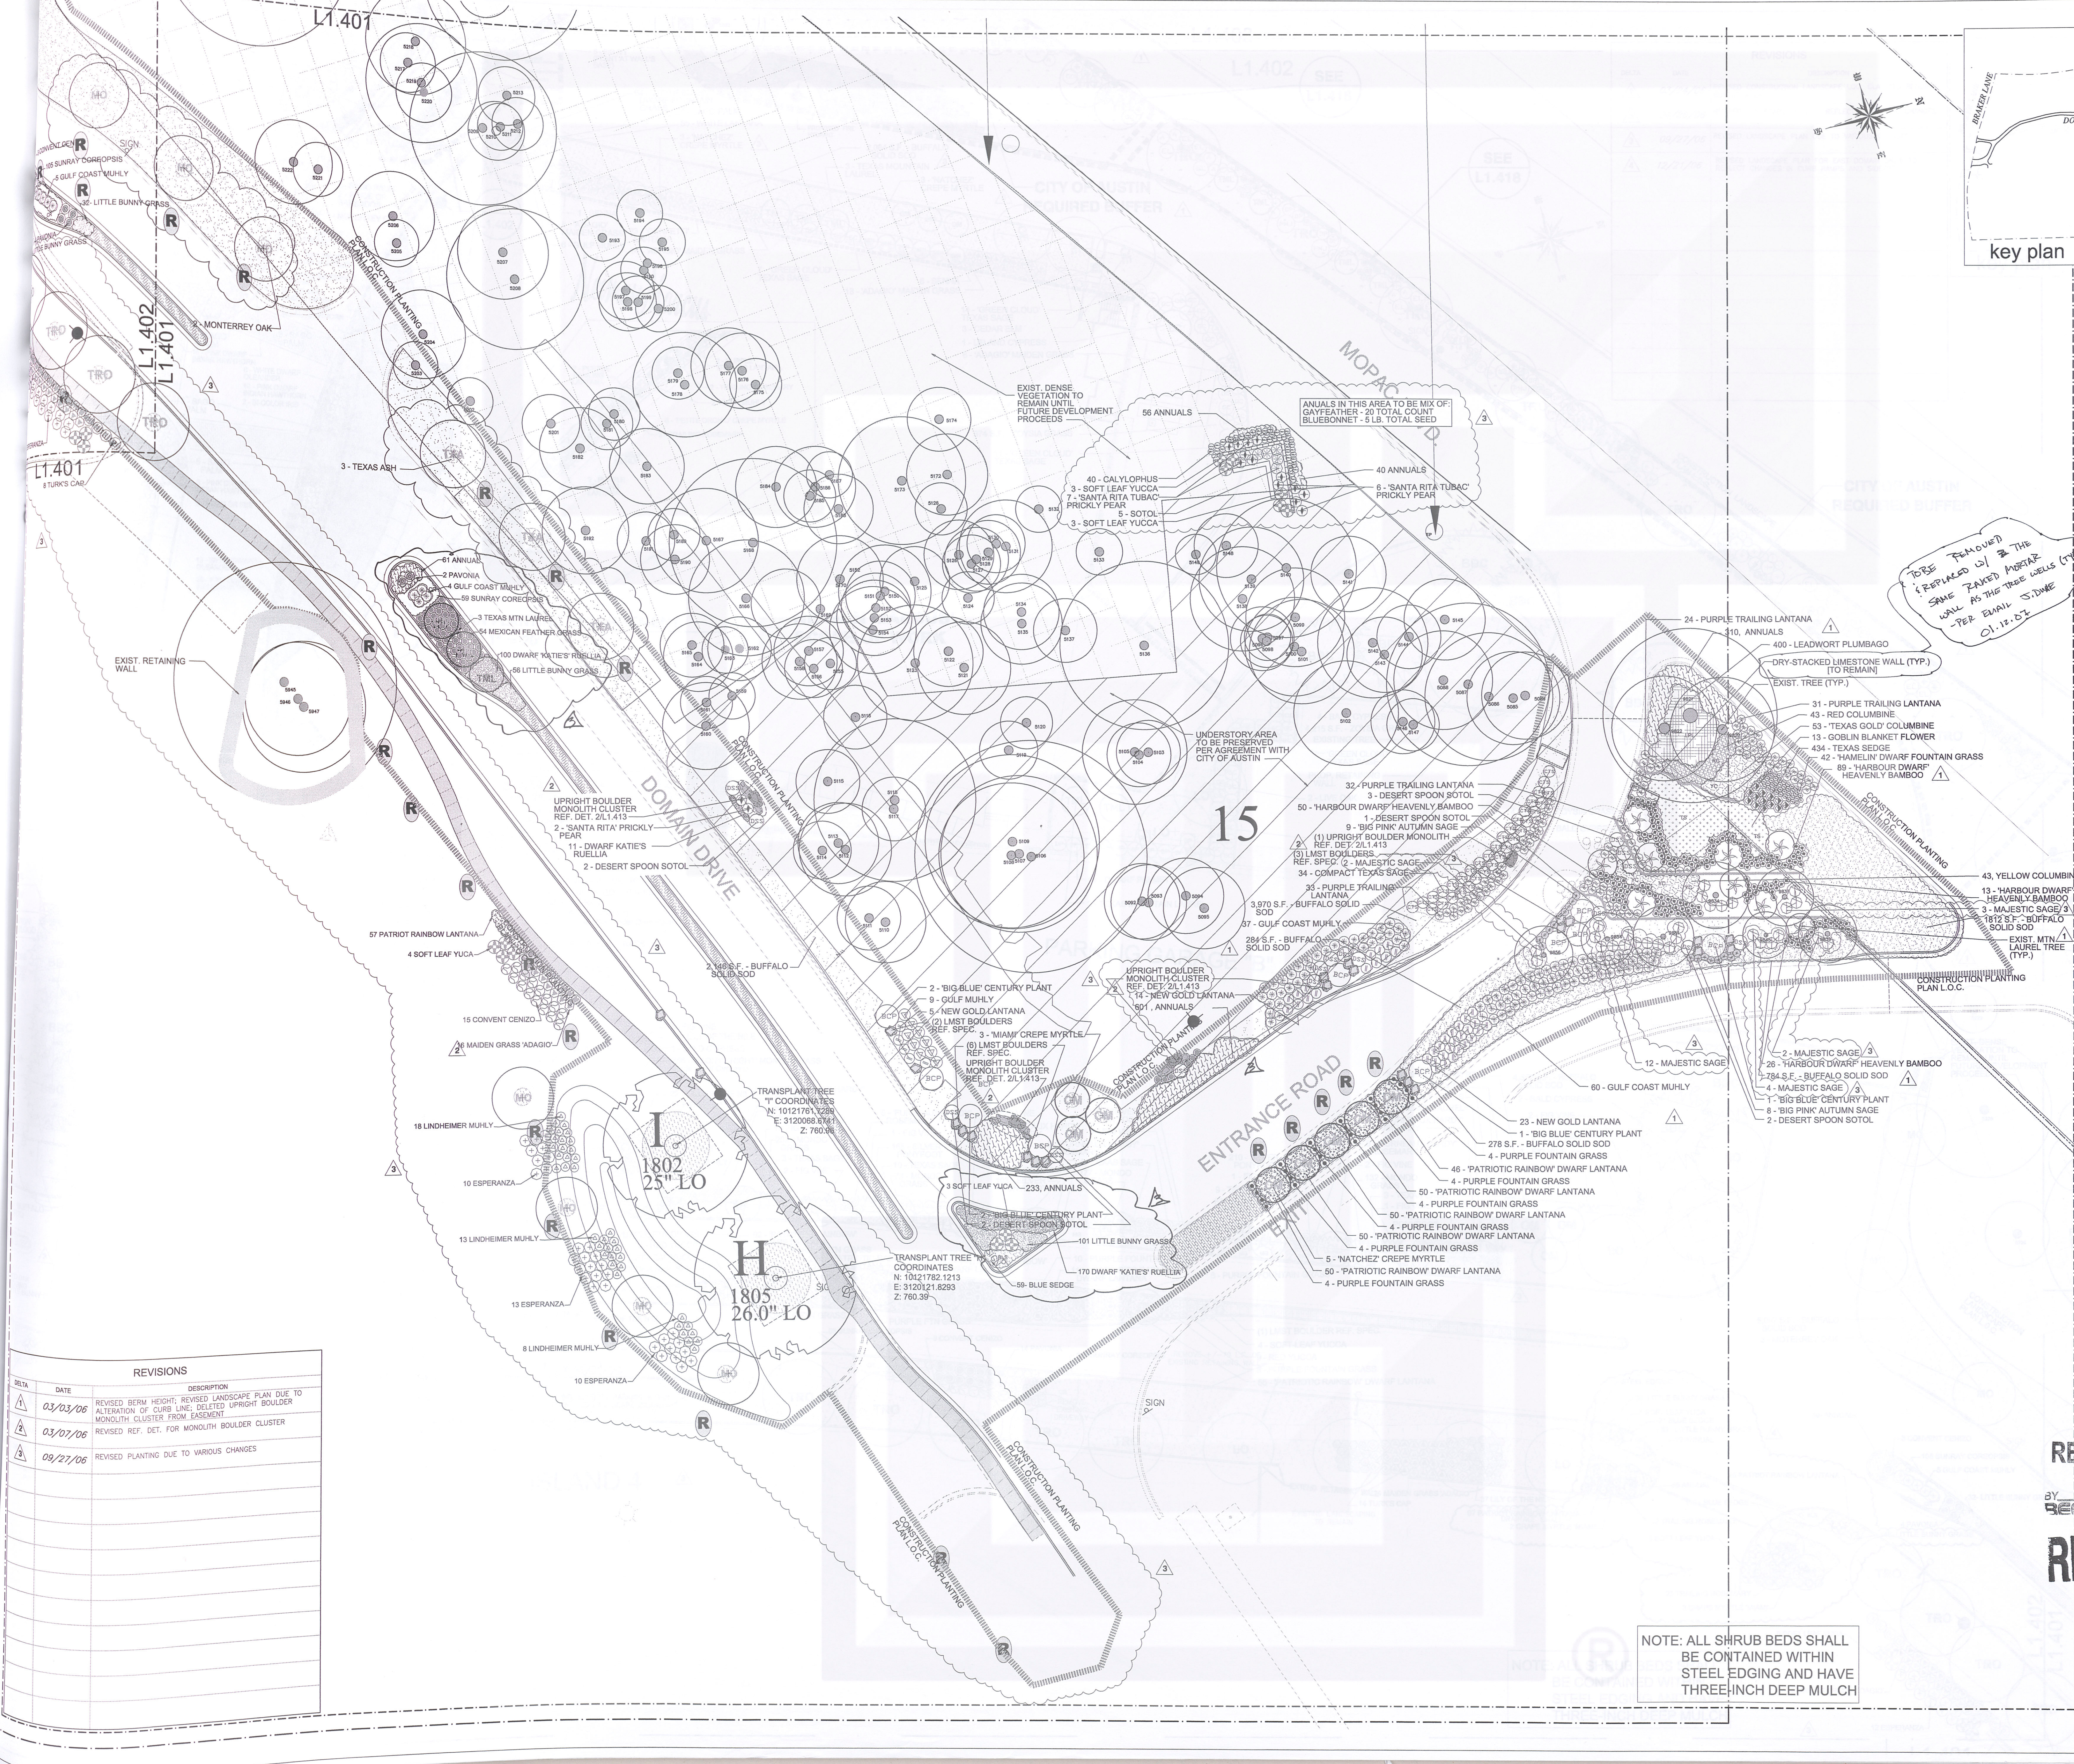

REVISIONS		
DATE	DESCRIPTION	
03/03/06	REVISED BERM HEIGHT, REVISED LANDSCAPE PLAN DUE TO ALTERATION OF CURB LINE, DELETED UPRIGHT BOULDER MONOLITH CLUSTER FROM BASEMENT	
03/07/06	REVISED REF. DET. FOR MONOLITH BOULDER CLUSTER	
09/27/06	REVISED PLANTING DUE TO VARIOUS CHANGES	

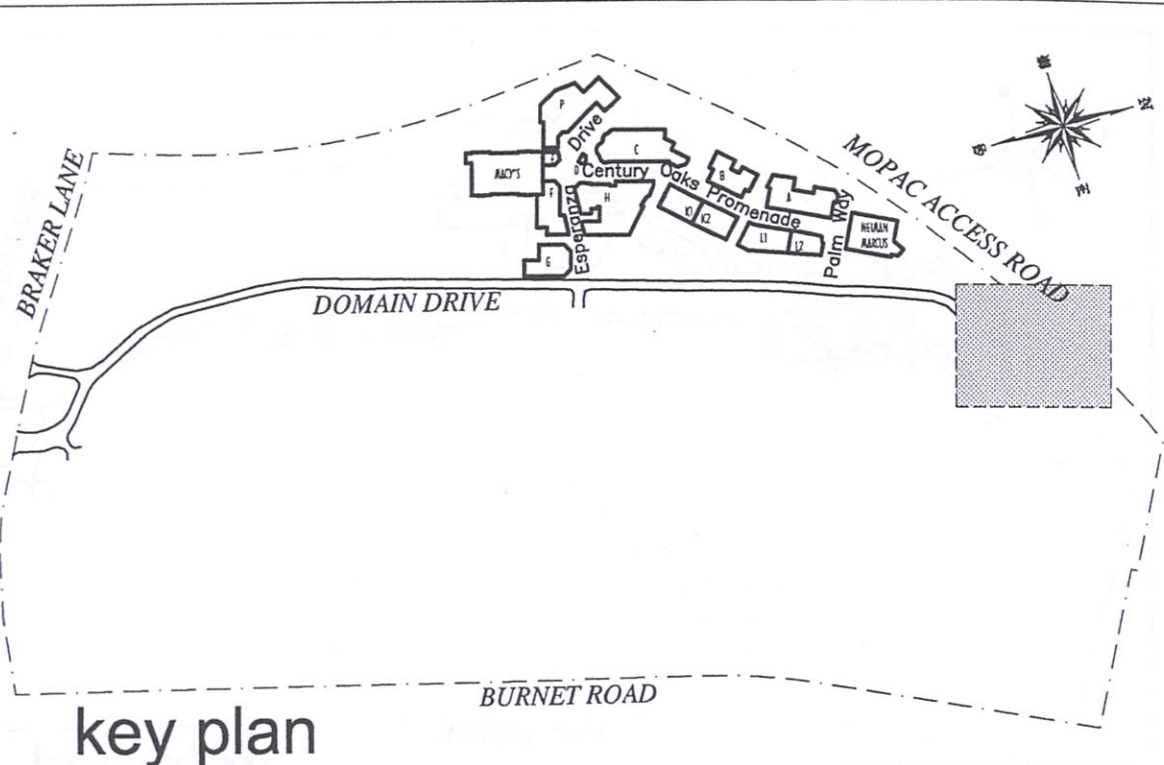

A JOINT VENTURE OF:

ENDEAVOR
REAL ESTATE GROUP

SIMON

J. Robert Anderson, FASLA
landscape architects . austin, texas .
3718 MANHATTAN ROAD
AUSTIN, TEXAS 78704
512.440.1049
440-5000 FAX

9.2.06

09/27/06 SCALE: 1" = 20'
0 10' 20' 40' 60'

Project:

the domain
AUSTIN, TEXAS

RECEIVED
OCT 03 2006
BY
BECK - AUSTIN

RECORD SET

SHEET TITLE:
PLANTING PLAN

Sheet No.
L1.401

JPRA ARCHITECTS
31000 Northwestern Suite 100
Farmingington Hills, Michigan 48334-2585
phone 248.737.0180 fax 248.737.9161