


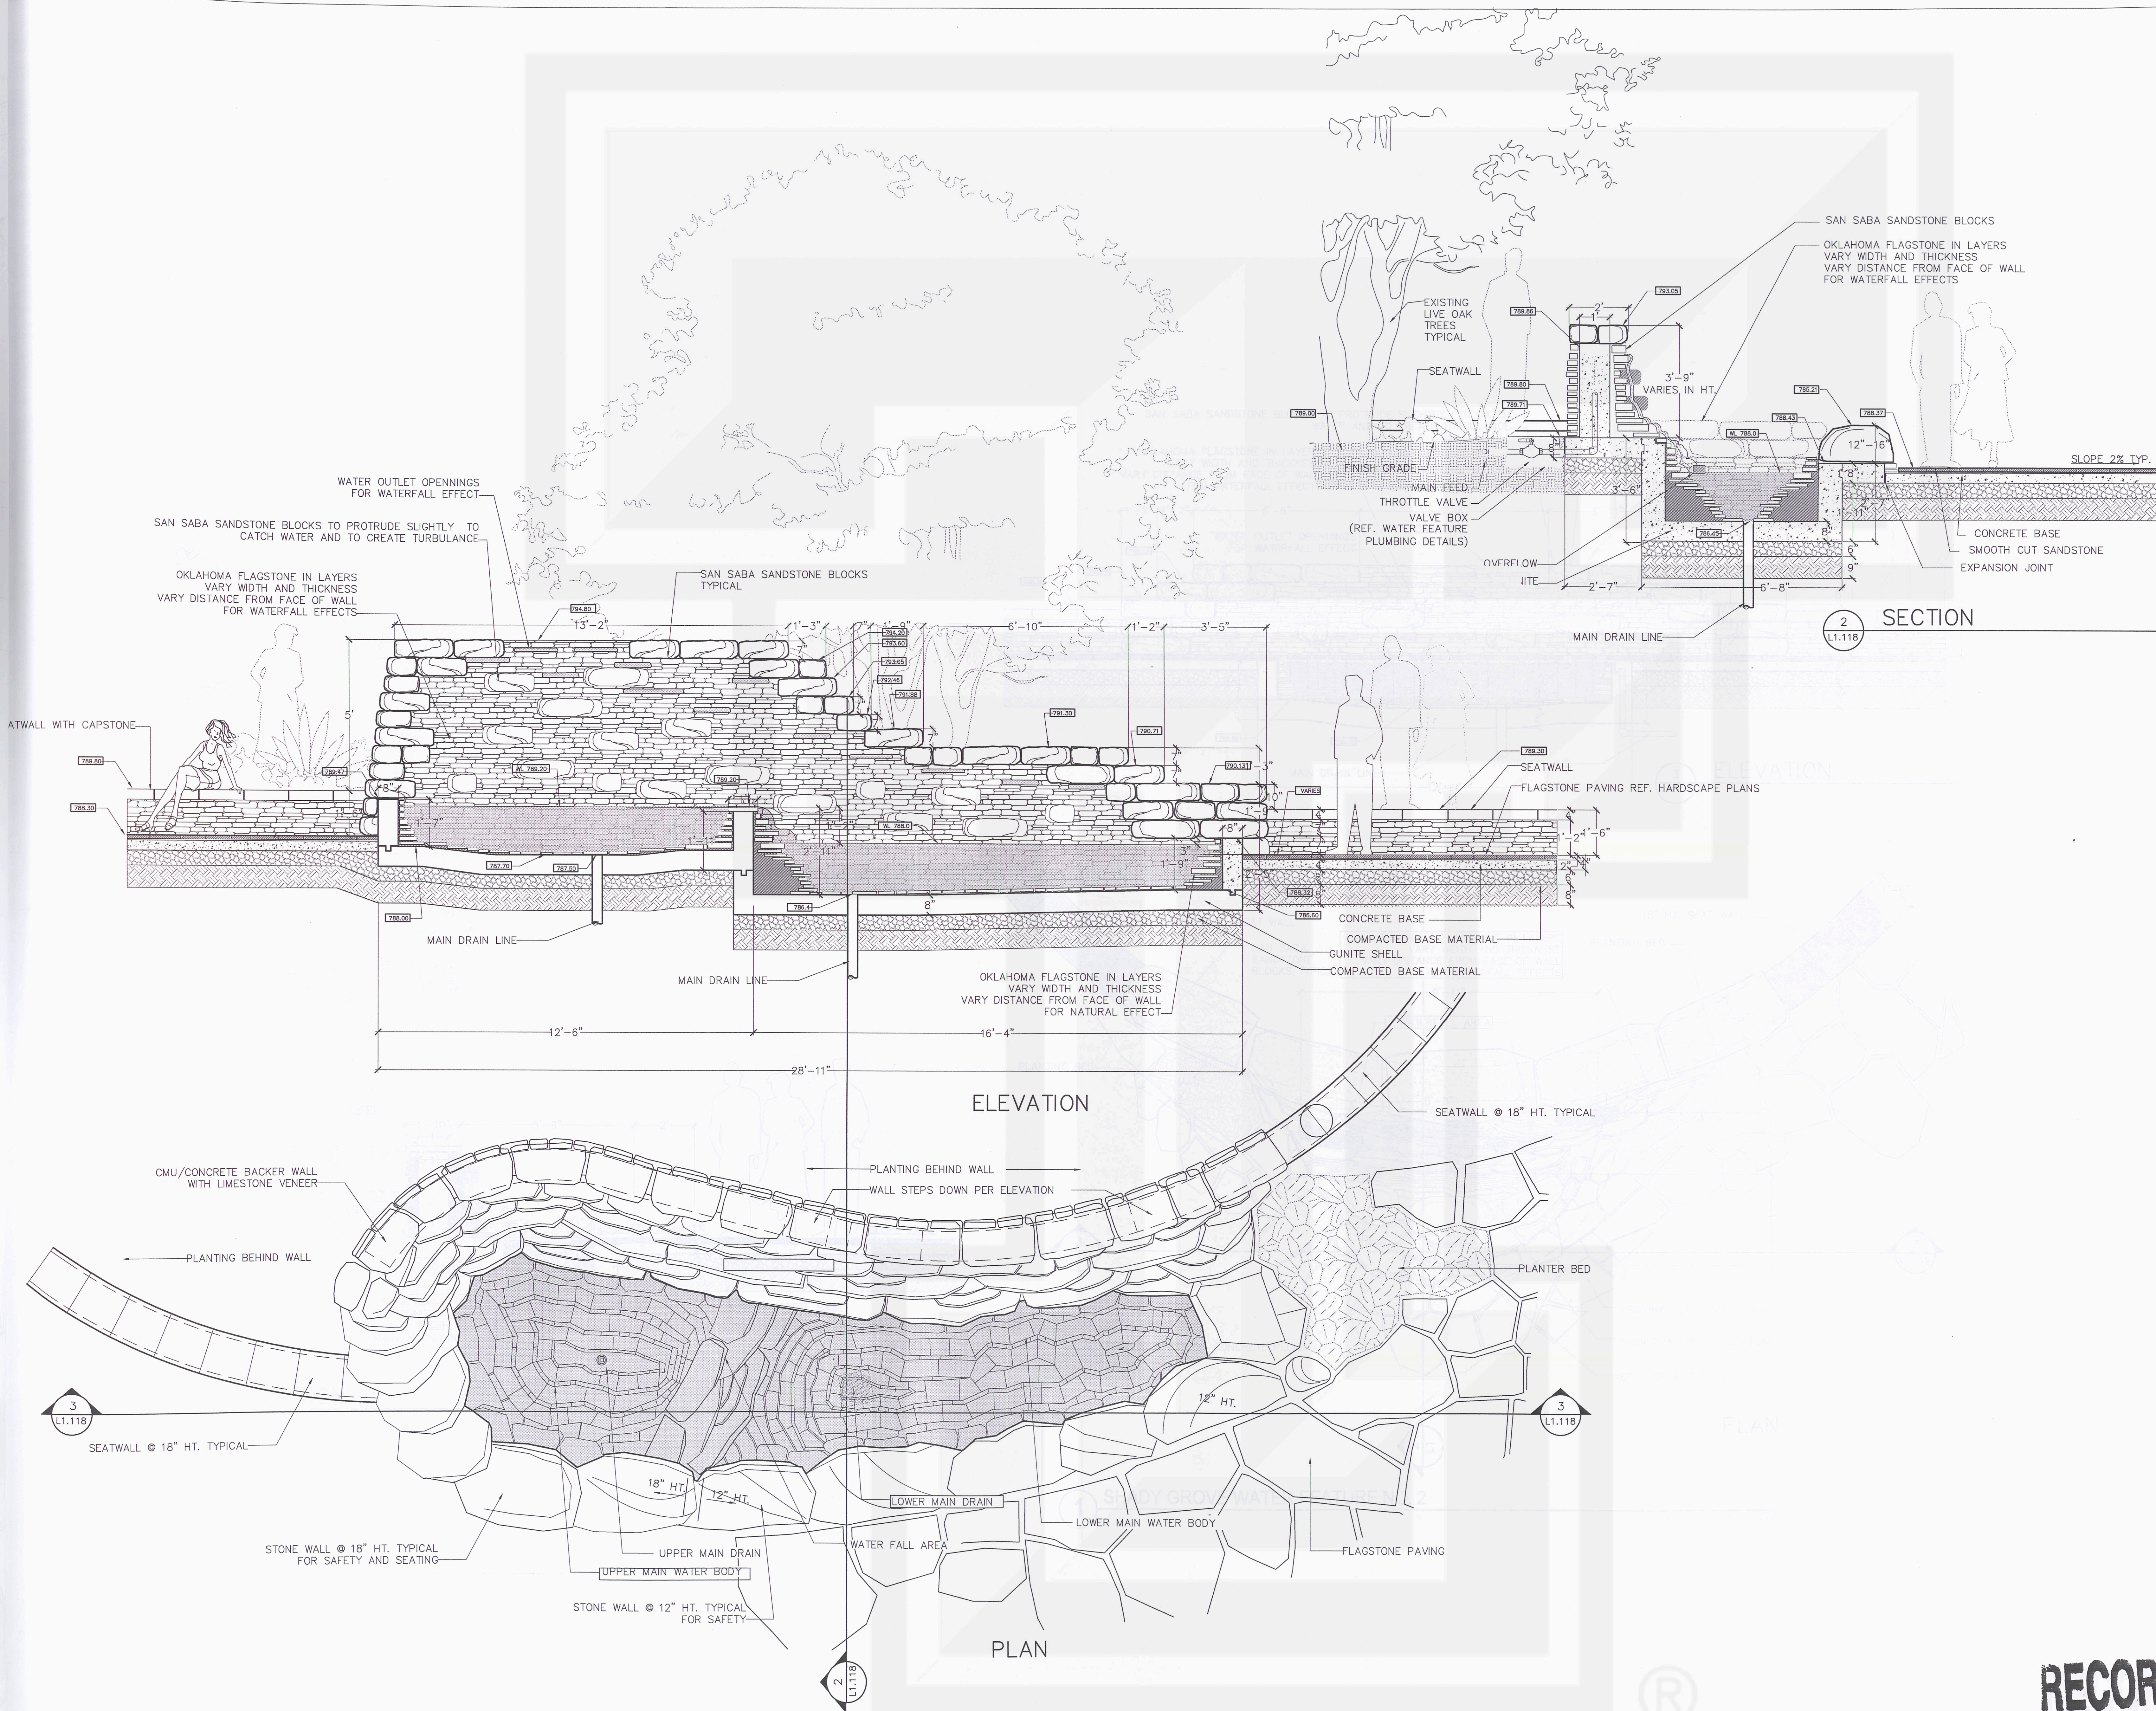

A JOINT VENTURE OF:

SIMON

ENDEAVOR

REAL ESTATE GROUP

J. Robert Anderson, FASLA

landscape architects, austin, texas

3718 MANHACA ROAD
AUSTIN, TEXAS 78704
512.440.1049
440-8000 FAX



09/27/06

Project:

the domain

AUSTIN, TEXAS

JPRA ARCHITECTS

31000 Northwestern Suite 100
Farmington Hills Michigan 48334-2585
phone 248.737.0160 fax 248.737.9161

RECEIVED

OCT 04 2006

BY: *[Signature]*

BECK - AUSTIN

SHEET TITLE:
WATER FEATURE DETAILS

Sheet No.
L1.118

RECORD SET