


IRRIGATION SYSTEM LAYOUT IS DIAGRAMMATIC
EXACT LOCATION OF PIPING, HEADS AND
VALVES SHALL BE ESTABLISHED IN THE
FIELD AT THE TIME OF INSTALLATION.

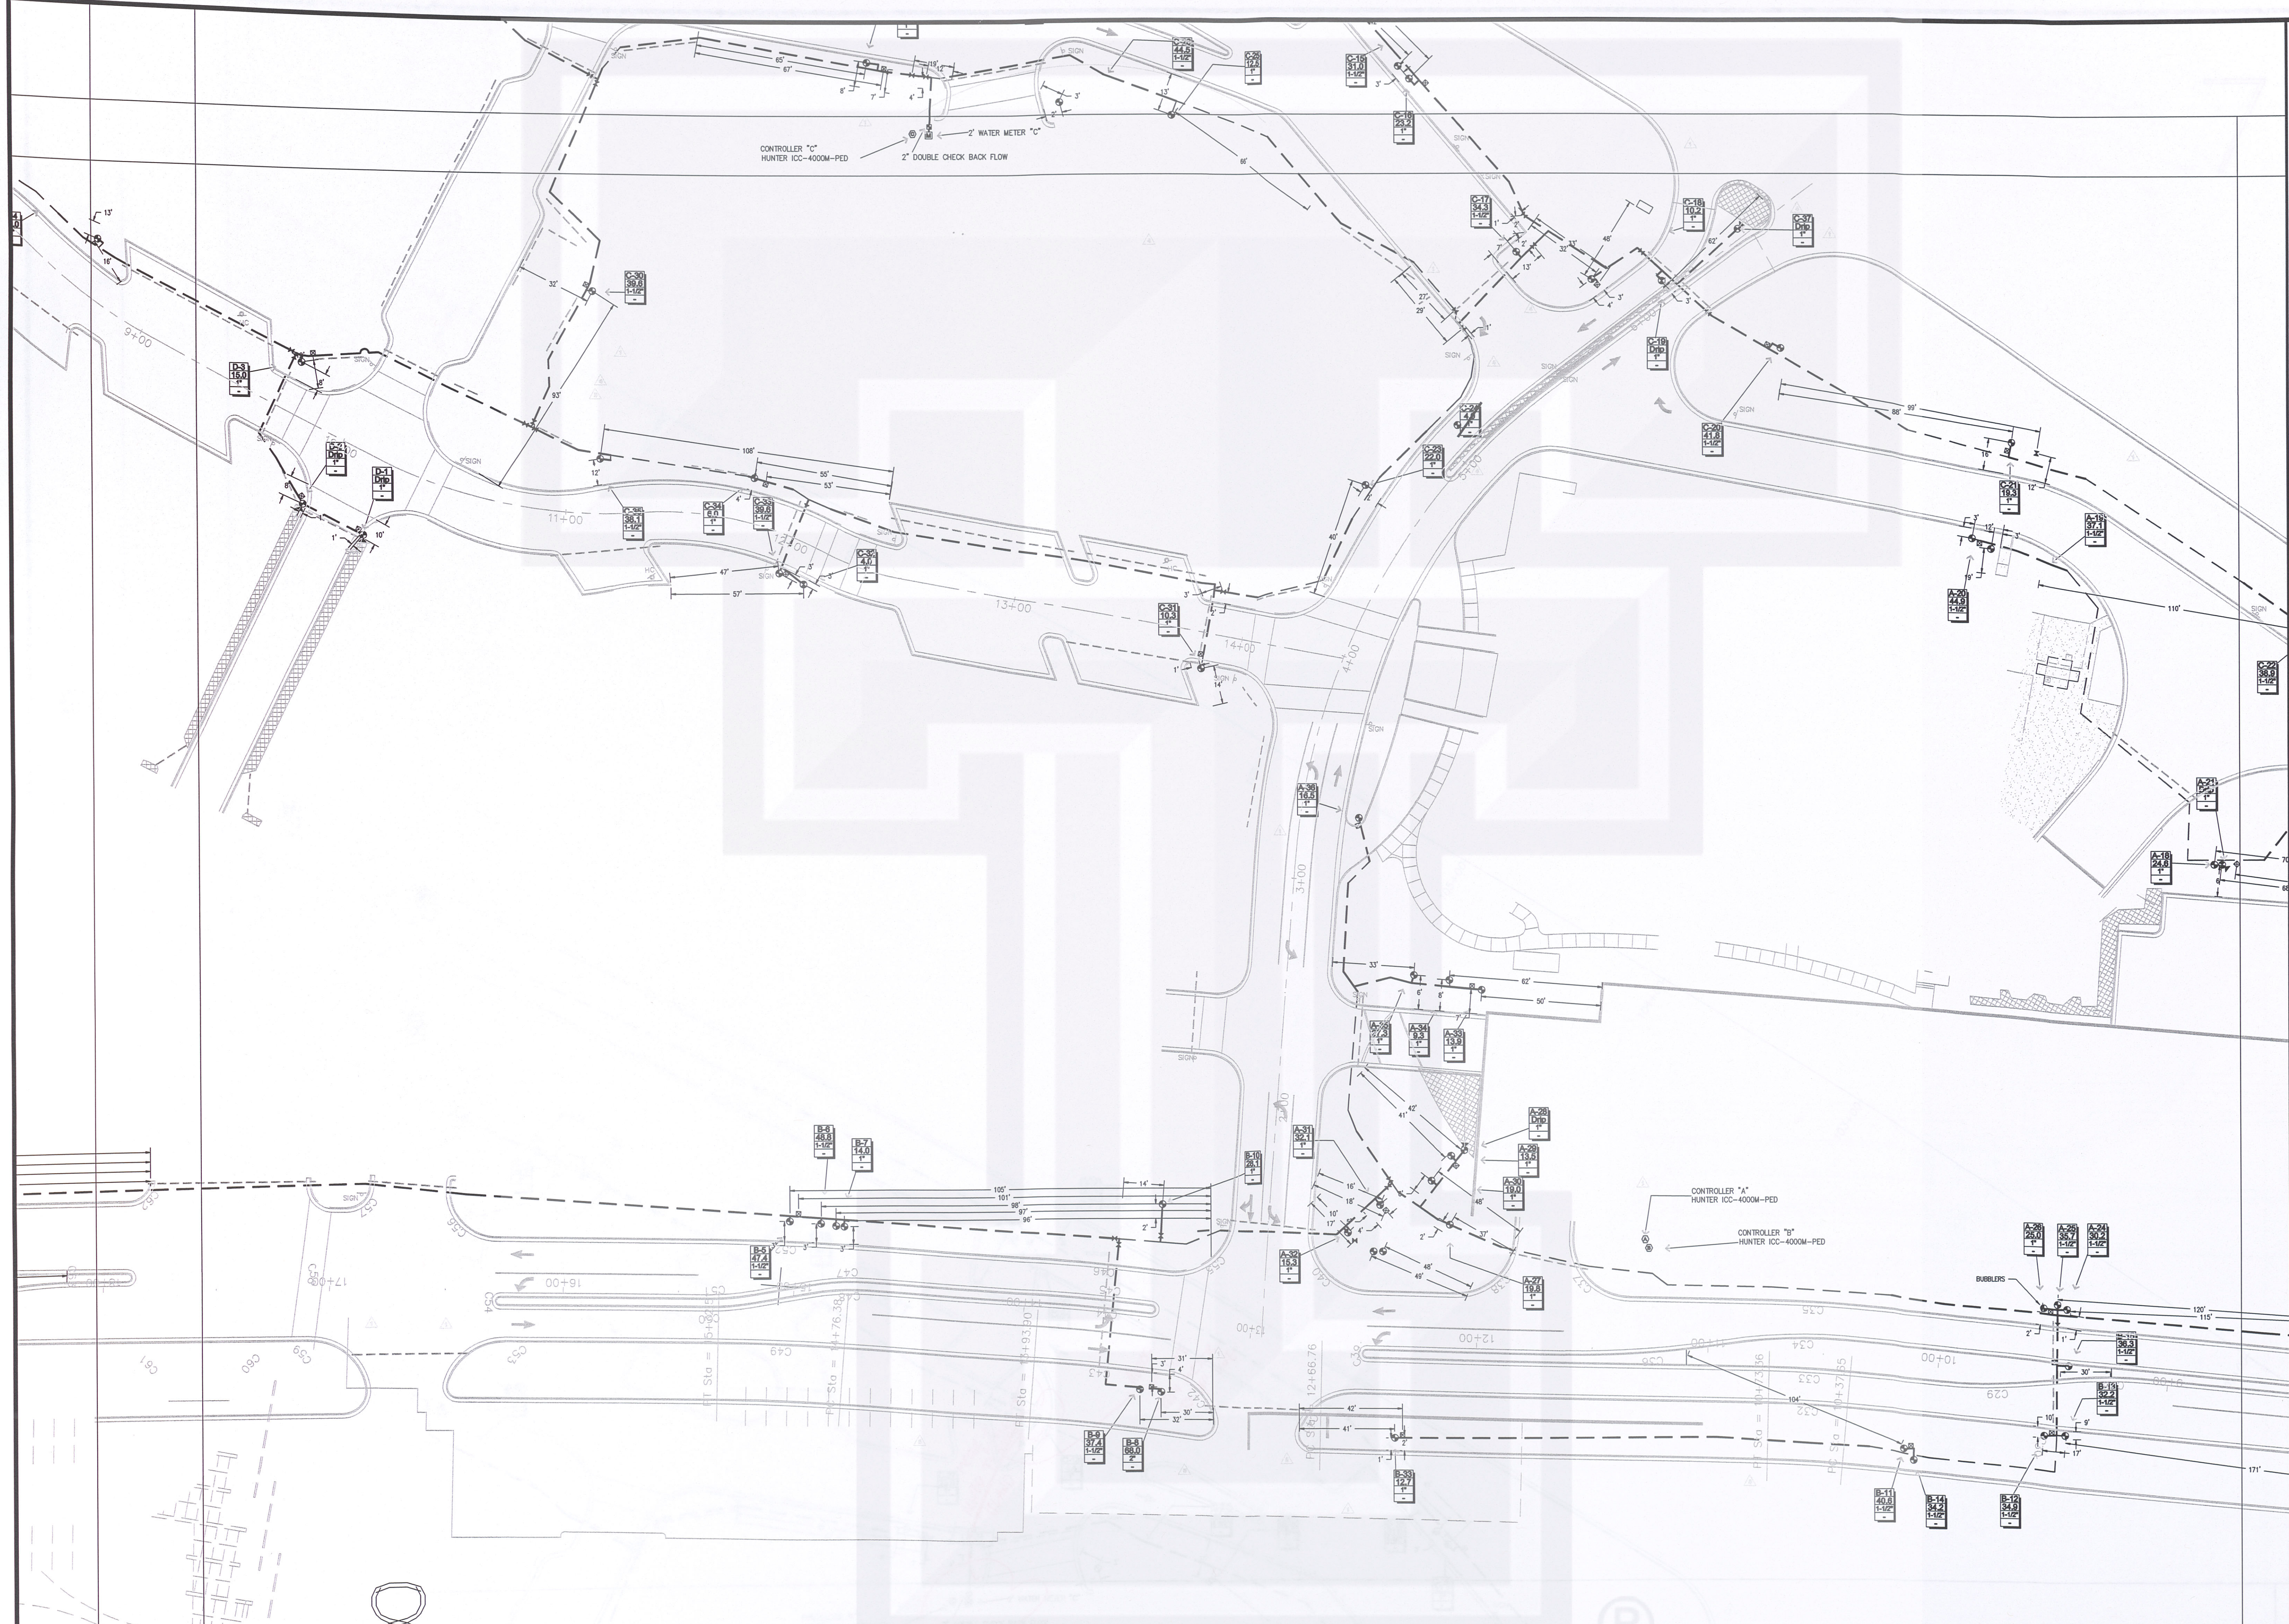

 **PHOENIX**
IRRIGATION

AUSTIN, TX
(512) 282-7394
SAN ANTONIO, TX
(210) 496-5185

DATE: 06/15/07
SCALE: 1"=30' 0"
PAGE 8 OF 10
AS-BUILT

PROJECT:
The Domain
AUSTIN, TEXAS