


**FRONT SECTION**

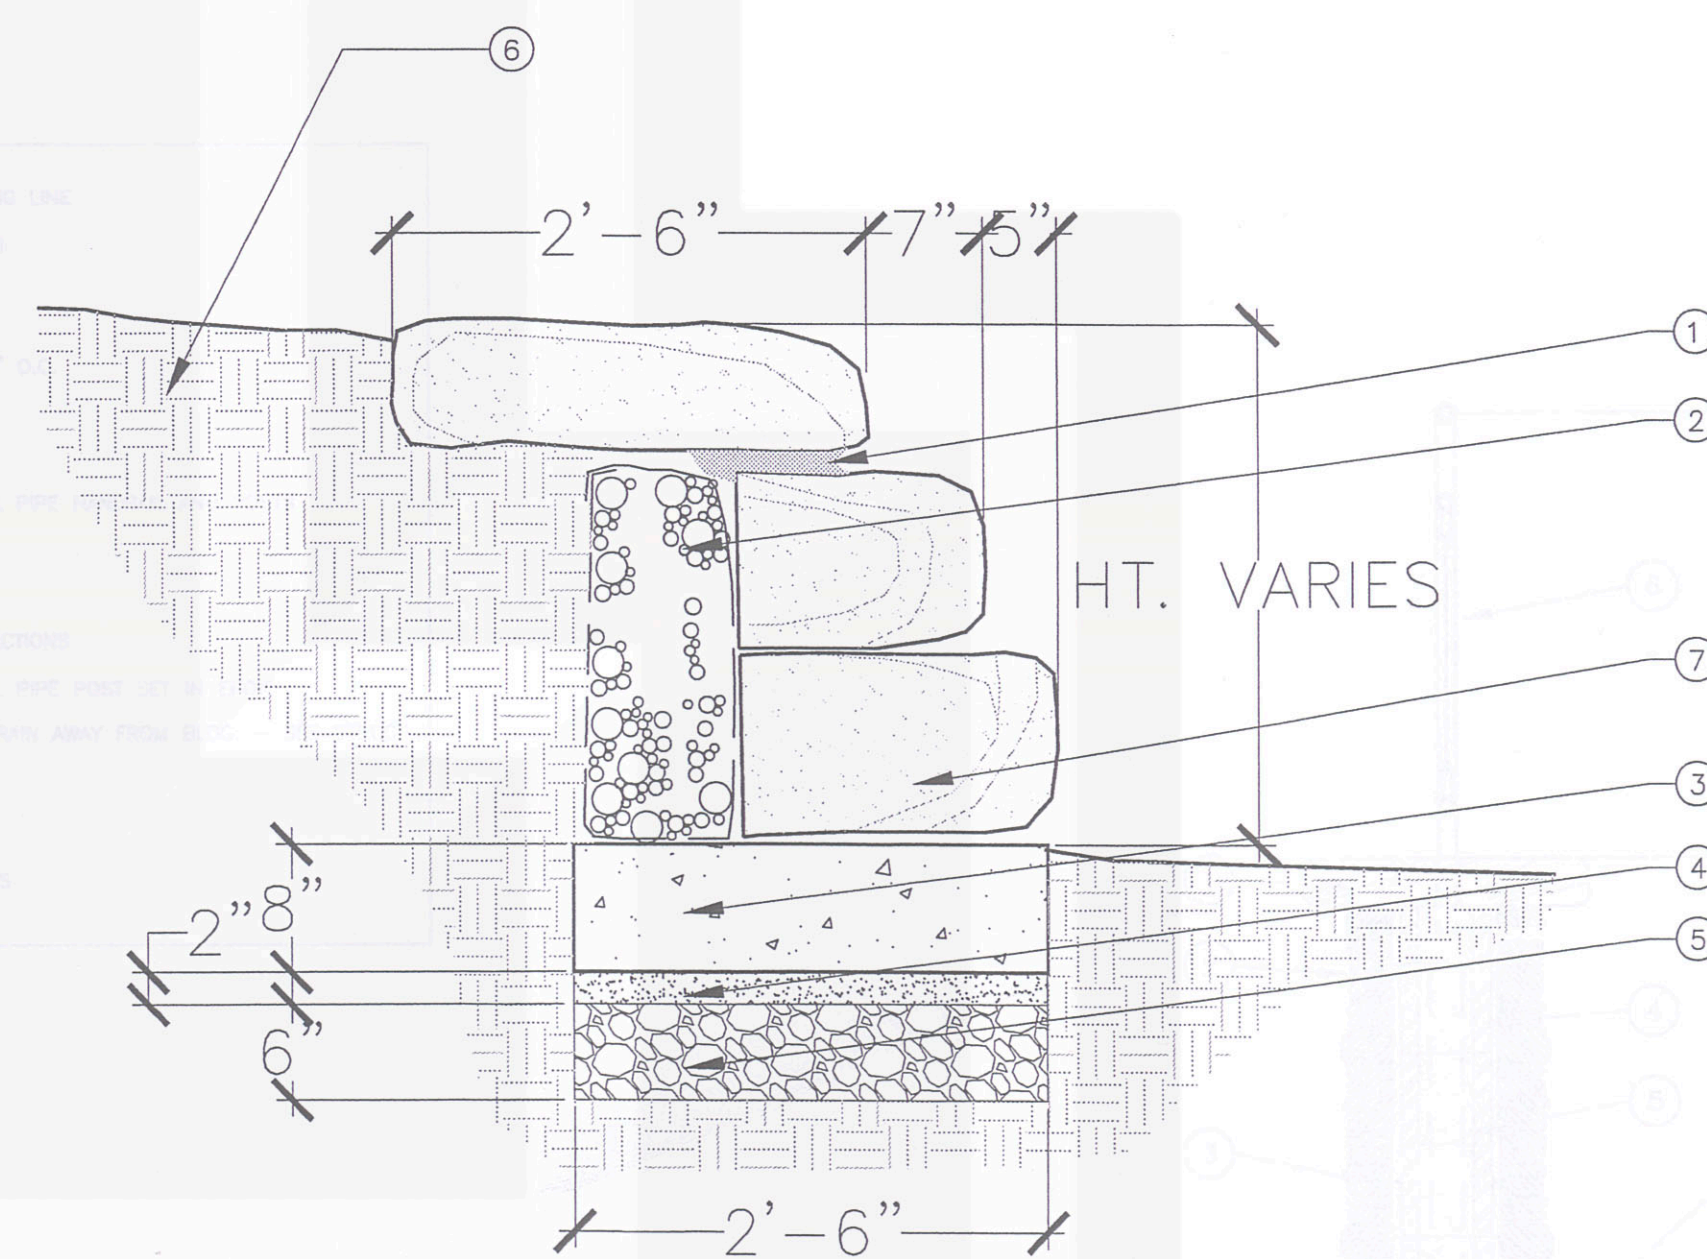

## 2 BOULDER RETAINING WALL

SCALE: 1/2" = 1'-0"

- NTS

# RECORD SET

**SIMON™**  
**ENDEAVOR**  
 REAL ESTATE GROUP



the domain  
AUSTIN, TEXAS

RECEIVED  
OCT 04 2006  
BY #303  
RECK - AUSTIN

SHEET TITLE:  
**WATER FEATURE DETAILS**

Sheet No. **L1.123**