

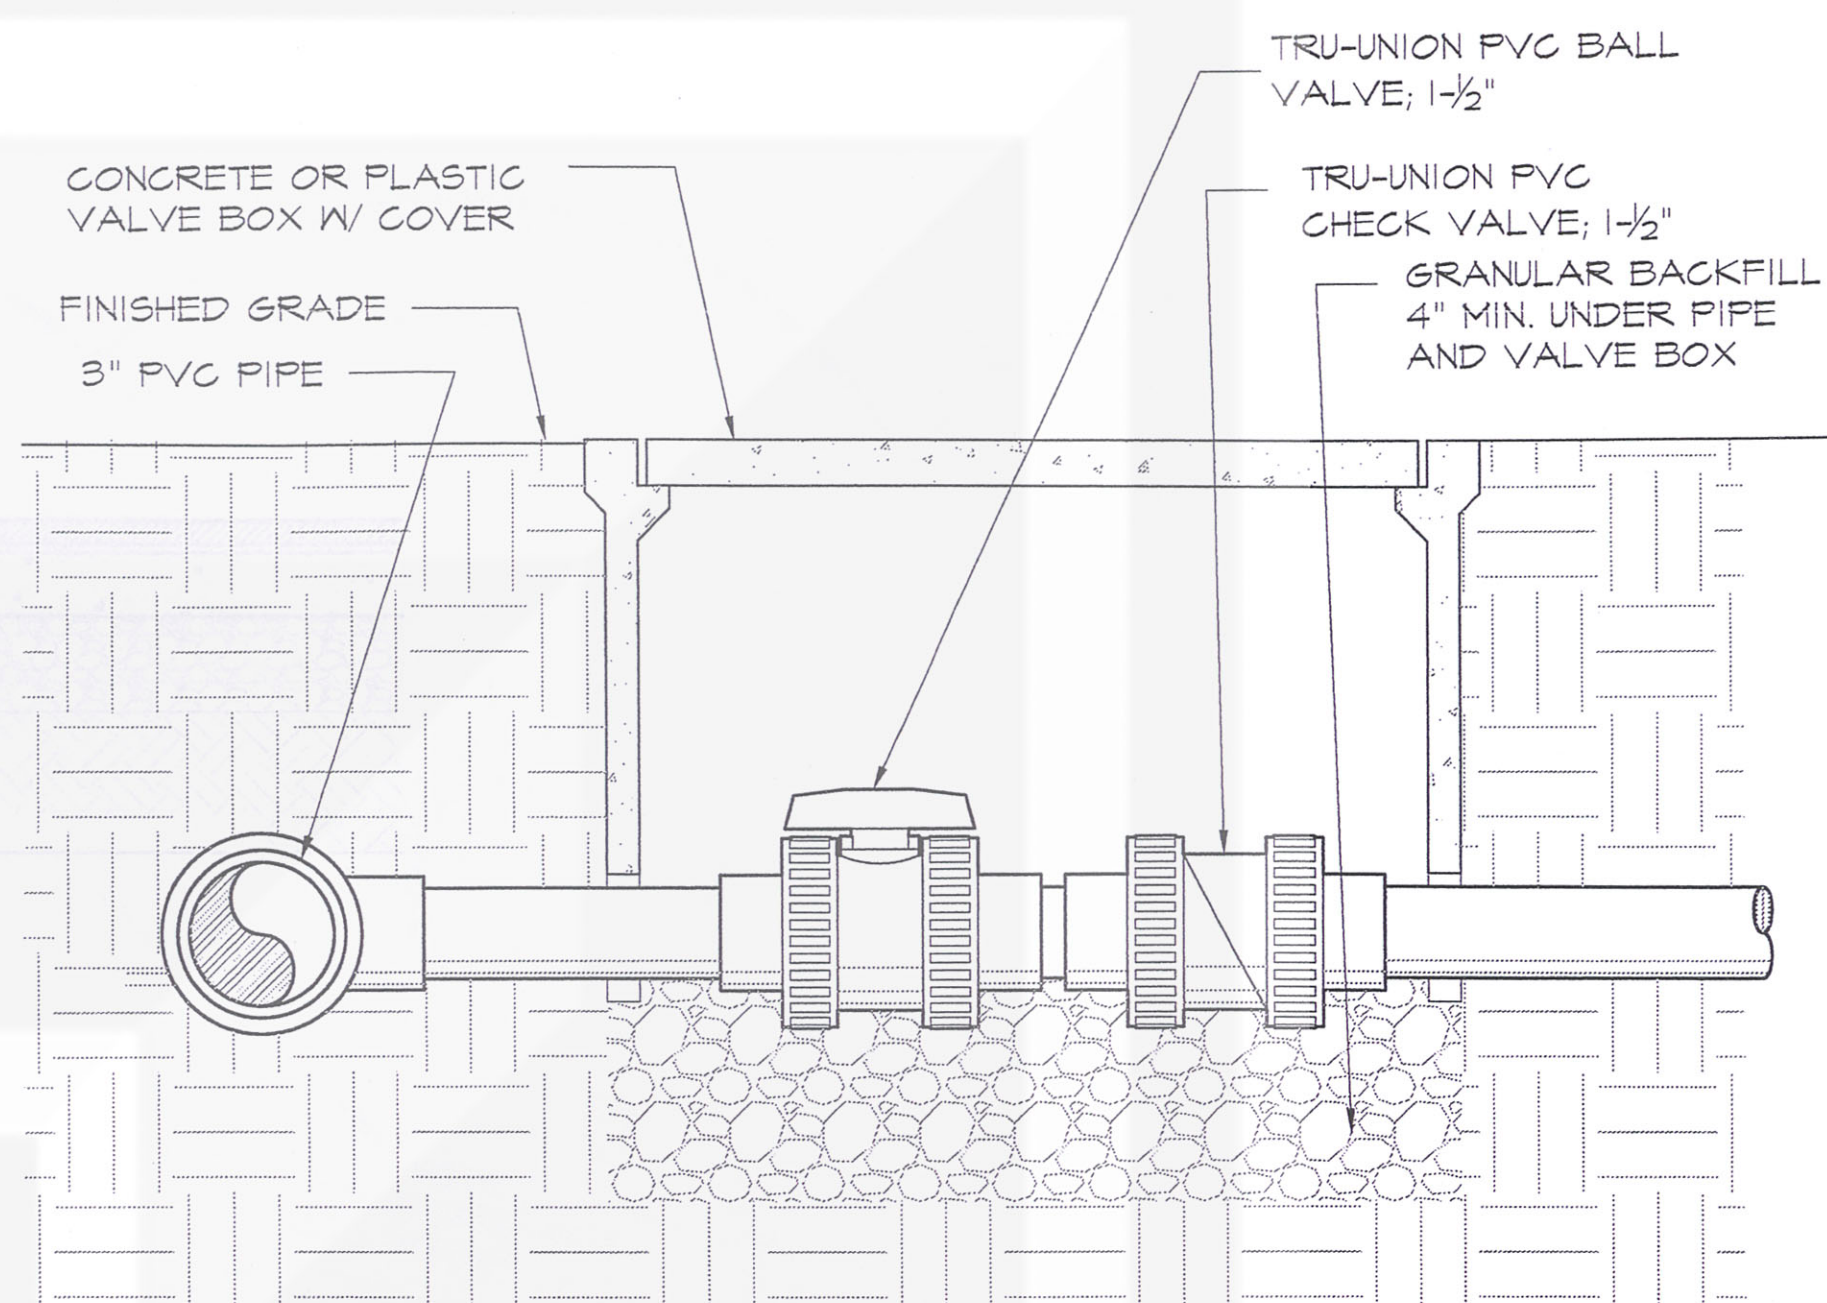


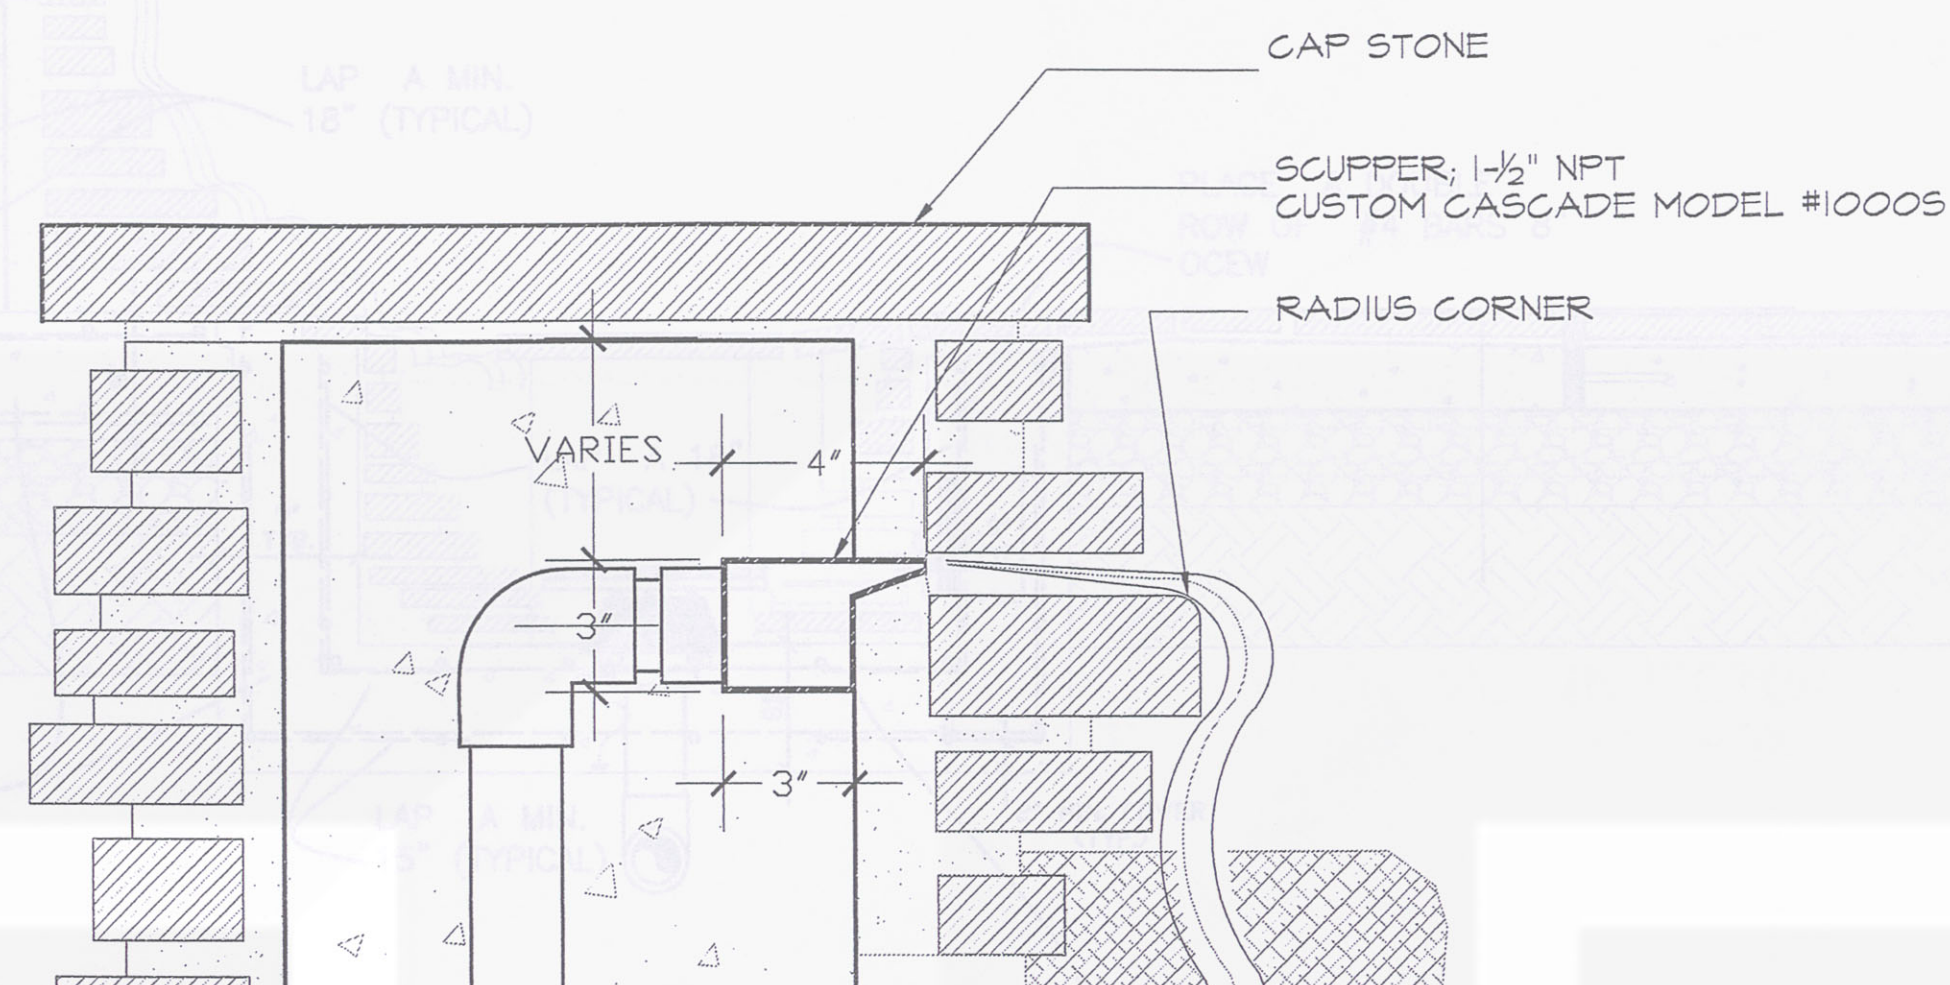


2 SCUPPER DETAIL
SCALE: 3"=1'-0"

3 DISTRIBUTION VALVE BOX SECTION
SCALE: 3"=1'-0"

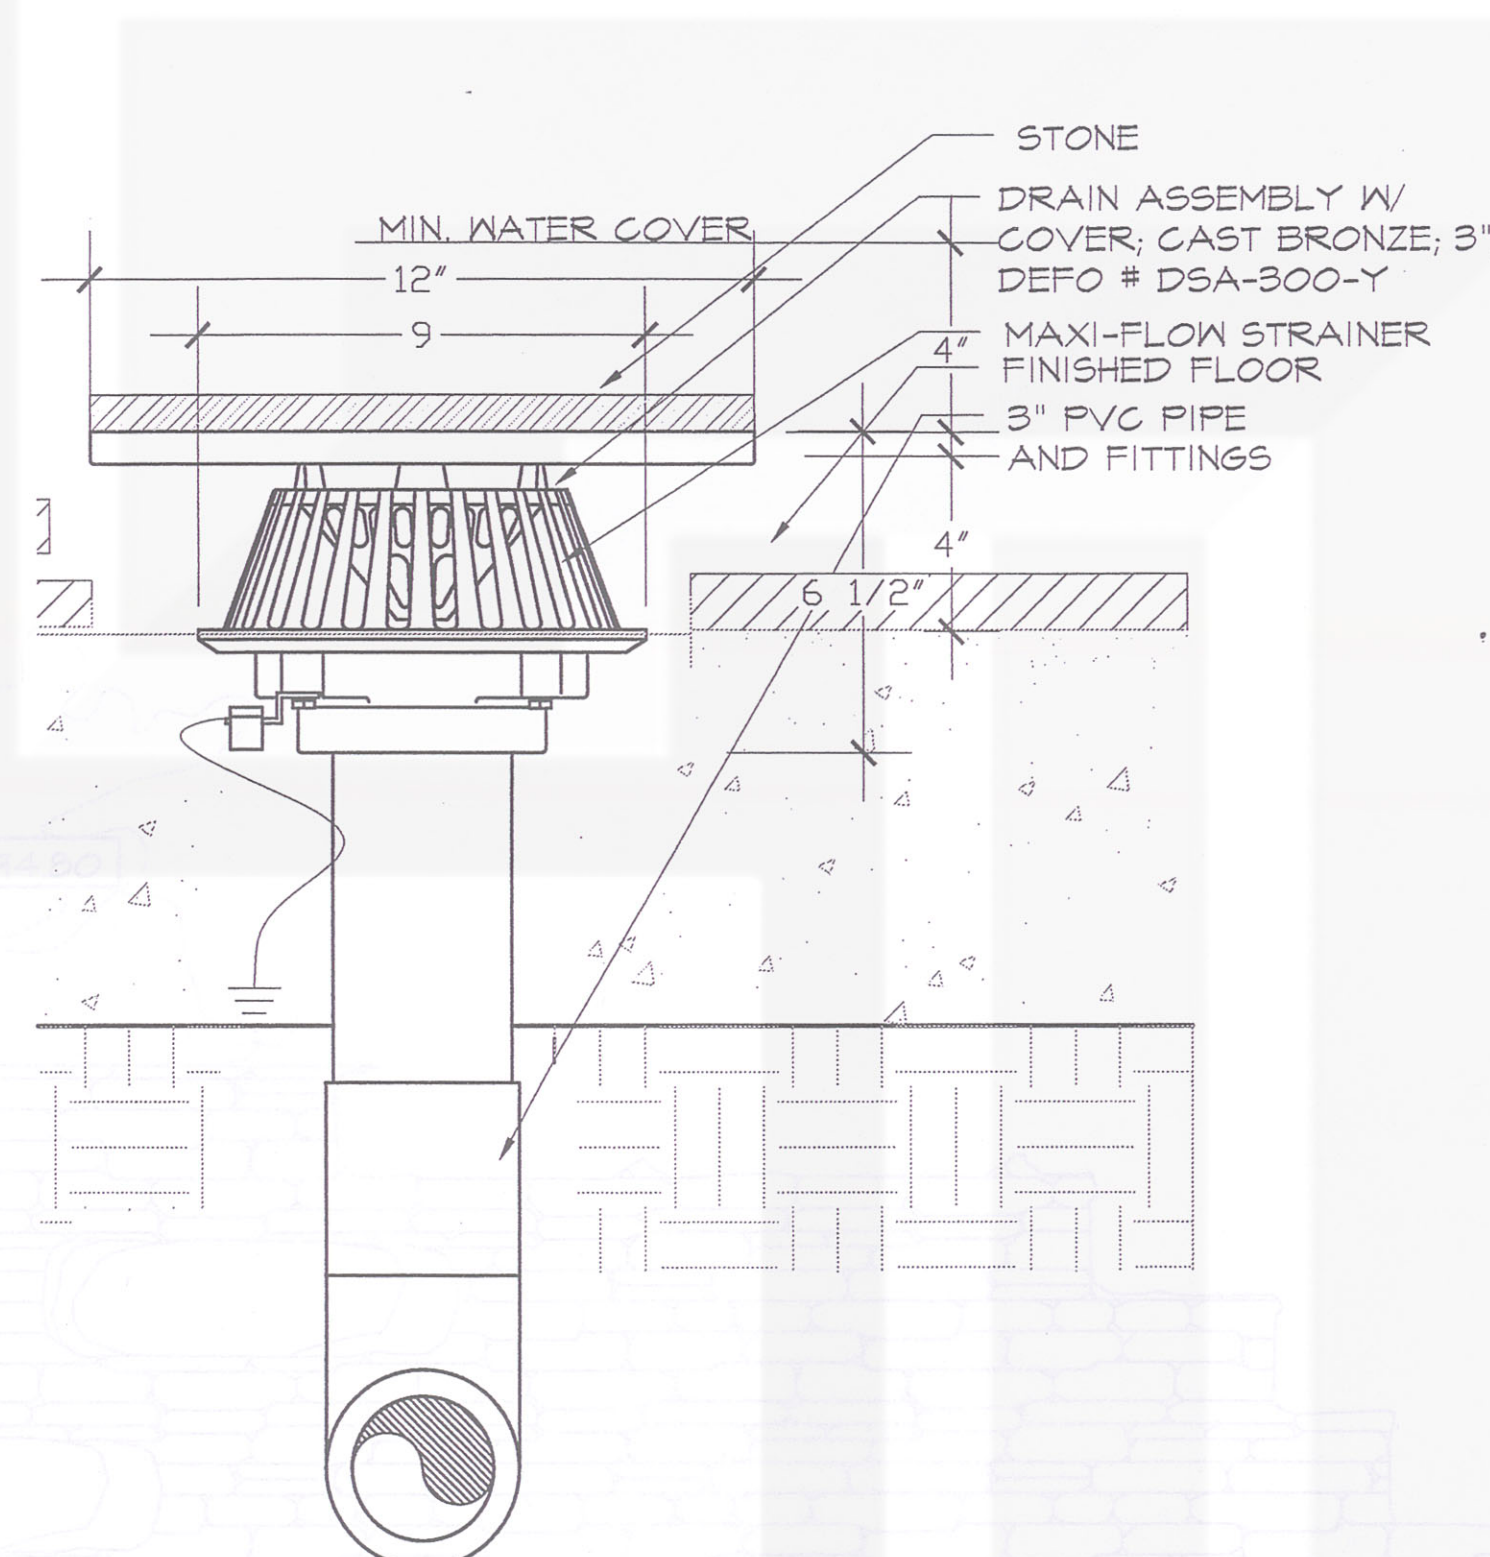


4 3" FLOOR DRAIN DETAIL
SCALE: 3"=1'-0"


5 8" FLOOR DRAIN DETAIL
SCALE: 3"=1'-0"

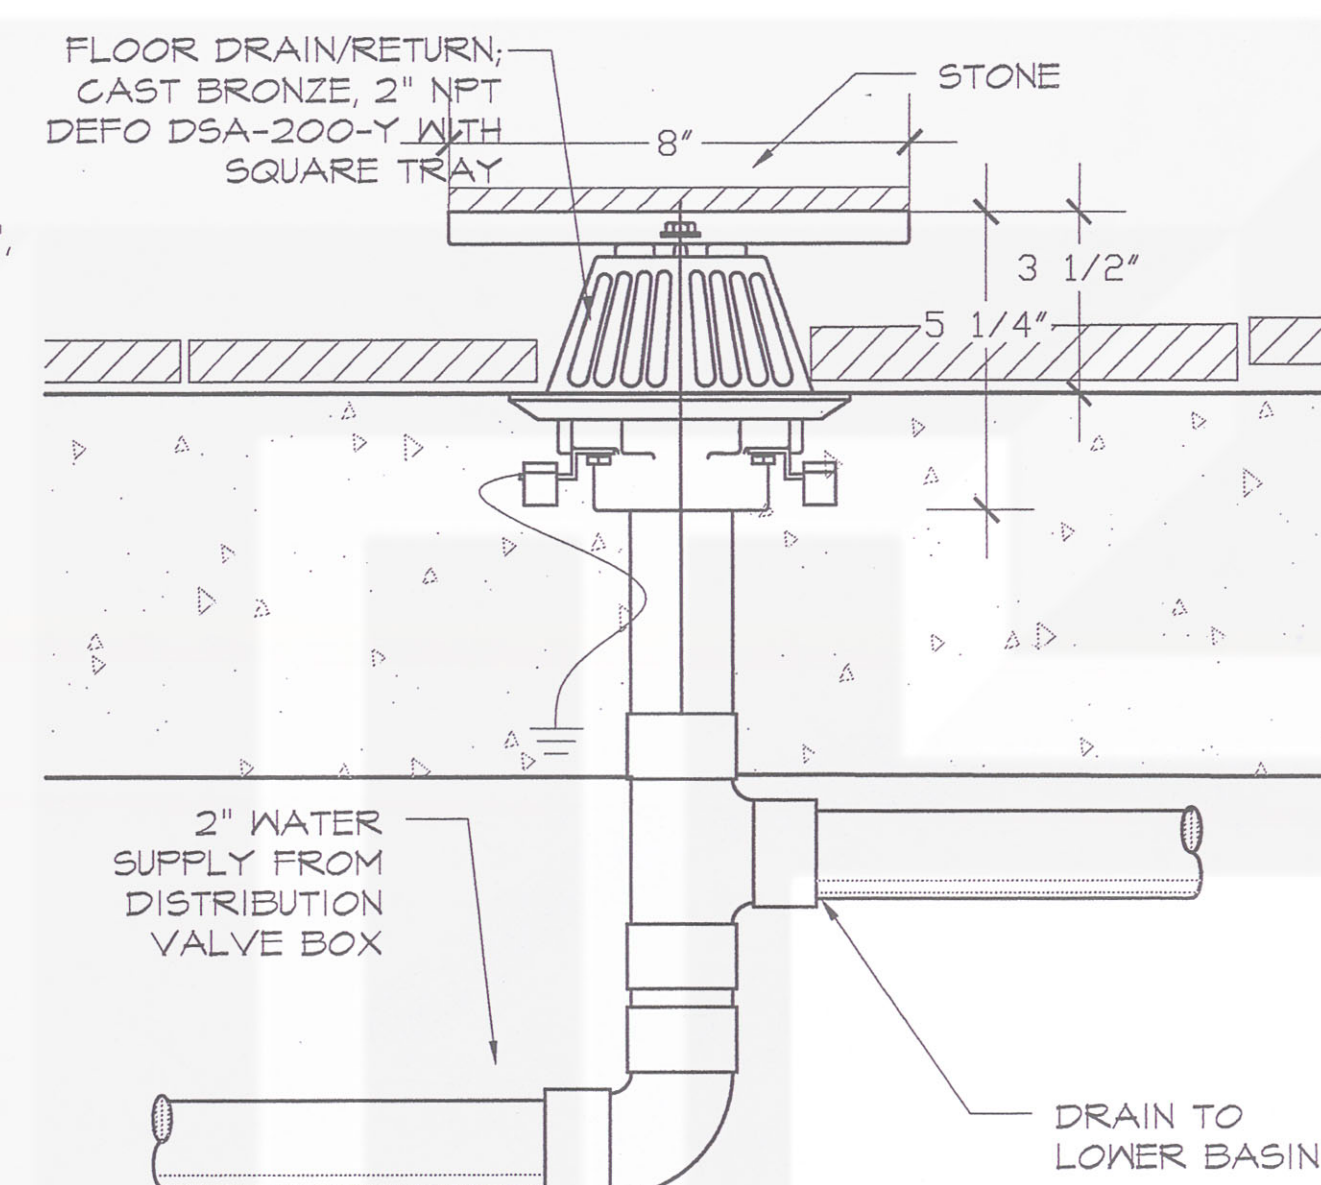

6 FLOOR RETURN/DRAIN
SCALE: 3"=1'-0"

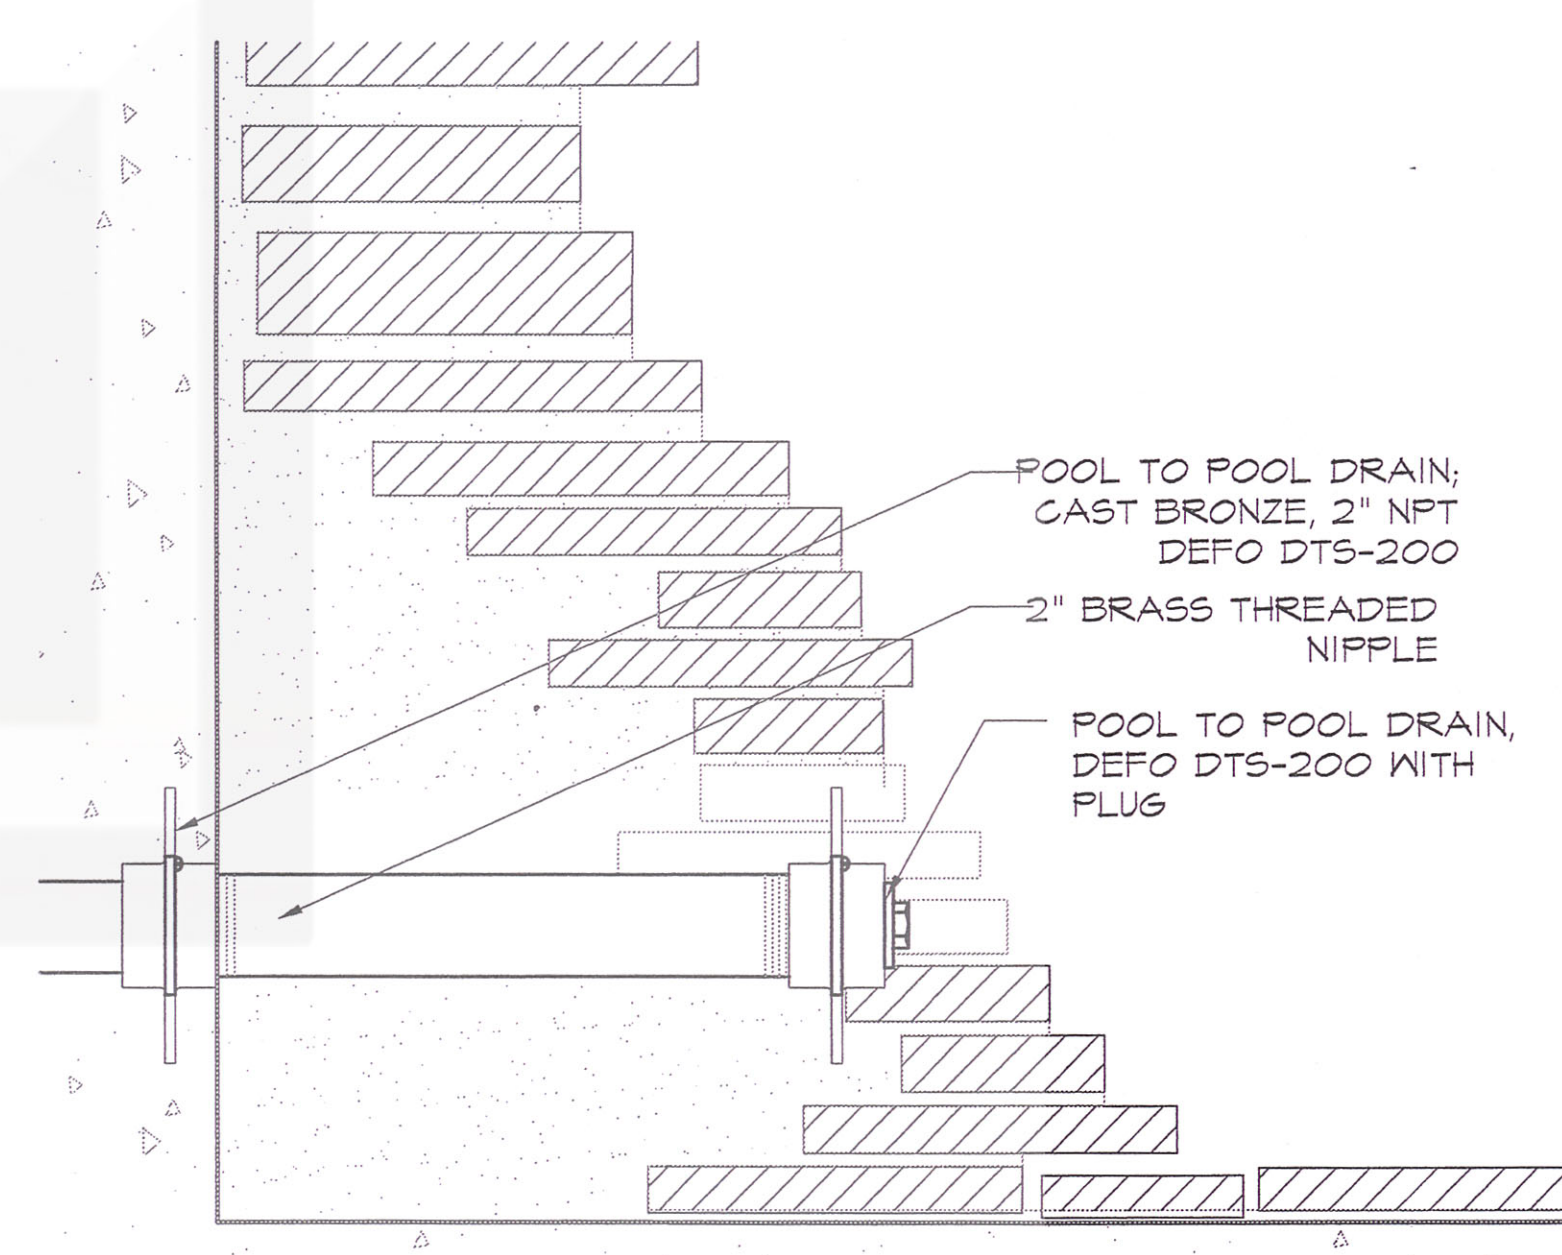


7 POOL TO POOL DRAIN
SCALE: 3"=1'-0"

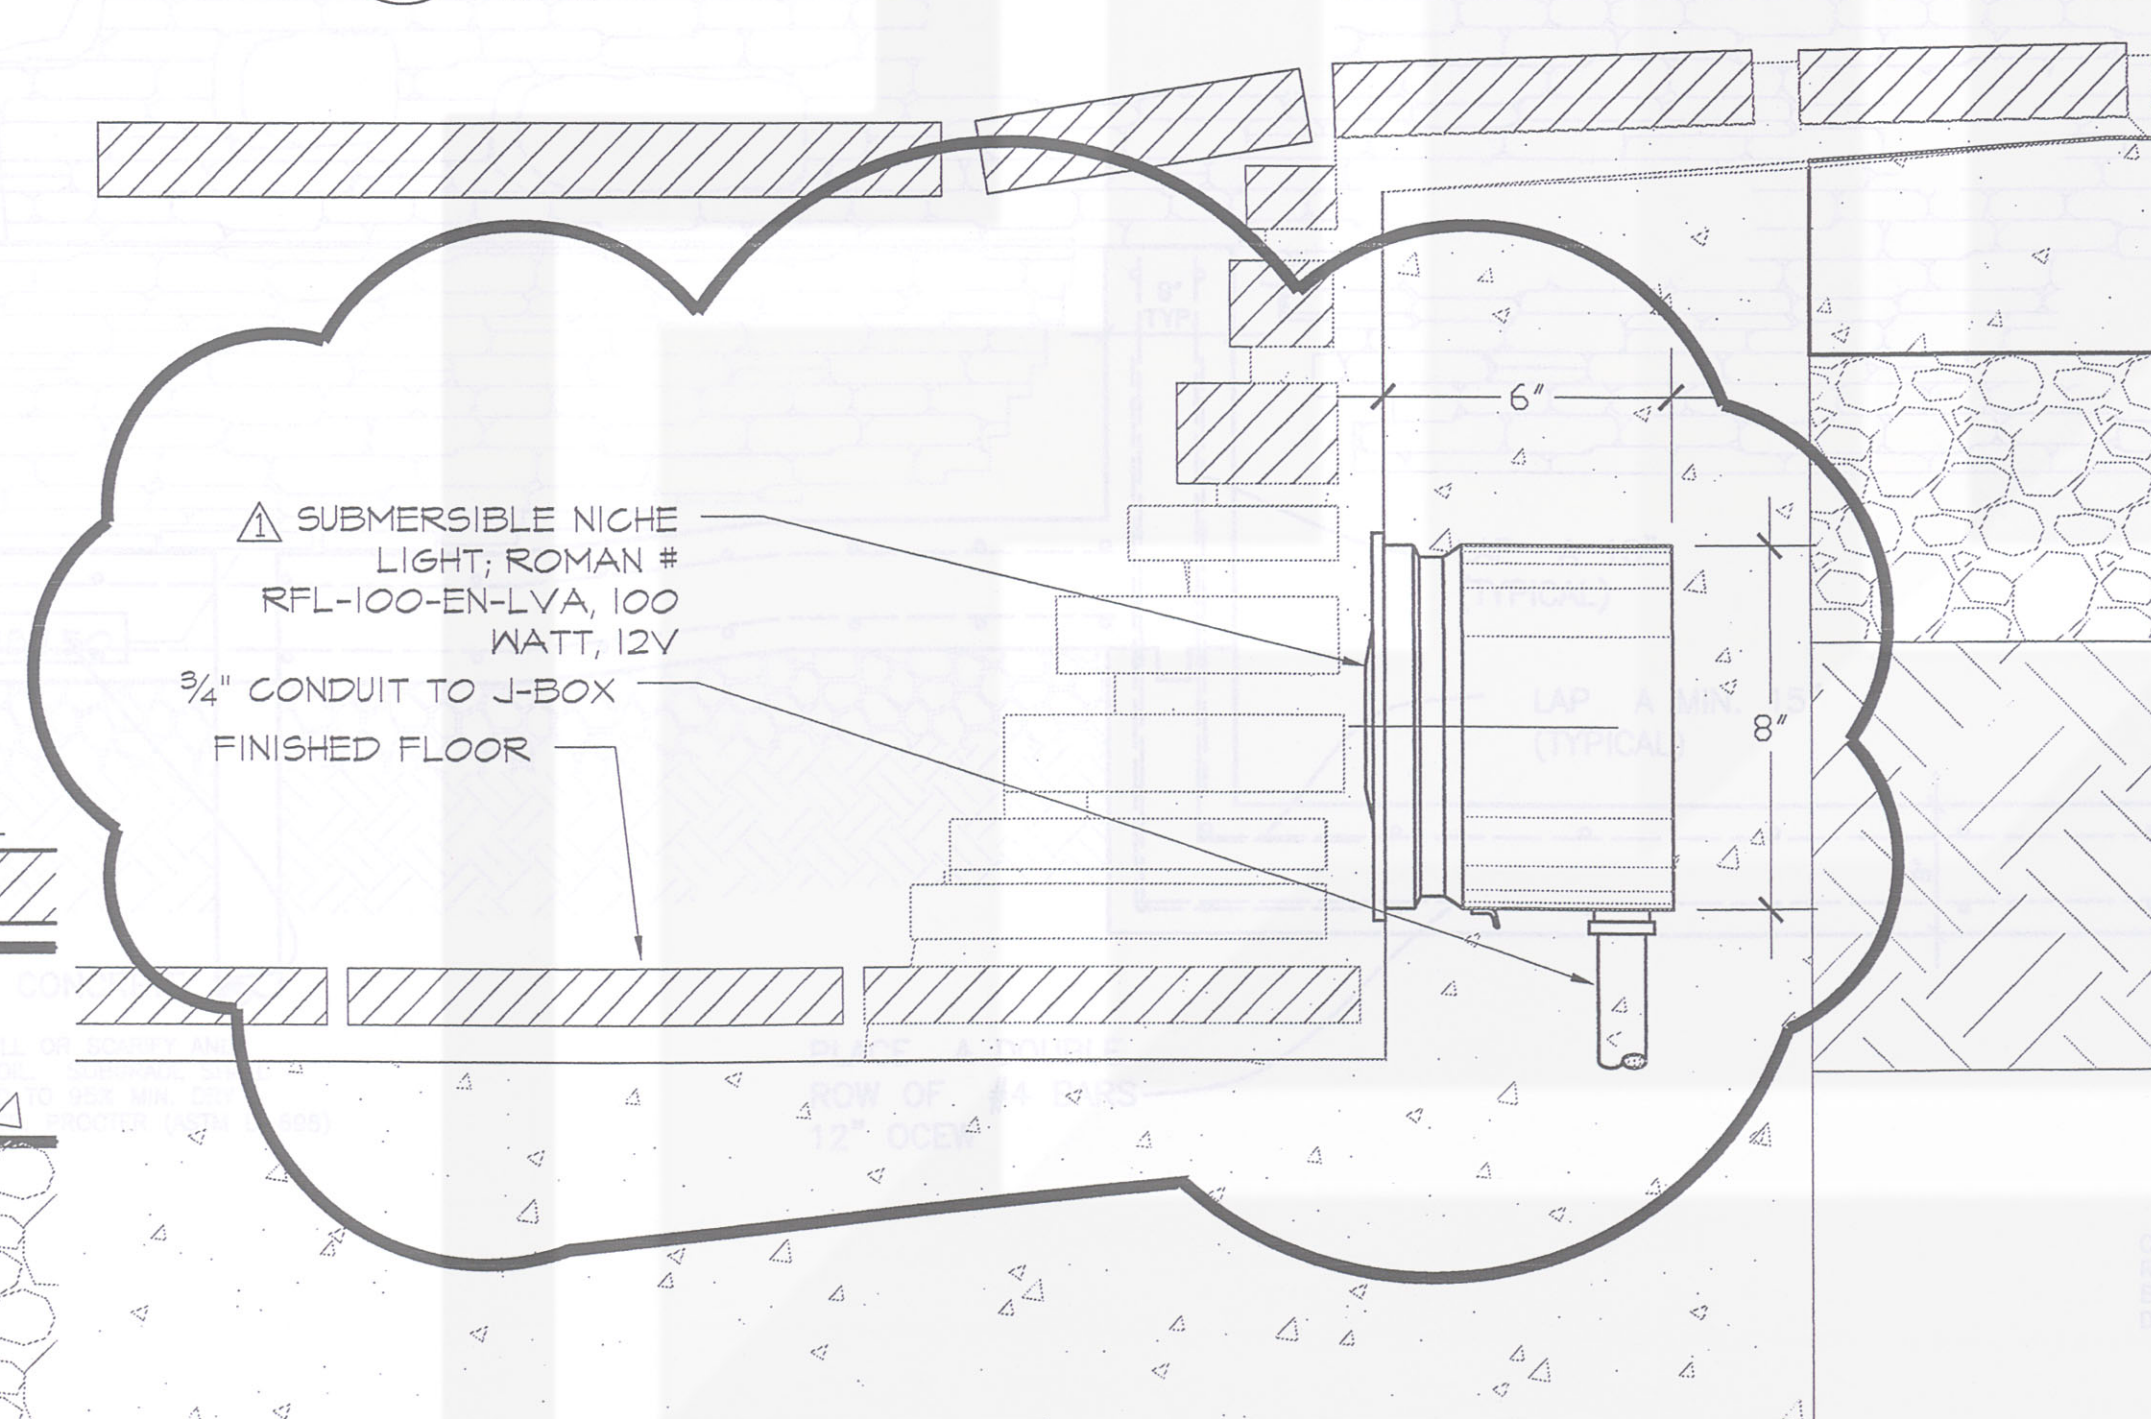


8 TYPICAL LIGHT JUNCTION BOX
SCALE: 3"=1'-0"

9 NICHE LIGHT FIXTURE
SCALE: 3"=1'-0"

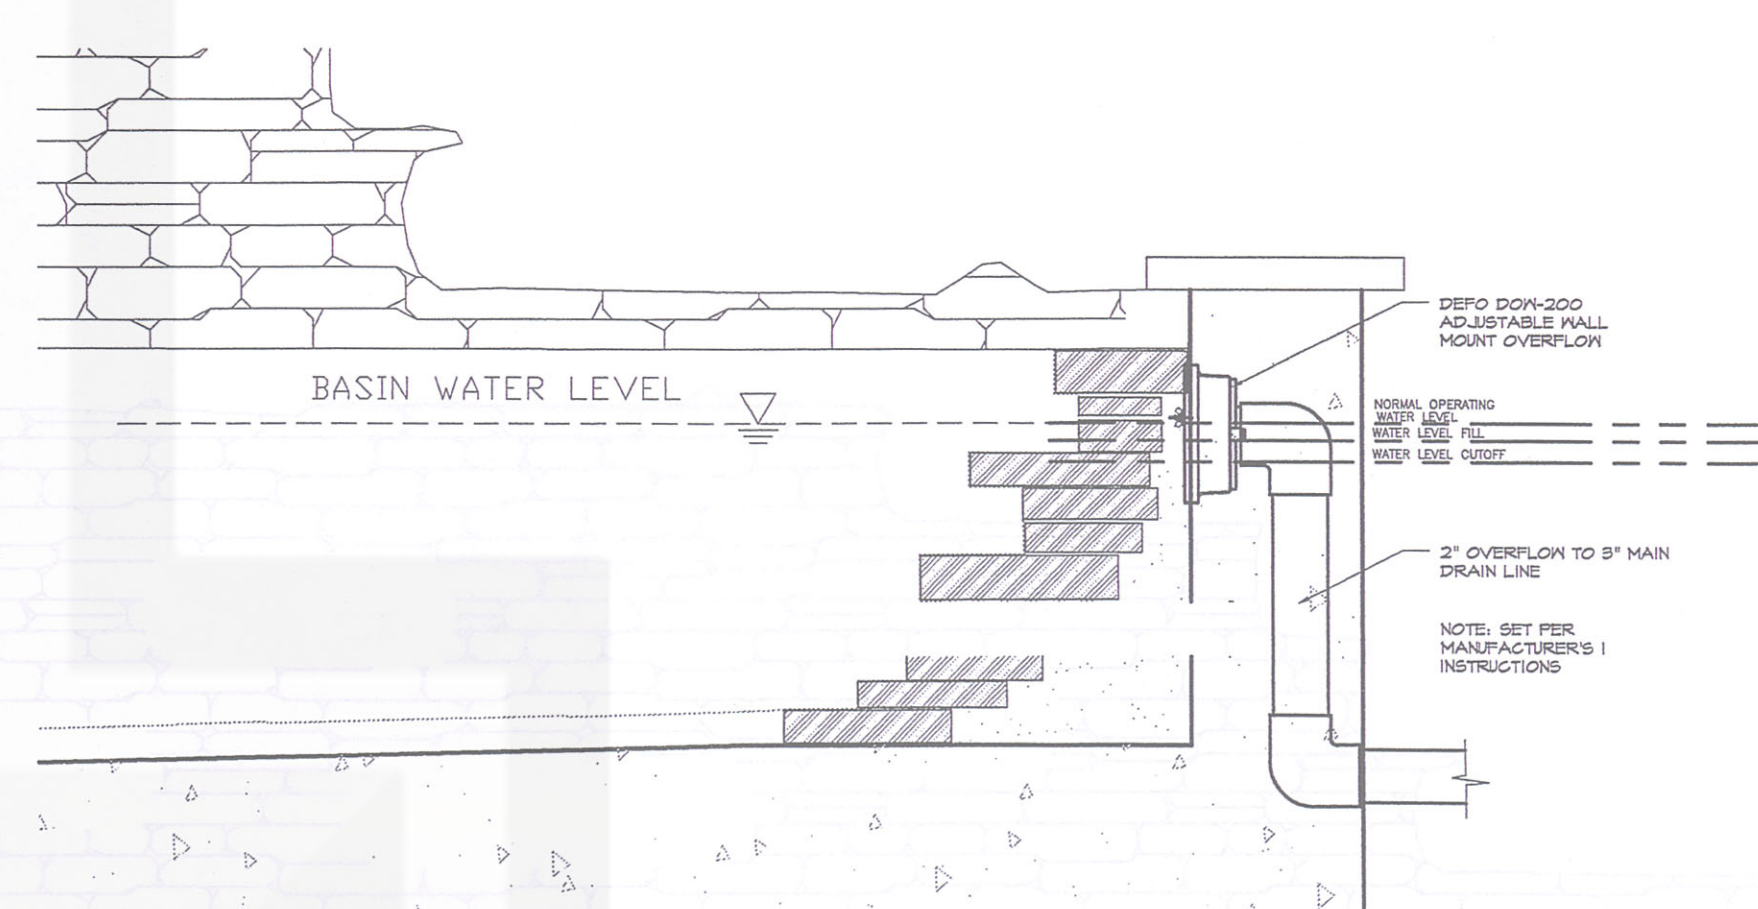

10 WALL MOUNT OVERFLOW
SCALE: NONE

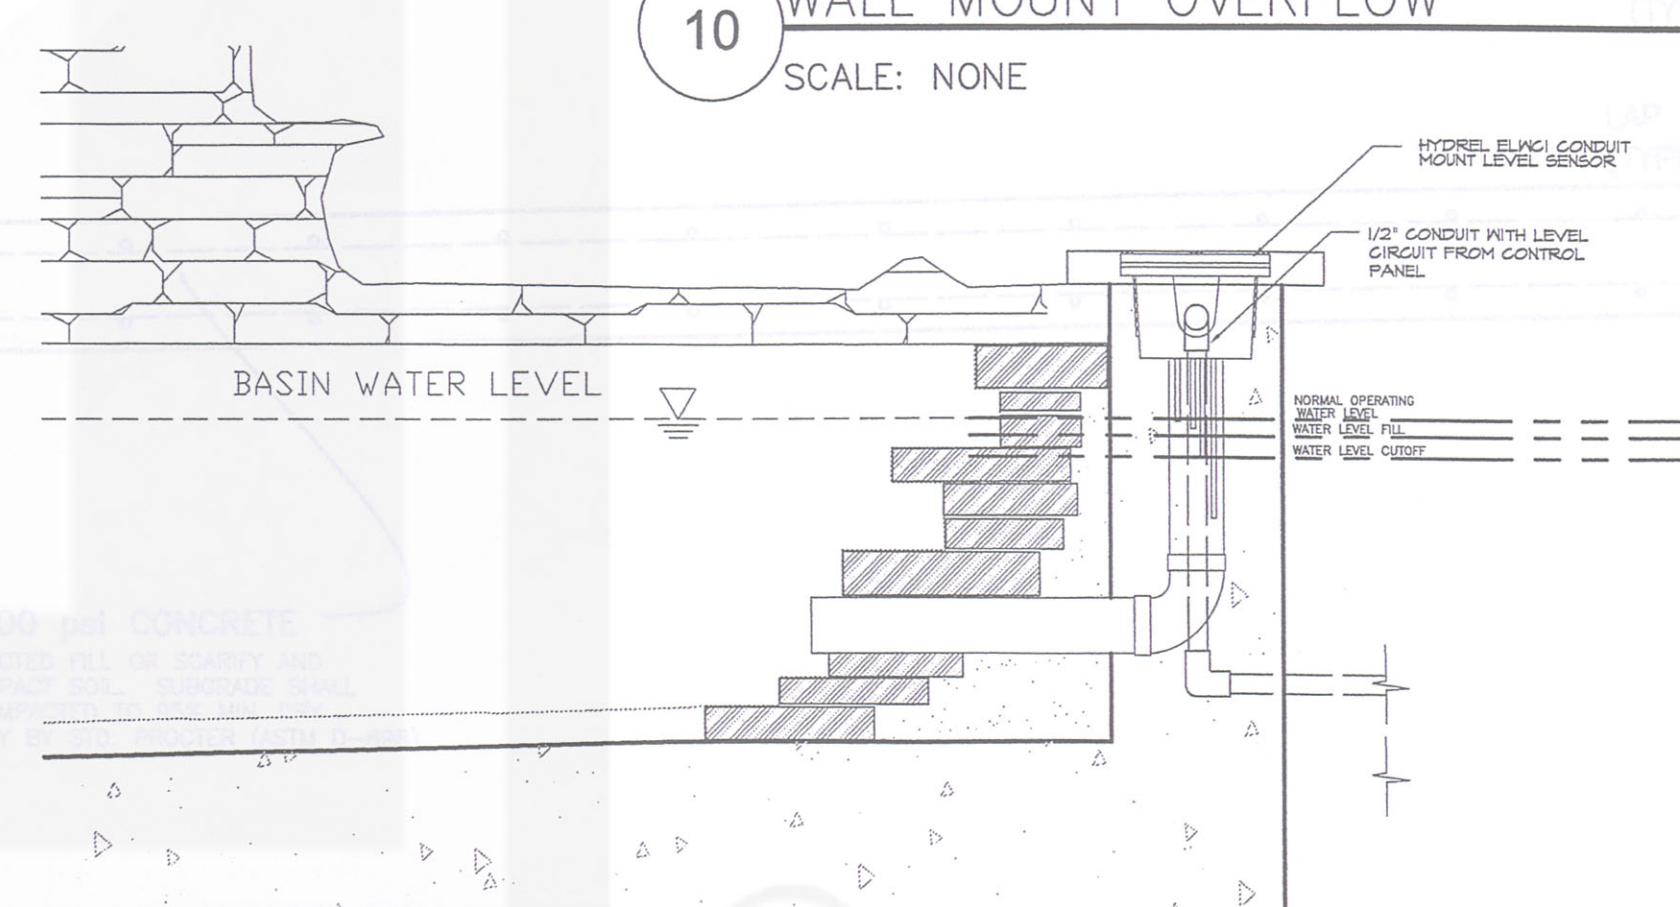

11 DECK MOUNT WATER LEVEL SENSOR
SCALE: NONE

A JOINT VENTURE OF:

ENDEAVOR

SIMONTM



Greenscape
Pump Services, Inc.

• DESIGN • CONSULTING • CONTRACTING

• SALES • SERVICE •

Headquarters
1425 Whitlock, Suite 108
Carrollton, Texas 75006
Tel: 972-446-0037 Fax: 972-446-0313

issue:
06/13/06 REVIEW/REDLINE COMMENT
07/19/06 ISSUE FOR CONSTRUCTION
10/30/06 CONSTRUCTION REVISIONS
Drawn by:
SB / GDR
Reviewed by: JB

Project:

RECORD SET

the domain
AUSTIN, TEXAS

THE BECK GROUP	
SUBMITTAL NO. 02820-07-A	
SHOP DRAWINGS	SUBMITTING FOR APPROVAL
CATALOG CUT	REVISION TOTAL
SAMPLE	SUBMITTAL FOR REFORMATION
REVIEWED ONLY AS TO GENERAL REQUIREMENTS OF THE CONTRACT DOCUMENTS. SUBCONTRACTOR TO VERIFY DIMENSIONS, QUANTITIES AND FIELD CONDITIONS FOR PROPER AND COMPLETE INSTALLATION OF THIS WORK. APPROVAL SHALL RELIEVE SUBCONTRACTOR OF ALL RESPONSIBILITY FOR ERRORS OR DEViations IN THE CONTRACT DOCUMENTS.	
JMD	DATE 11.11.06

IPRA ARCHITECTS

31000 Northwestern Suite 100
Farmington Hills Michigan 48334-2585
phone 248 737 0180 fax 248 737 9161

SHEET TITLE: SHADY GROVE
WATER FEATURE DETAILS

Sheet No.

11 133