



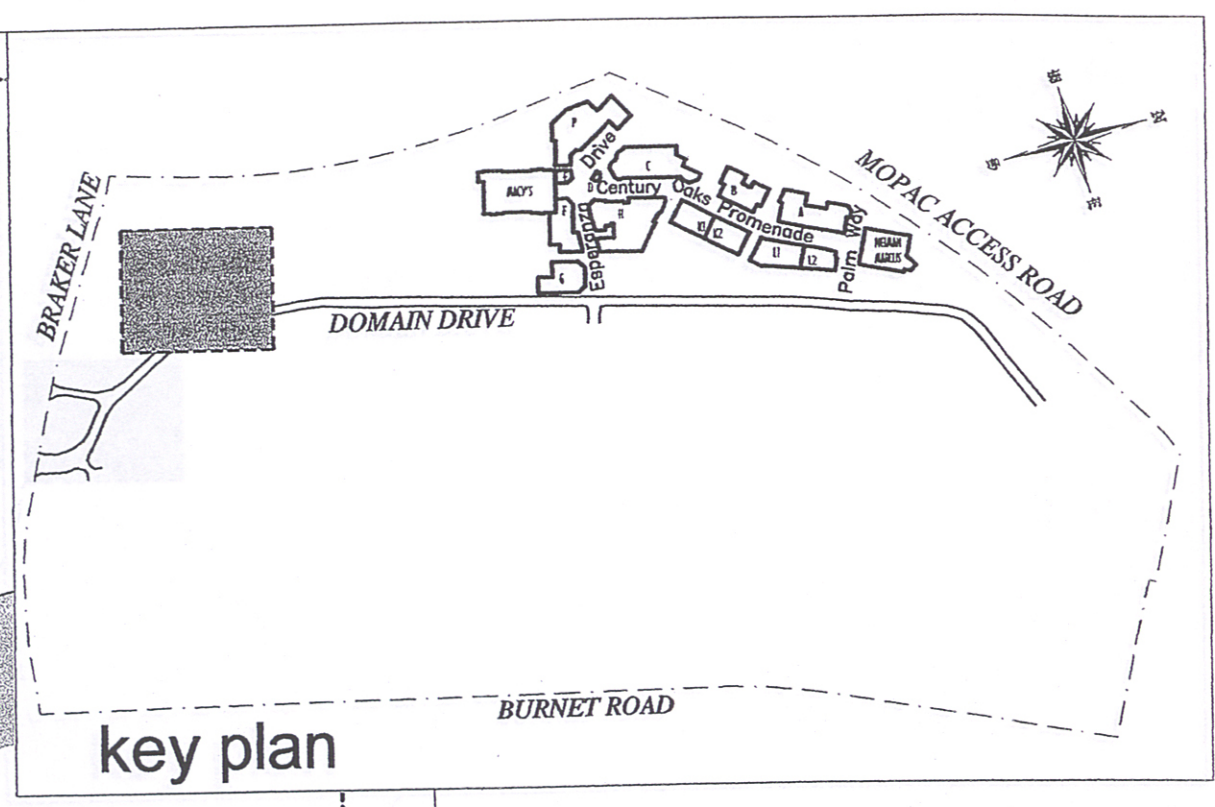


key plan

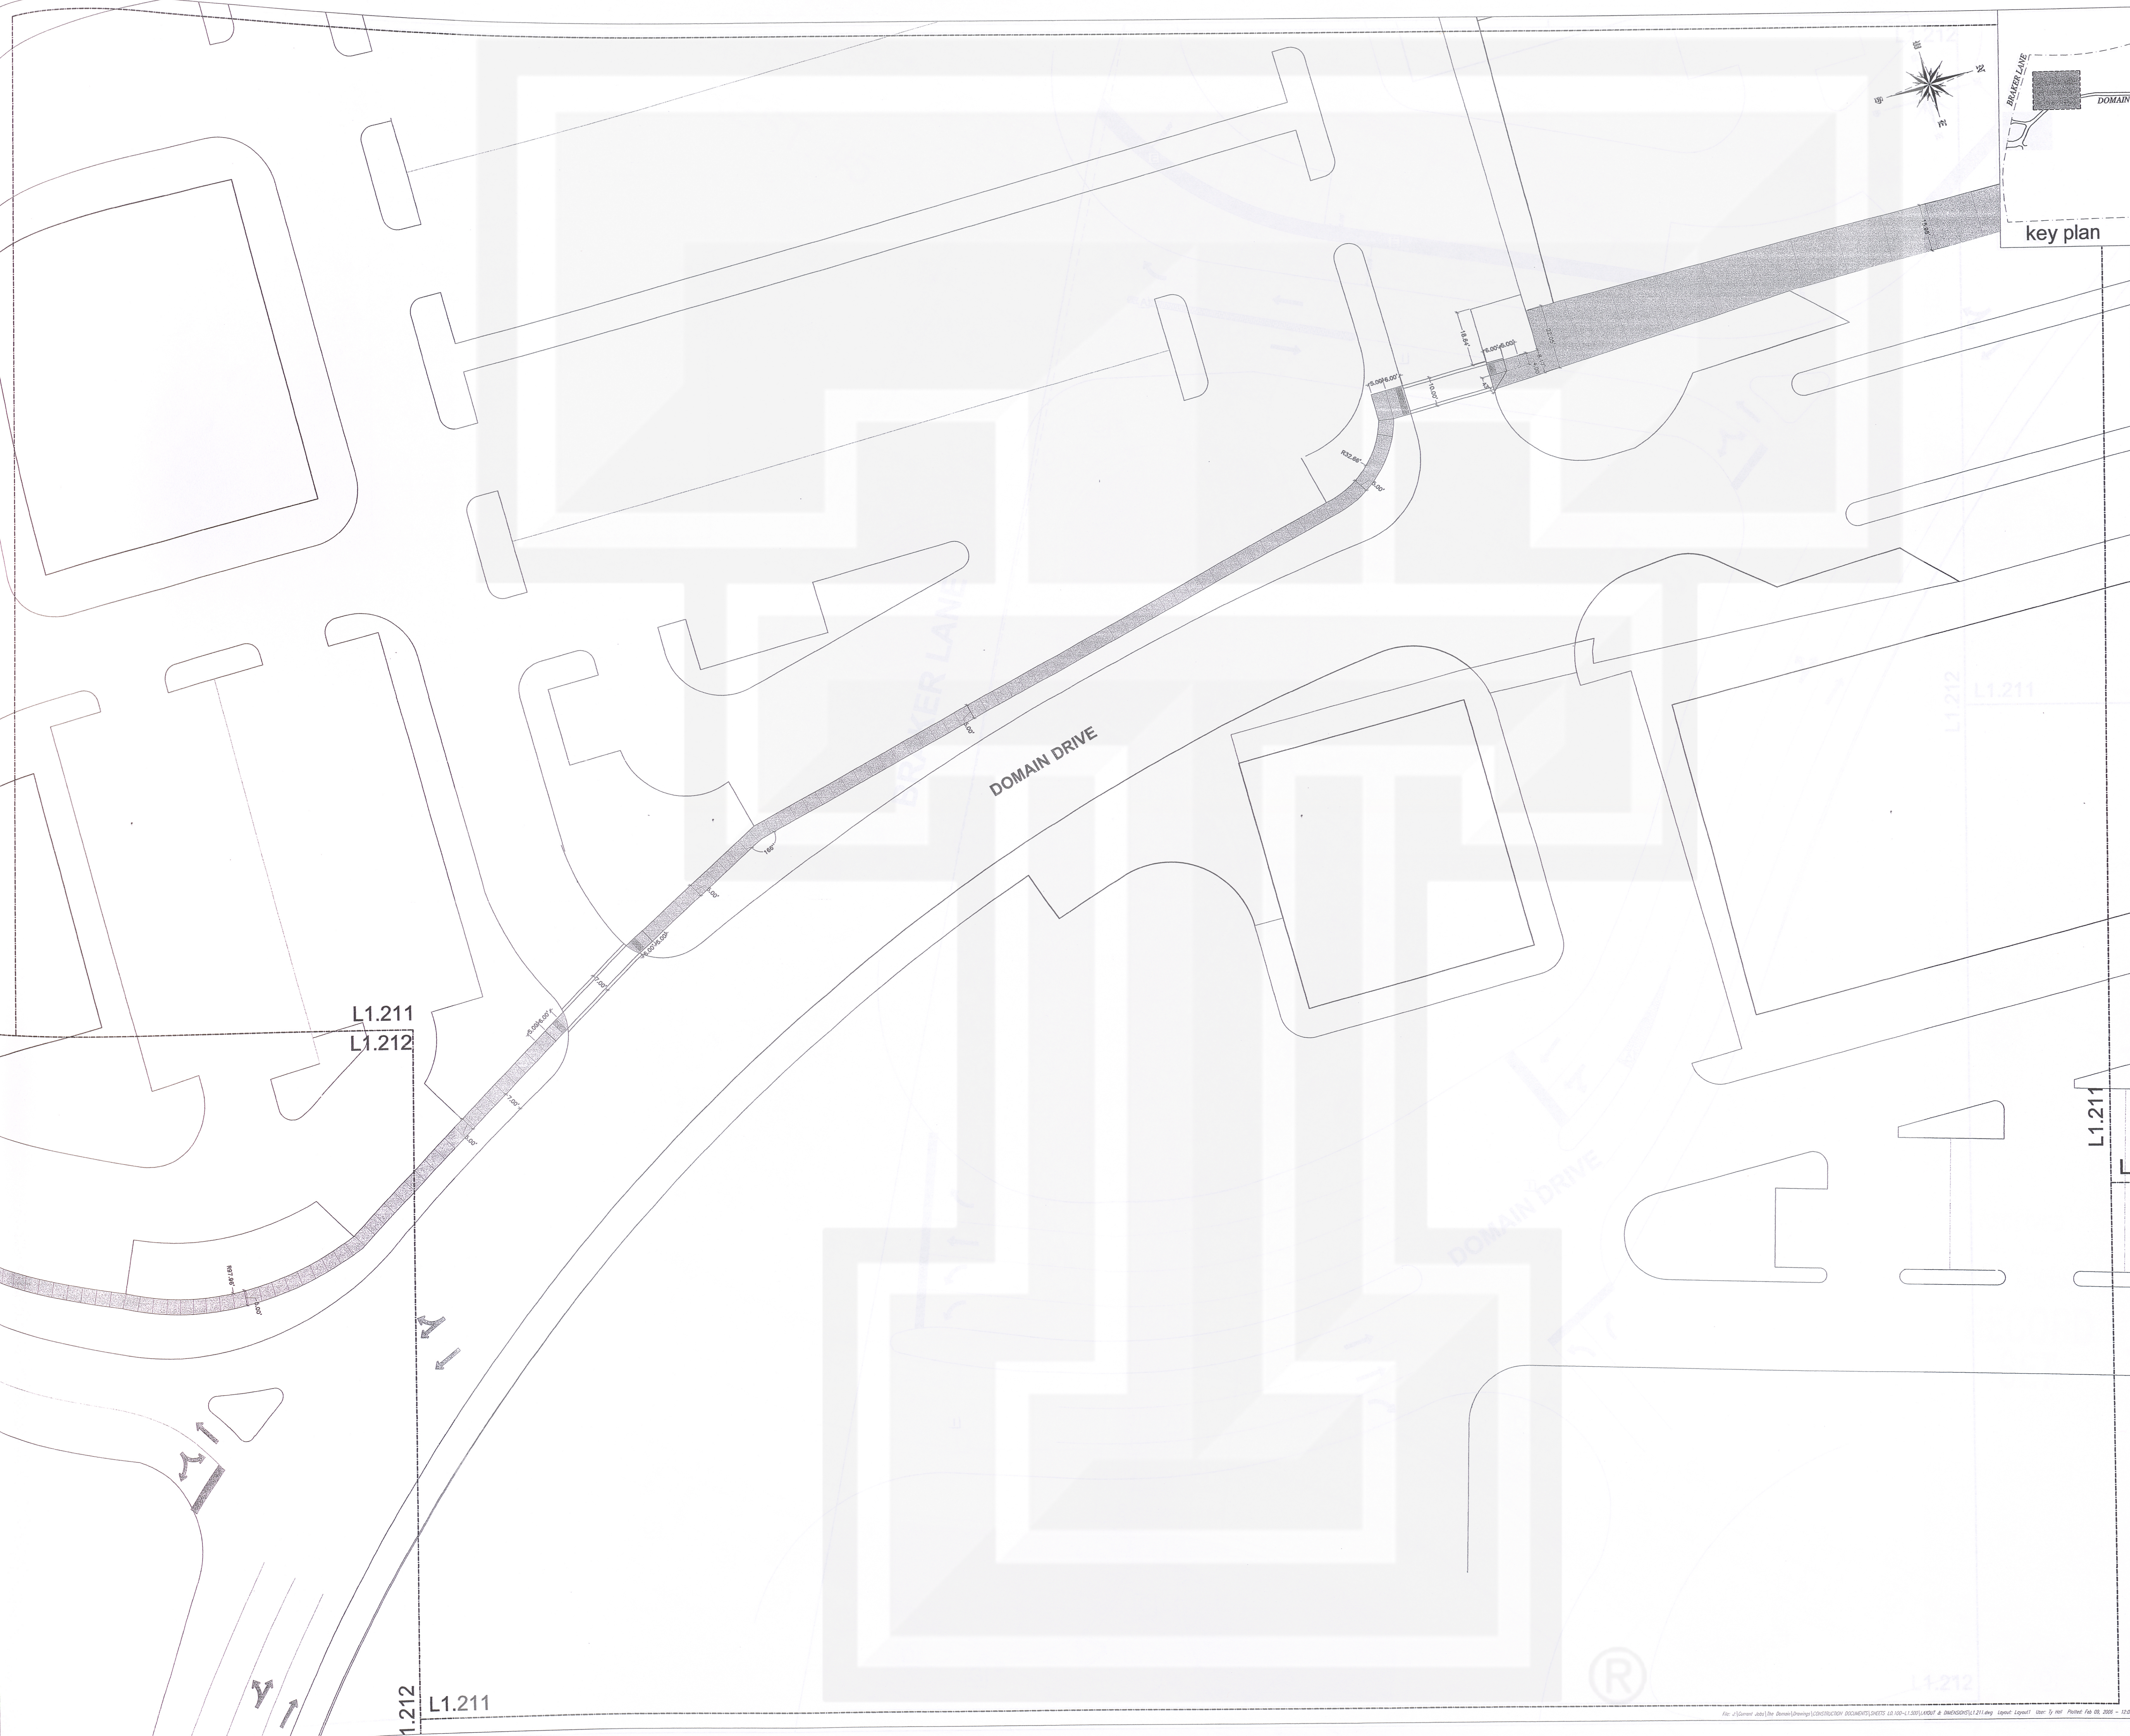

ENDREOR
REAL ESTATE GROUP

A JOINT VENTURE OF:
SIMON

J. Robert Anderson, FASLA
landscape architects, austin, texas.
3718 MANCHACA ROAD
AUSTIN, TEXAS 78704
512.440.1049
440-8000 FAX

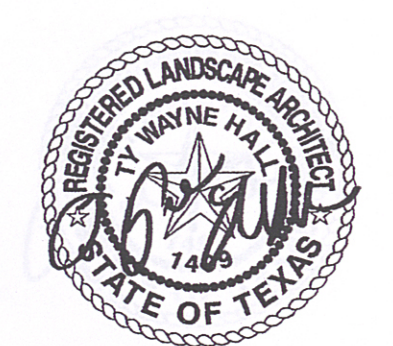

02/10/06
0 10' 20' 40' 60'
SCALE: 1" = 20'

Project:

the domain
AUSTIN, TEXAS

RECEIVED
FEB 15 2006
BY BECK - AUSTIN
RECORD SET
JPRA ARCHITECTS
31000 Northwestern Suite 100
Farmingdale, NY 11735
Phone: 248.737.0180 Fax: 248.737.9161

SHEET TITLE:
LAYOUT & DIMENSIONS PLAN
Sheet No.
L1.211