


1 2 3 4 5 6 7 8 9 10 11 12 13 14 15 16 17

R
Q
P
N
M
L
K
J
H
G
F
E
D
C
B
A

R
Q
P
N
M
L
K
J
H
G
F
E
D
C
B
A

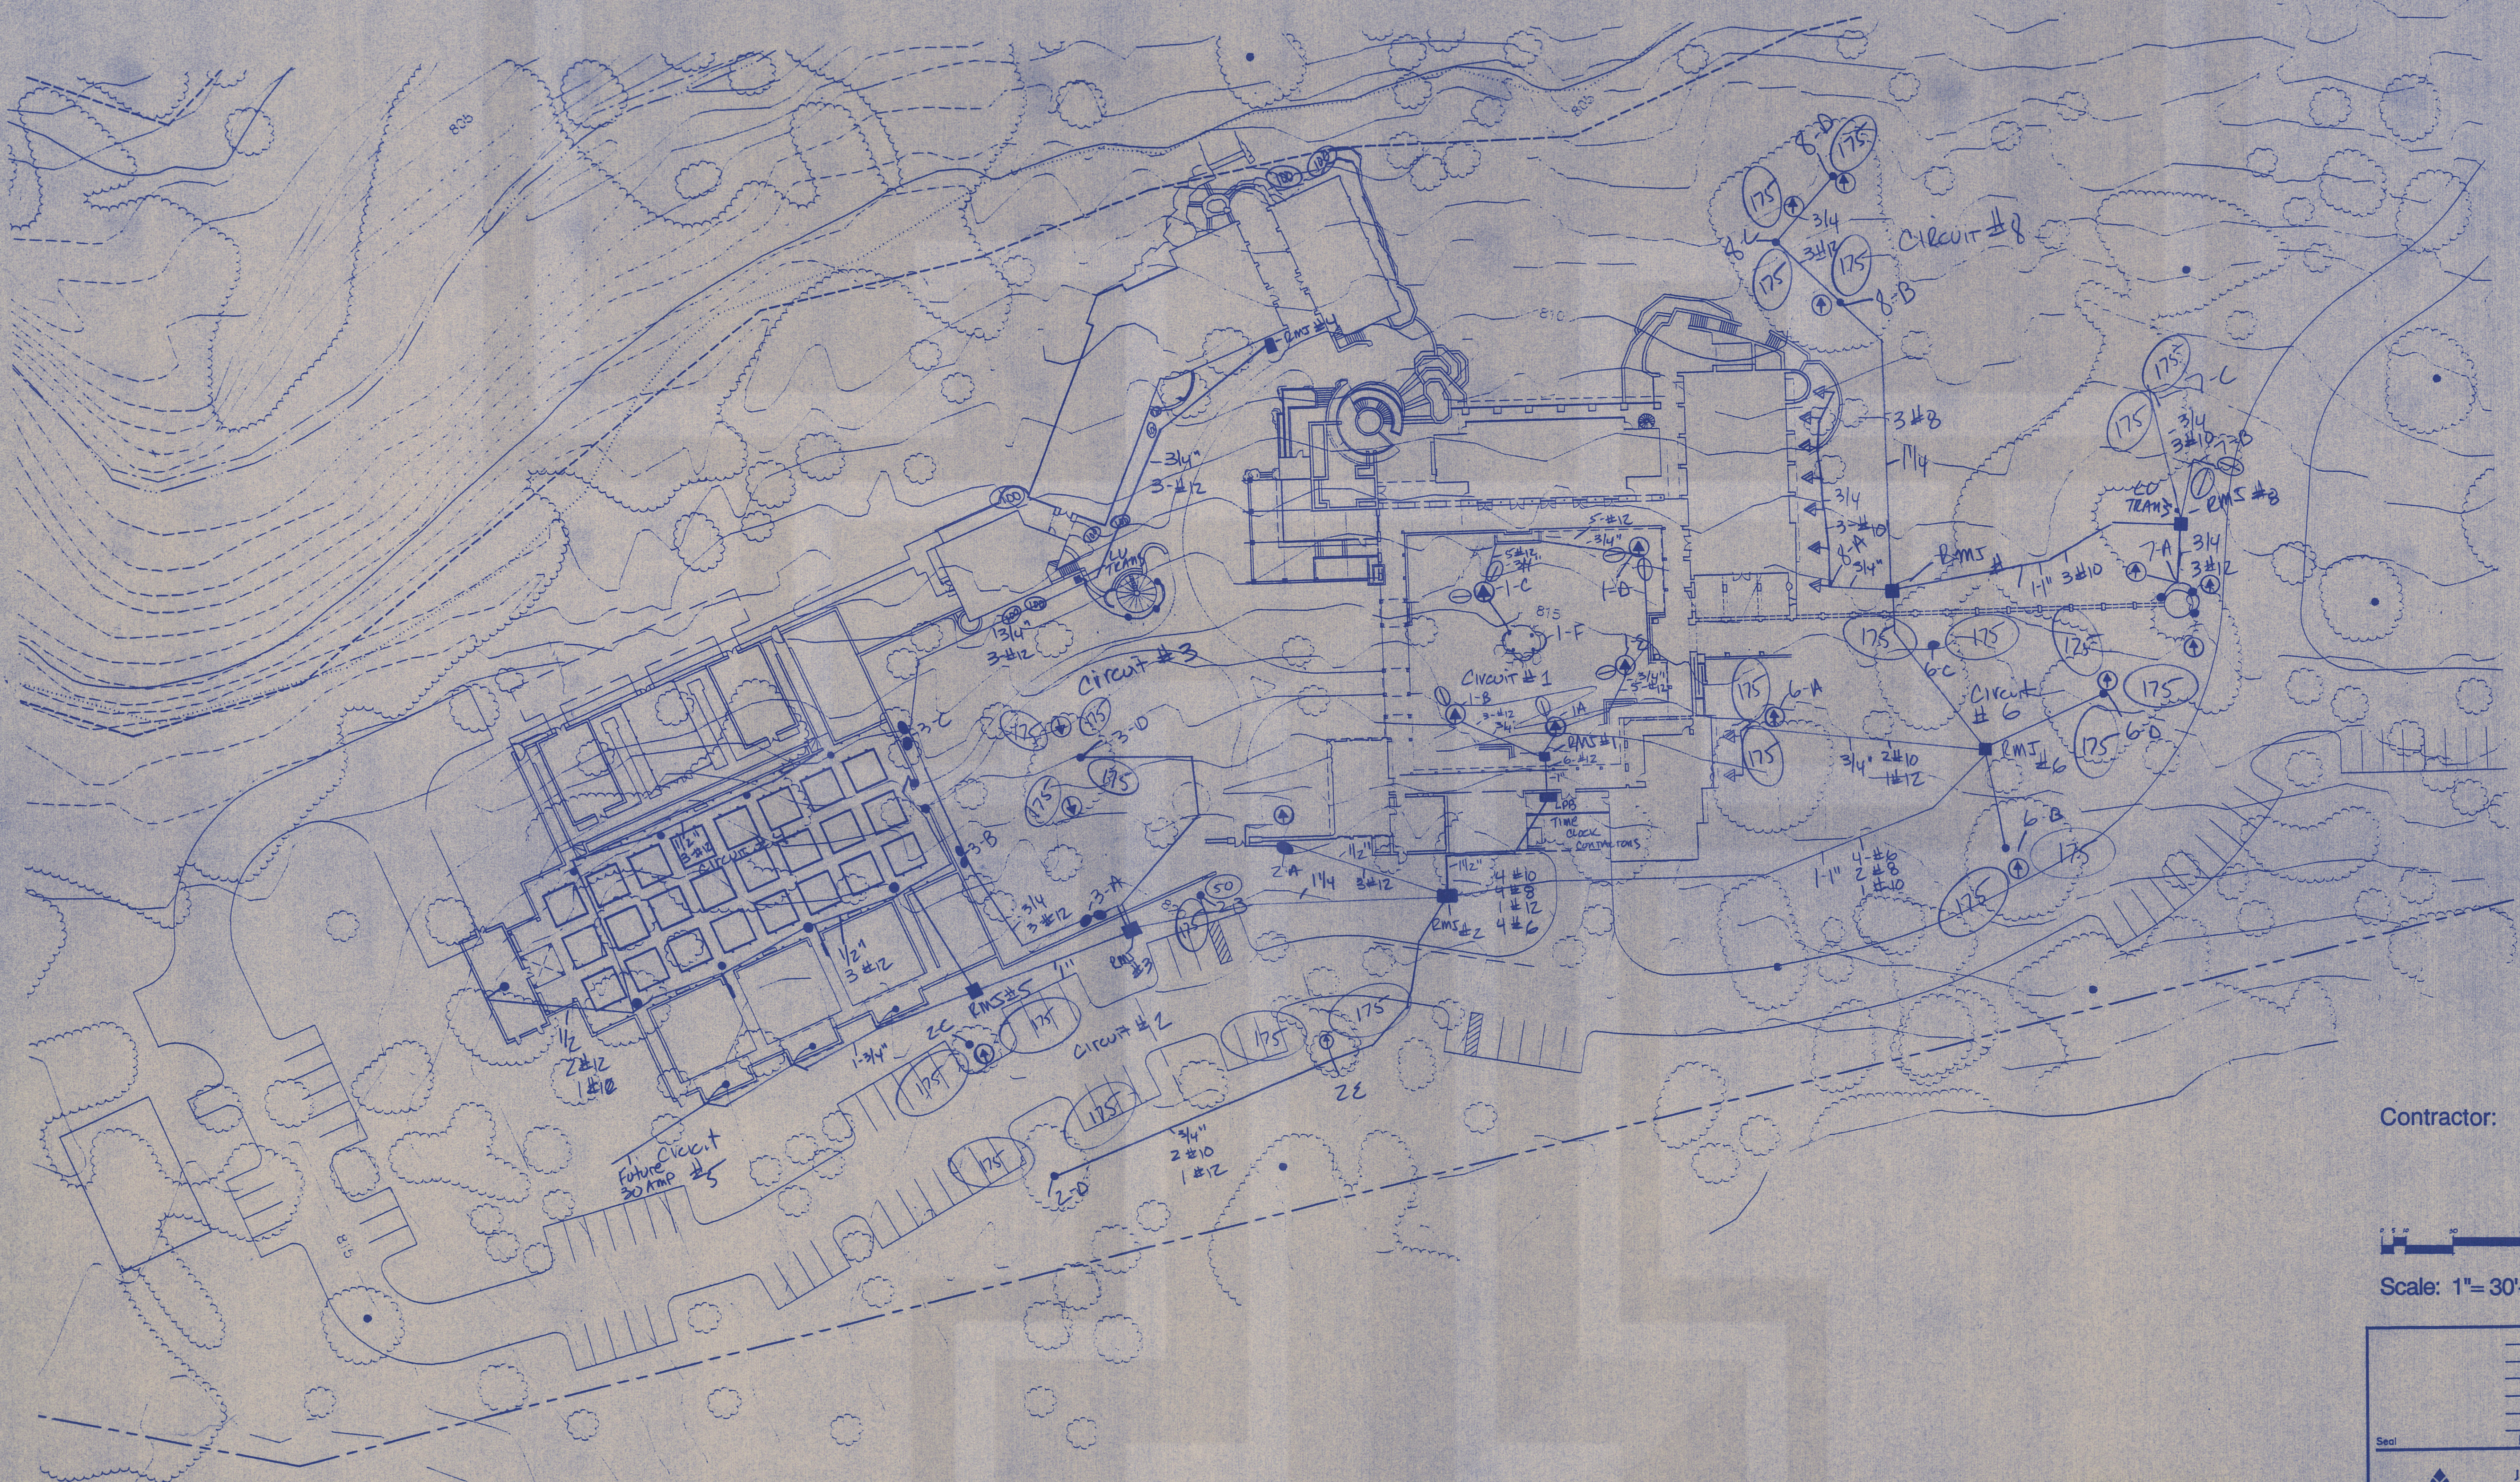

Contractor: Nightscapes
703 Westbrook Dr.
Austin, Texas 78746
Phone: (512) 327-5937
Contact: Dunton Taylor

Scale: 1" = 30'-0"

North

OFFICE SET
1/10/96

Seal		Issued / Revised	
		J. ROBERT ANDERSON, ASLA	
		Landscape Architect 1715 S. Capital of Texas Highway Suite 105 Austin, Texas 78746	
Project Name		Project No.	
LANDSCAPE LIGHTING AS-BUILT PLAN		Drawn	
Drawing Title		Drawing No. LL-1	
		1 of 1	

1 2 3 4 5 6 7 8 9 10 11 12 13 14 15 16 17