


**Typical Score Pattern Rule of Thumb for K Paving:**

- Score patterns to be 45 degrees off the building
- Broom finish runs parallel to one score pattern; contractor to choose direction, keeping consistent within an area. For example, at the four corners intersection, all four sections should have an identical broom finish direction.

If necessary, Contact Landscape Architect for clarification.

The Domain, Austin, TX  
10/20/04

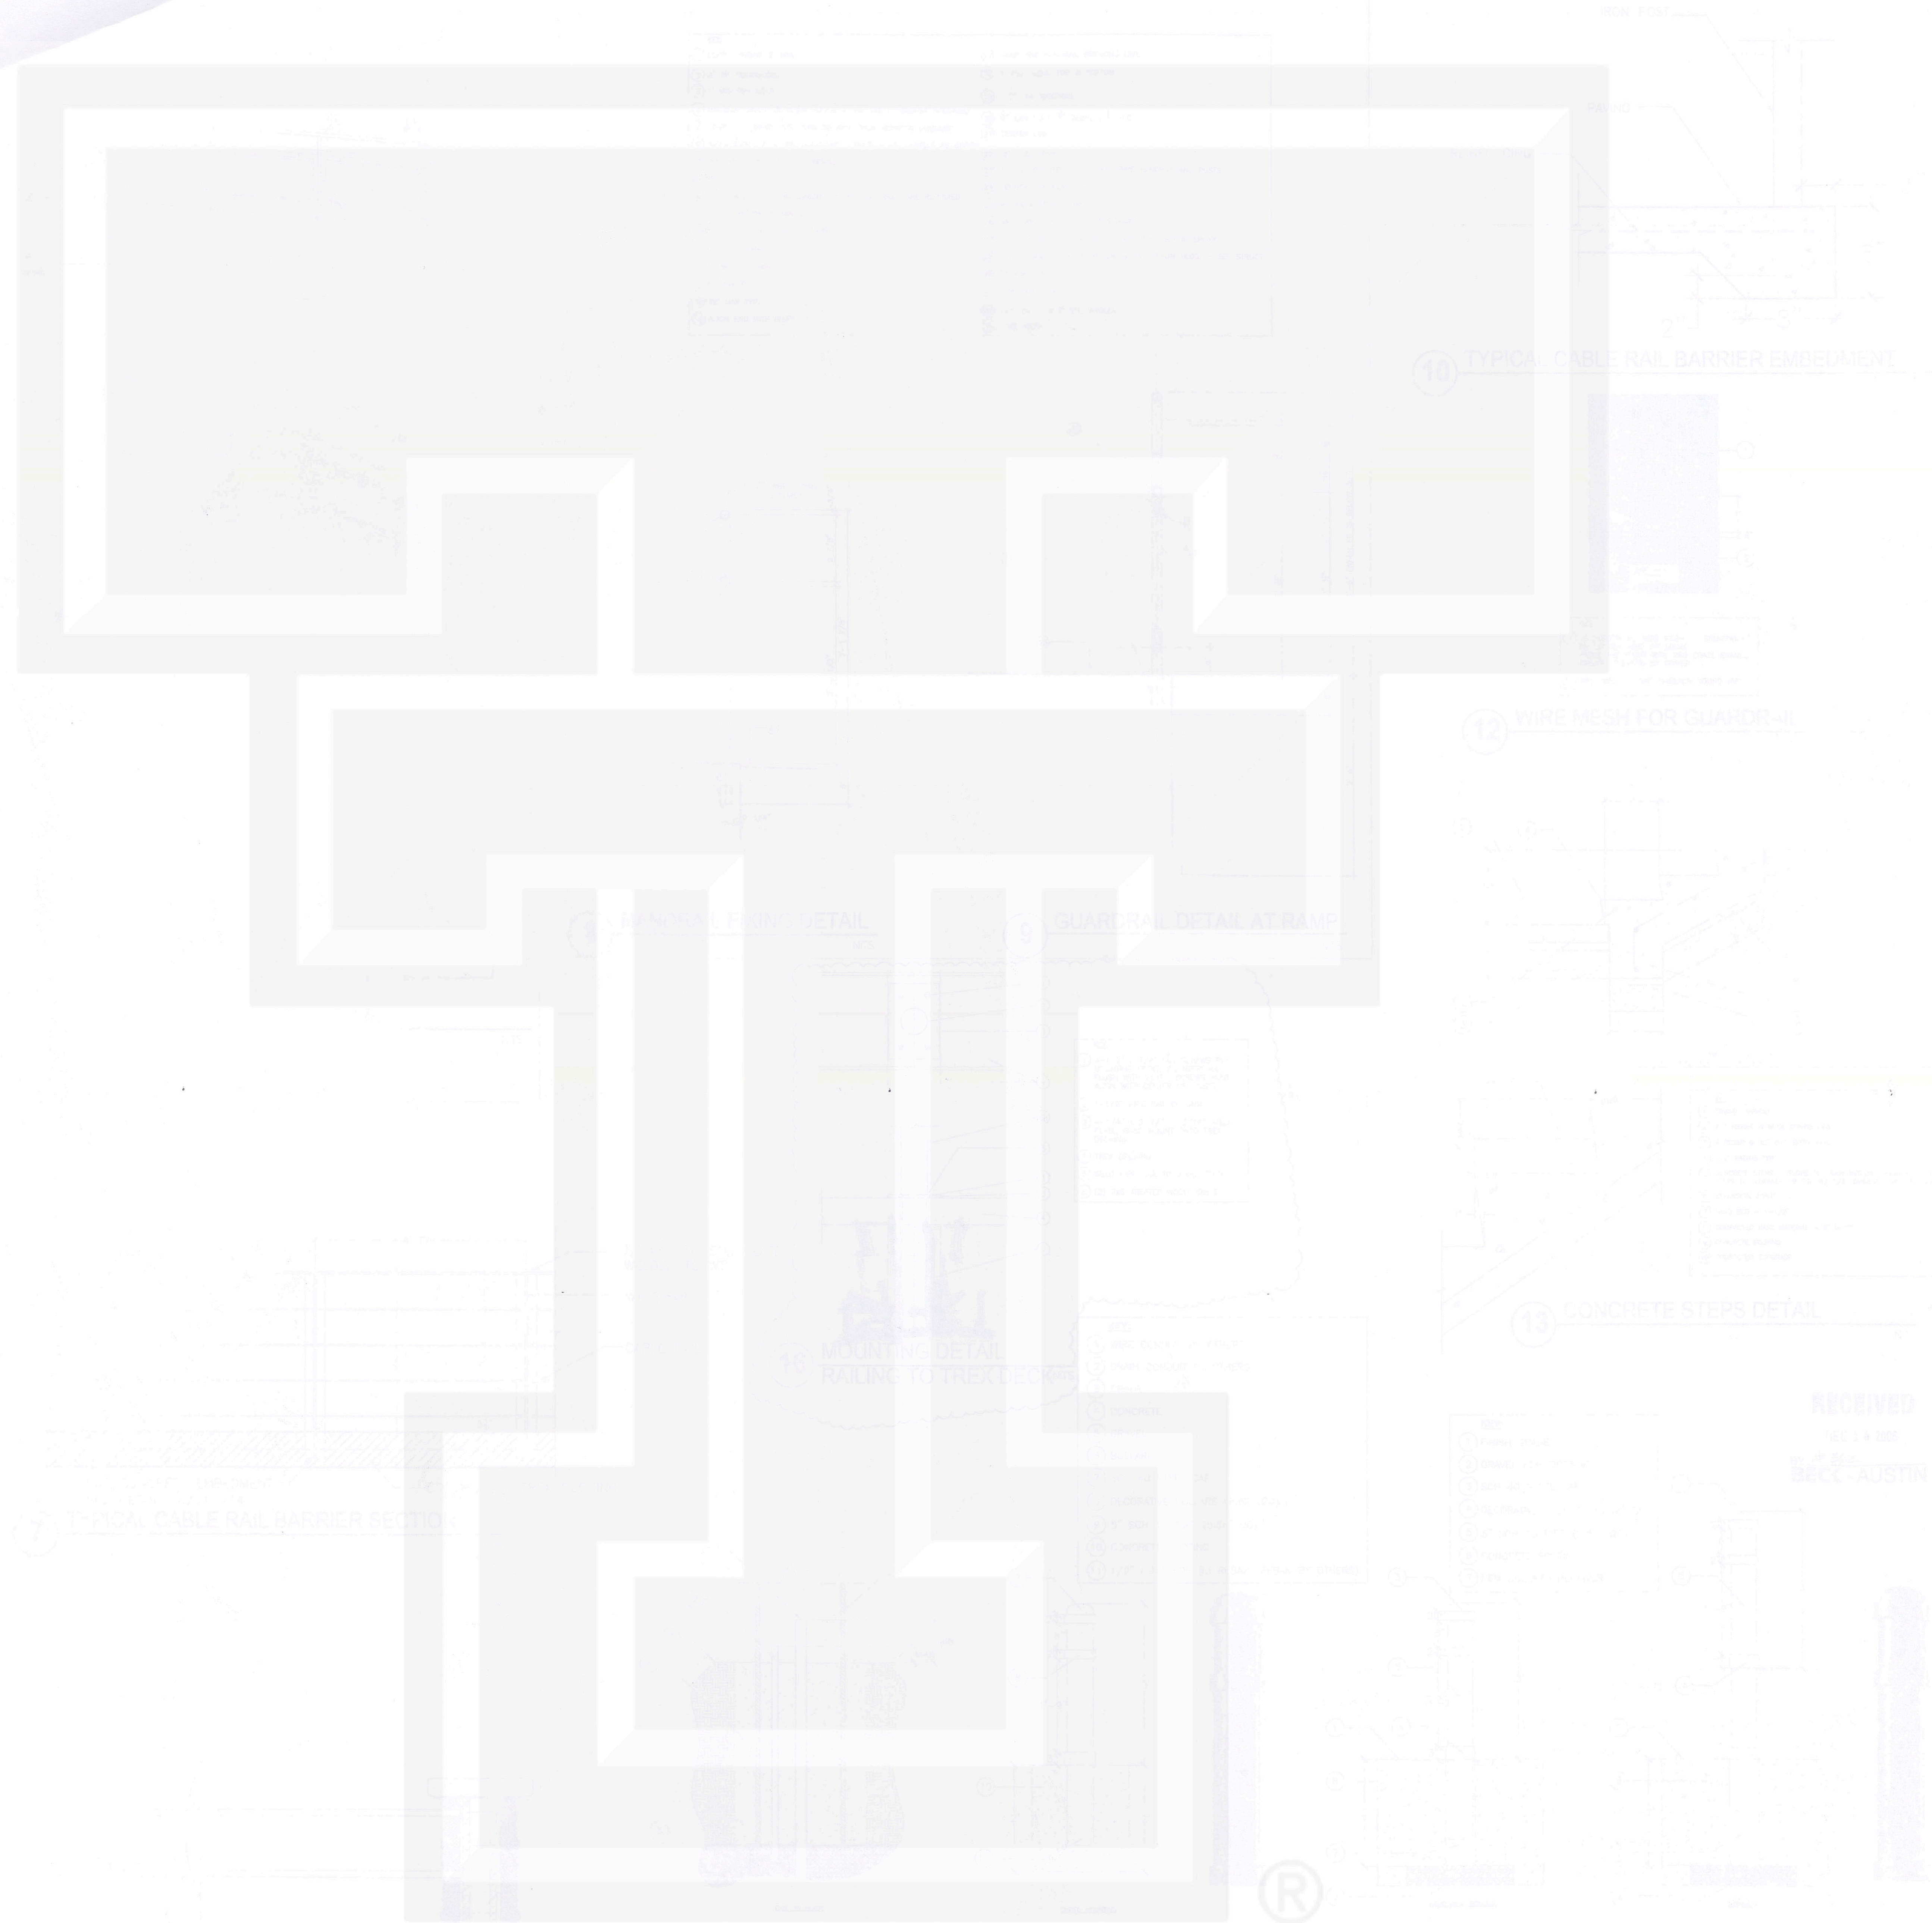

10 TYPICAL CABLE RAIL BARRIER EMBEDMENT

12 WIRE MESH FOR GUARDRAIL

13 CONCRETE STEPS DETAIL

16 MOUNTING DETAIL RAILING TO TREX DECK

14 CLASSIC BOLLARD - EMBEDDED

15 CLASSIC BOLLARD - REMOVABLE

RECEIVED  
10/20/04  
10/20/04  
BECC-AUSTIN

RECORD SET