


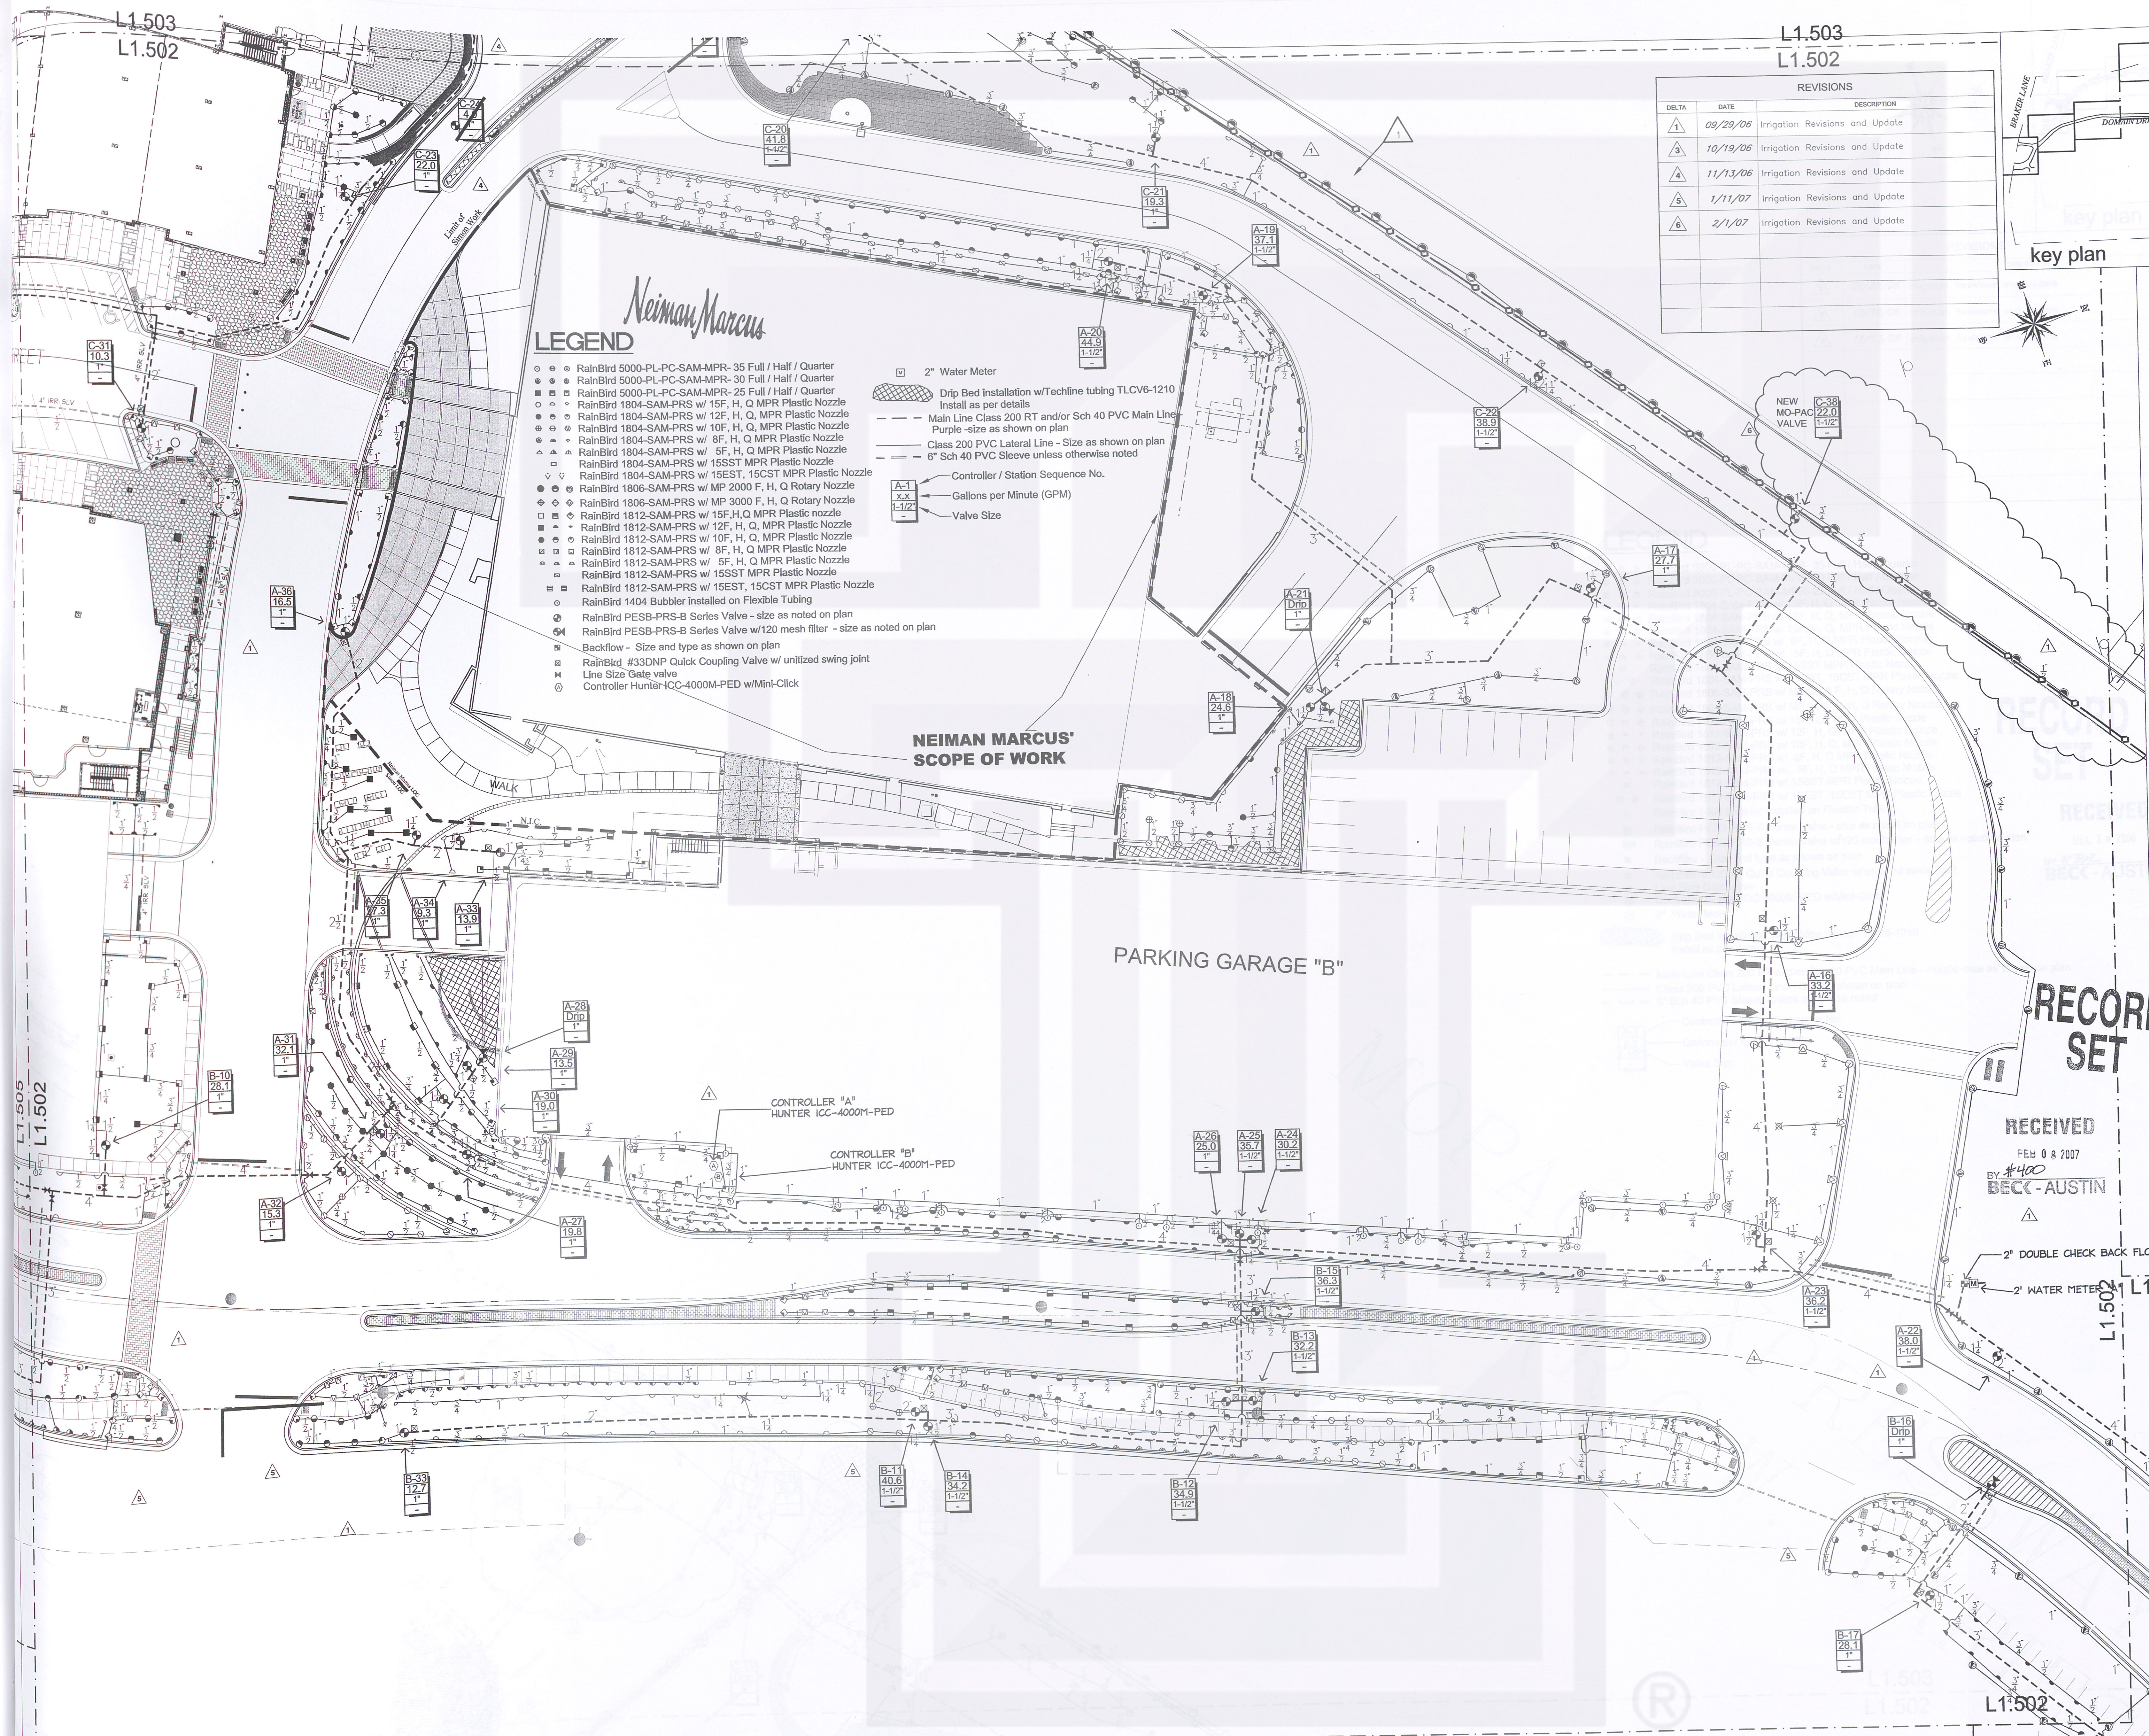

Neiman Marcus


NEIMAN MARCUS' SCOPE OF WORK

PARKING GARAGE "B"

LEGEND

- RainBird 5000-PL-PC-SAM-MPR-35 Full / Half / Quarter
- RainBird 5000-PL-PC-SAM-MPR-25 Full / Half / Quarter
- RainBird 1804-SAM-PRS w/ 15F, H, Q, MPR Plastic Nozzle
- RainBird 1804-SAM-PRS w/ 12F, H, Q, MPR Plastic Nozzle
- RainBird 1804-SAM-PRS w/ 10F, H, Q, MPR Plastic Nozzle
- RainBird 1804-SAM-PRS w/ 8F, H, Q, MPR Plastic Nozzle
- RainBird 1804-SAM-PRS w/ 5F, H, Q, MPR Plastic Nozzle
- RainBird 1804-SAM-PRS w/ 15EST, 15CST MPR Plastic Nozzle
- RainBird 1806-SAM-PRS w/ MP 3000 F, H, Q Rotary Nozzle
- RainBird 1812-SAM-PRS w/ 15F, H, Q, MPR Plastic Nozzle
- RainBird 1812-SAM-PRS w/ 12F, H, Q, MPR Plastic Nozzle
- RainBird 1812-SAM-PRS w/ 10F, H, Q, MPR Plastic Nozzle
- RainBird 1812-SAM-PRS w/ 8F, H, Q, MPR Plastic Nozzle
- RainBird 1812-SAM-PRS w/ 5F, H, Q, MPR Plastic Nozzle
- RainBird 1812-SAM-PRS w/ 15EST, 15CST MPR Plastic Nozzle
- RainBird 1404 Bubbler installed on Flexible Tubing
- RainBird PESB-PRS-B Series Valve - size as noted on plan
- RainBird PESB-PRS-B Series Valve w/120 mesh filter - size as noted on plan
- Backflow - Size and type as shown on plan
- RainBird #33DNP Quick Coupling Valve w/ unitized swing joint
- Line Size Gate valve
- Controller Hunter-ICC-4000M-PED w/Mini-Click
- 2" Water Meter
- ▨ Drip Bed Installation w/Techline tubing TLCV6-1210
- Main Line Class 200 RT and/or Sch 40 PVC Main Line
- Purple - size as shown on plan
- Class 200 PVC Lateral Line - Size as shown on plan
- 6" Sch 40 PVC Sleeve unless otherwise noted
- A-1 Controller / Station Sequence No.
- X-X Gallons per Minute (GPM)
- Valve Size

| REVISIONS |          |                                 |
|-----------|----------|---------------------------------|
| DELTA     | DATE     | DESCRIPTION                     |
| 1         | 09/29/06 | Irrigation Revisions and Update |
| 2         | 10/19/06 | Irrigation Revisions and Update |
| 3         | 11/13/06 | Irrigation Revisions and Update |
| 4         | 1/11/07  | Irrigation Revisions and Update |
| 5         | 2/1/07   | Irrigation Revisions and Update |

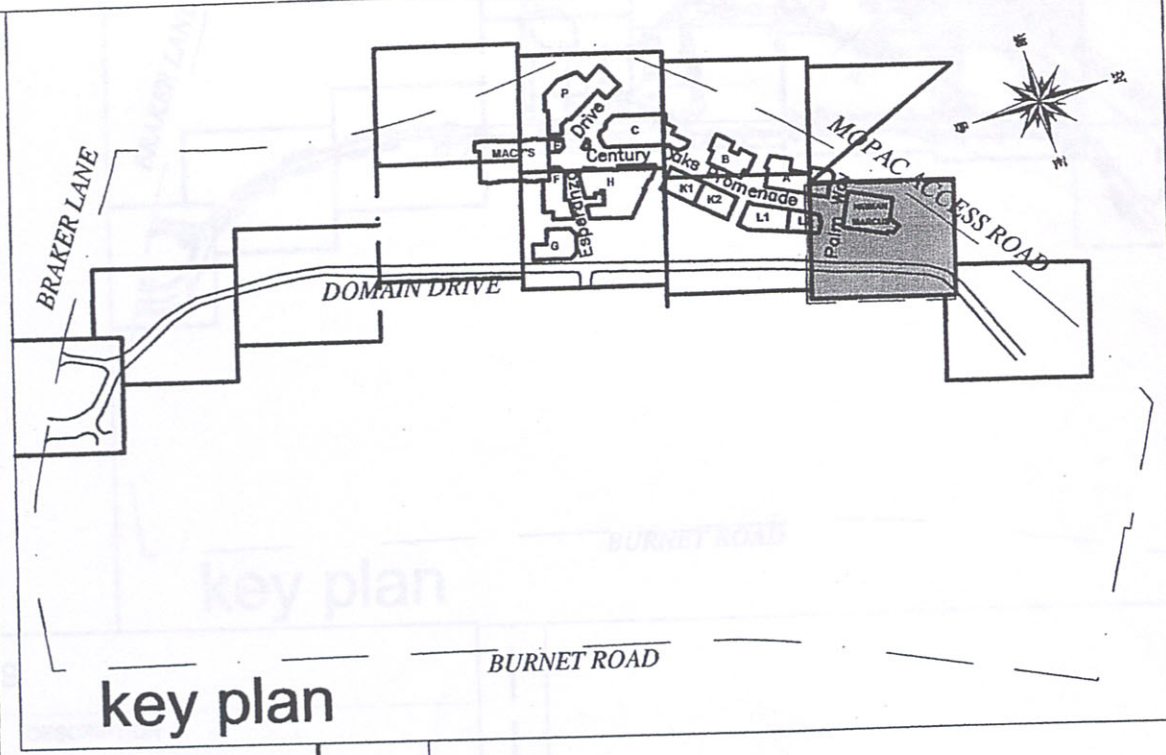

A JOINT VENTURE OF:  
**SIMON** | **ENDEAVOR**  
REAL ESTATE GROUP

J. Robert Anderson, FASLA  
Landscape Architect, Austin, Texas  
5715 MANHACCA ROAD  
AUSTIN, TEXAS 78744  
512.446.1345  
445.800.FAX



DATE: 1/15/05 SCALE: 1" = 20'  
0 10' 20' 40' 60'

RECORD SET

RECEIVED  
FEB 08 2007  
BY #400  
BECK - AUSTIN

2" DOUBLE CHECK BACK FLOW  
2" WATER METER

the domain  
AUSTIN, TEXAS

JPR ARCHITECTS  
31000 Northwest Blvd, Suite 100  
Farmingdale, Texas 75438-2585  
phone: 281.737.0180 fax: 281.737.9161

SHEET TITLE:  
**IRRIGATION PLAN**  
Sheet No.  
**L1.502**