


2

1"=50'

X

44.20 gpm

IRRIGATION SYSTEM LAYOUT IS DIAGRAMMATIC
EXACT LOCATION OF PIPING, HEADS AND
VALVES SHALL BE ESTABLISHED IN THE
FIELD AT THE TIME OF INSTALLATION.

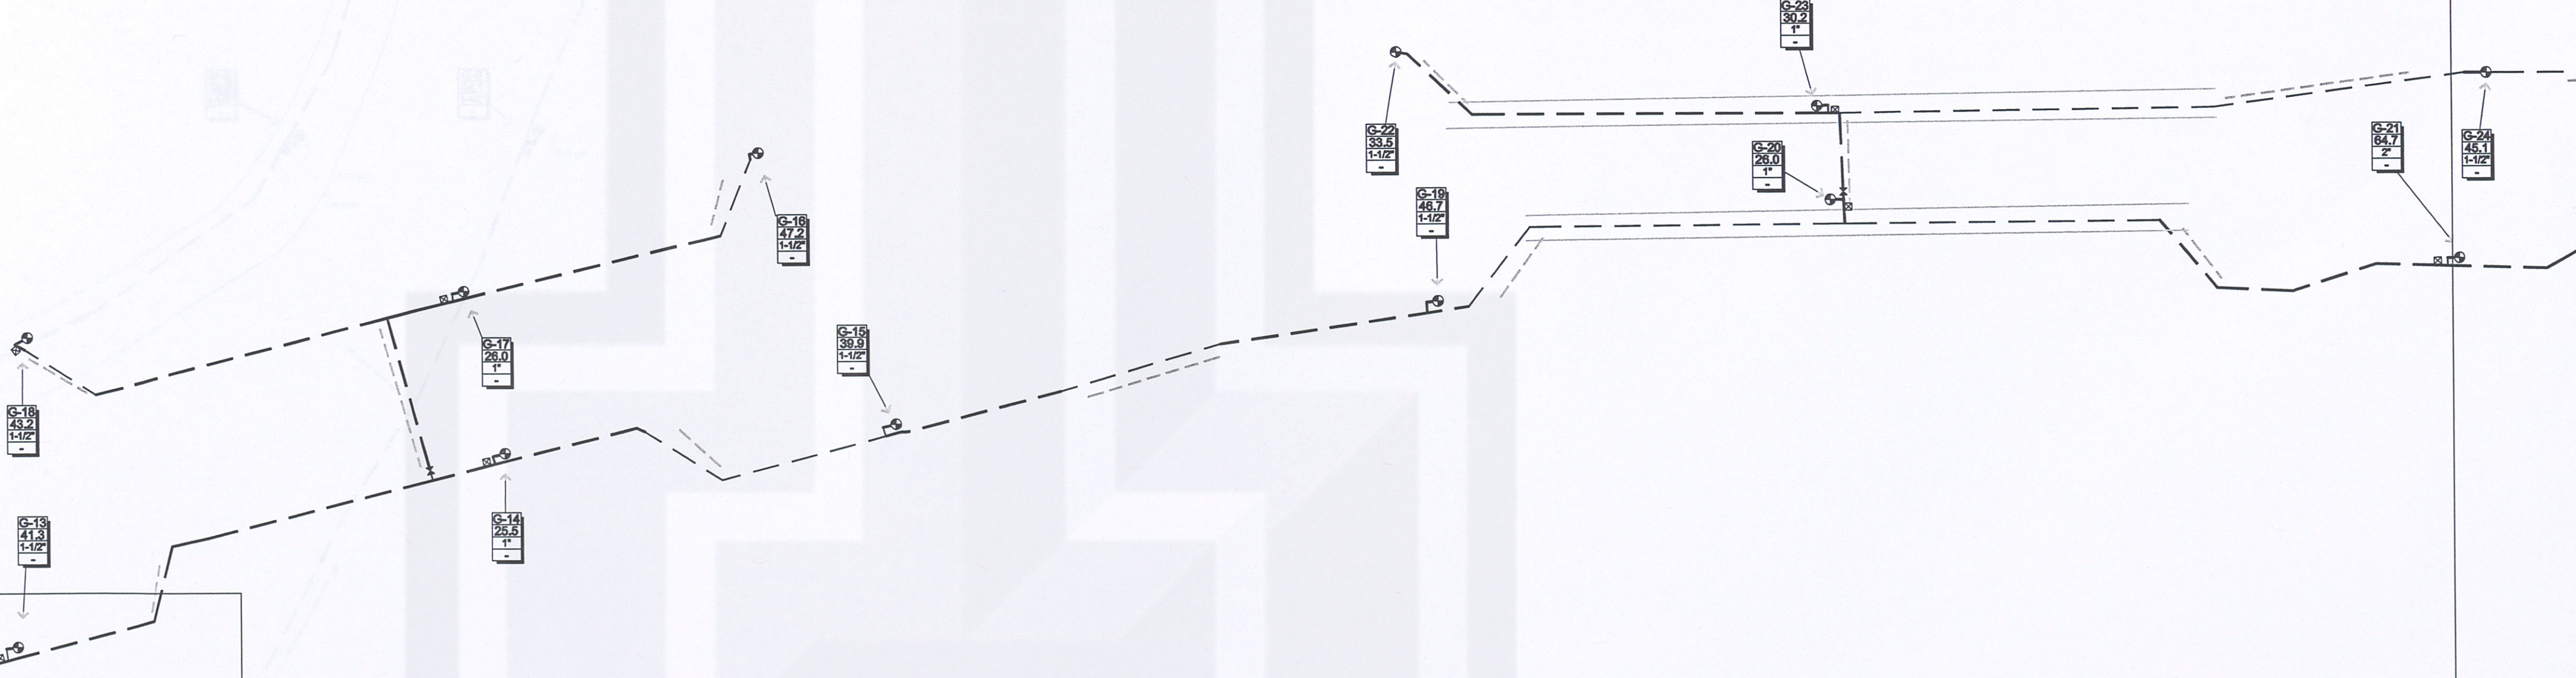

PROJECT:

DATE: 06/15/07

SCALE: 1"=30'0"

PAGE 2 OF 10

AS-BUILT

AUSTIN, TX
(512) 282-7394
SAN ANTONIO, TX
(210) 496-5185

PHOENIX
IRRIGATION



The Domain
AUSTIN, TEXAS