


LEGEND

- RainBird 5000-PL-PC-SAM-MPR- 35 Full / Half / Quarter
- RainBird 5000-PL-PC-SAM-MPR- 30 Full / Half / Quarter
- RainBird 5000-PL-PC-SAM-MPR- 25 Full / Half / Quarter
- RainBird 1804-SAM-PRS w/ 15F, H, Q MPR Plastic Nozzle
- RainBird 1804-SAM-PRS w/ 12F, H, Q, MPR Plastic Nozzle
- RainBird 1804-SAM-PRS w/ 10F, H, Q, MPR Plastic Nozzle
- RainBird 1804-SAM-PRS w/ 8F, H, Q MPR Plastic Nozzle
- RainBird 1804-SAM-PRS w/ 5F, H, Q MPR Plastic Nozzle
- RainBird 1804-SAM-PRS w/ 15SST MPR Plastic Nozzle
- RainBird 1804-SAM-PRS w/ 15EST, 15CST MPR Plastic Nozzle
- RainBird 1806-SAM-PRS w/ MP 2000 F, H, Q Rotary Nozzle
- RainBird 1806-SAM-PRS w/ MP 3000 F, H, Q Rotary Nozzle
- RainBird 1812-SAM-PRS w/ 15F, H, Q MPR Plastic nozzle
- RainBird 1812-SAM-PRS w/ 12F, H, Q, MPR Plastic Nozzle
- RainBird 1812-SAM-PRS w/ 10F, H, Q, MPR Plastic Nozzle
- RainBird 1812-SAM-PRS w/ 8F, H, Q MPR Plastic Nozzle
- RainBird 1812-SAM-PRS w/ 5F, H, Q MPR Plastic Nozzle
- RainBird 1812-SAM-PRS w/ 15SST MPR Plastic Nozzle
- RainBird 1812-SAM-PRS w/ 15EST, 15CST MPR Plastic Nozzle
- RainBird 1404 Bubbler installed on Flexible Tubing
- RainBird PESB-PRS-B Series Valve - size as noted on plan
- RainBird PESB-PRS-B Series Valve w/120 mesh filter - size as noted on plan
- Backflow - Size and type as shown on plan
- RainBird #33DNP Quick Coupling Valve w/ unitized swing joint
- Line Size Gate Valve
- Controller Hunter ICC-4000M-PED w/Mini-Click
- 2" Water Meter



Drip Bed installation w/Techline tubing TLCV6-1210
 Install as per details

----- Main Line Class 200 RT and/or Sch 40 PVC Main Line - Purple -size as shown on plan
 ----- Class 200 PVC Lateral Line - Size as shown on plan
 ----- 6" Sch 40 PVC Sleeve unless otherwise noted

A-1 Controller / Station Sequence No.
 X.X Gallons per Minute (GPM)
 1-1/2" Valve Size

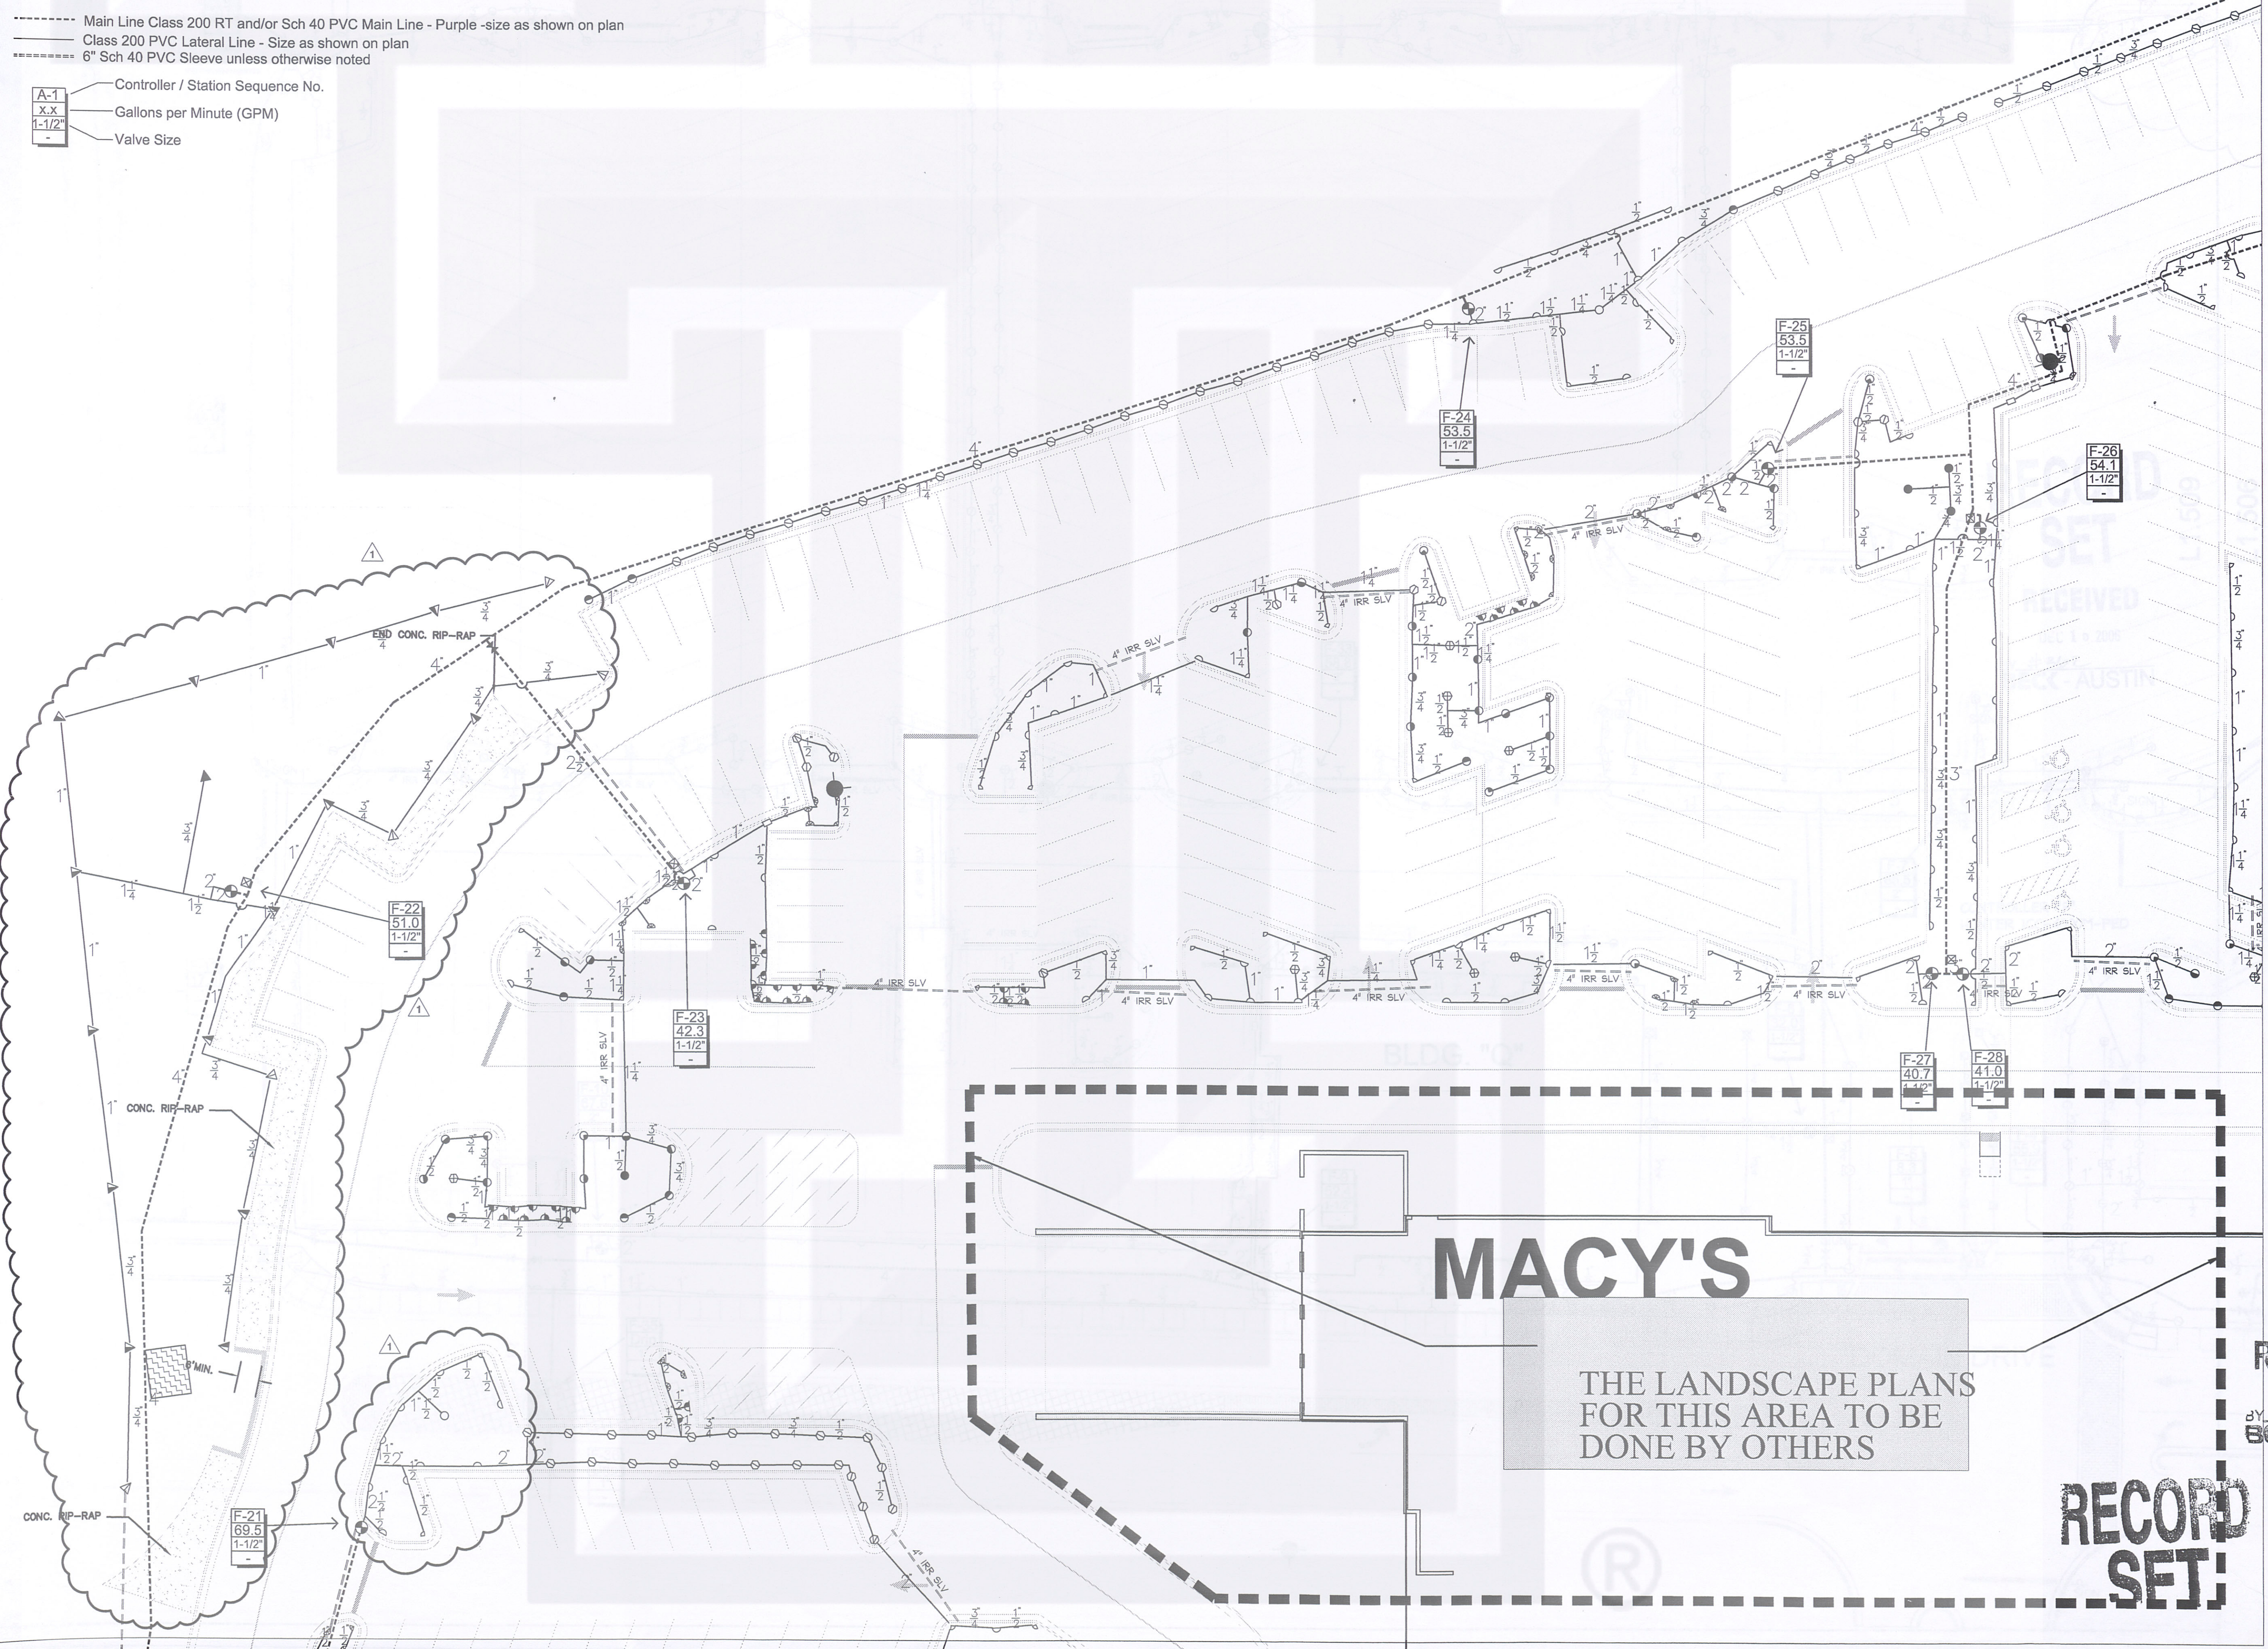

REVISIONS		
DELTA	DATE	DESCRIPTION
1	09/29/06	Irrigation Revisions and Update

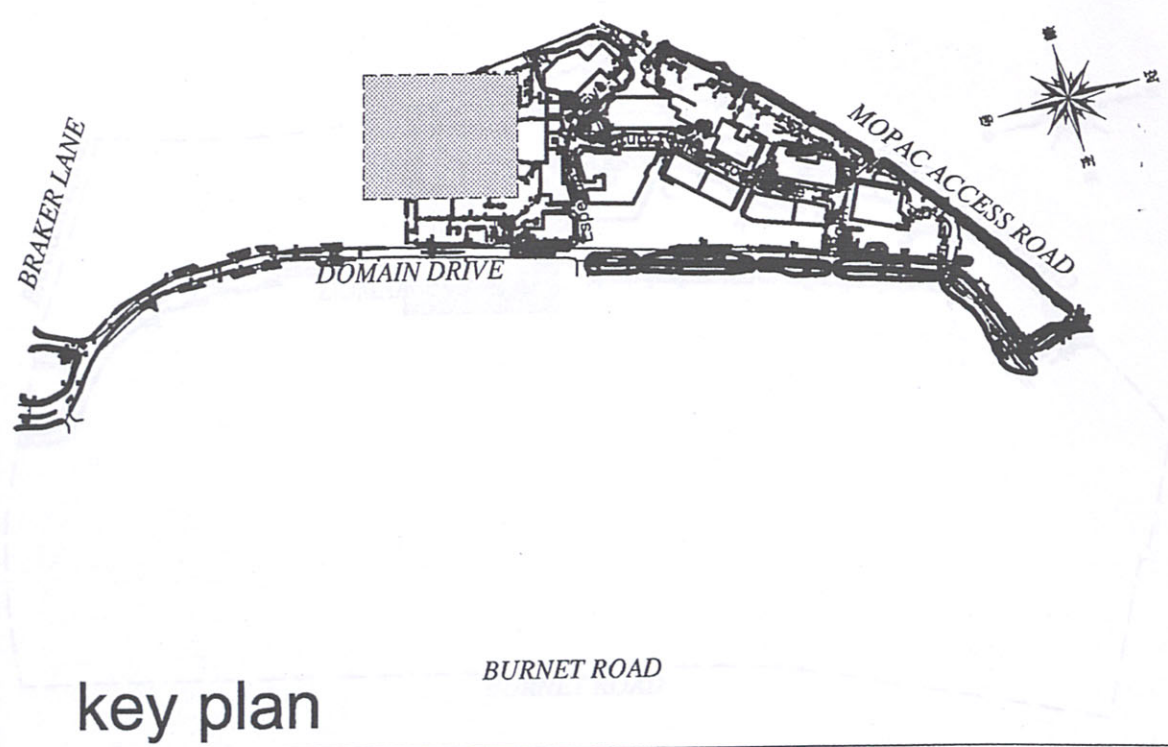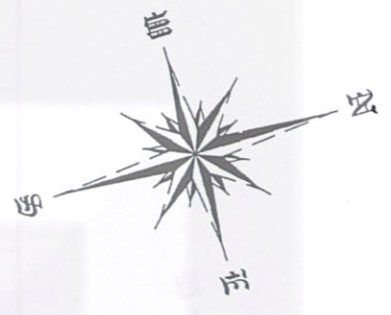

key plan

A JOINT VENTURE OF:
SIMON
ENDEAVOR
 REAL ESTATE GROUP

J. Robert Anderson, FASLA
 landscape architects - austin, texas
 1718 MANCHESTER ROAD
 AUSTIN, TEXAS 78704
 512-440-1065
 440-8000 FAX



02/10/06
 0 10' 20' 40' 60'
 SCALE: 1" = 20'

Project:
the domain
 AUSTIN, TEXAS

RECEIVED
 OCT 03 2006
 BY: [Signature]
 BECK - AUSTIN
JPRA ARCHITECTS
 31000 Northwestern Suite 100
 Farmington Hills Michigan 48334-2585
 phone 248 737 0180 fax 248 737 9161

SHEET TITLE:
IRRIGATION PLAN
 Sheet No.
L1.508

MACY'S

THE LANDSCAPE PLANS
 FOR THIS AREA TO BE
 DONE BY OTHERS

RECORD SET