


SITE FURNITURE KEY		TOTAL QUANTITY
B1	Backed Aluminum Bench - Ref. Detail 1 Sheet L1.115	22
B2	Backless Aluminum Bench - Ref. Detail 1 Sheet L1.115	18
B3	Backed Wooden Bench - Ref. Detail 1 Sheet L1.115	36
B4	Backless Wooden Bench - Ref. Detail 1 Sheet L1.115	25
	Trash Receptacle - Ref. Detail 7 Sheet L1.115	79
	Ash Urn - Ref. Detail 3 Sheet L1.115	26
	Bike Rack - Ref. Detail 6 Sheet L1.115	10
BE	Bollards - Ref. Detail 14 Sheet L1.114	38
RB	Bollards - Ref. Detail 15 Sheet L1.114	43
LB	Bollards - Ref. Detail 5 Sheet L1.115	14
	Directional Kiosk By Owner	2
	Directional Kiosk By Owner	2
	Future Art Locations By Owner	1
	Atrium Grates in Landscape Areas (NDS Drains)	85
	Hardscape Drain (Smith Drains)	41
	Grade Inlet by Civil	

PAVING AND MATERIALS LEGEND	
A	Pine Hall Brick "English Edge" Series - Color: Autumn
B	Pine Hall Brick "English Edge" Series - Color: Buff
C	Lueders Caramel Limestone - Broken Pattern
D	Arizona Sandstone - Random Coursed Ashlar Pattern; Color: Buckskin
D1	Arizona Sandstone - Broken Pattern; Color: Buckskin
E	Standard Grey Concrete - Rock Salt Finish with running bond pattern for streetscape areas.
E1	Standard Grey Concrete -Medium broom finish with 3" smooth trowel banding for back of house sidewalks @ parking garage walks.
F	Accent Banding - Scofield Admixture Color Concrete - Medium Broom Finish; Color: Westwood Brown
G	General Field - Scofield Admixture Color Concrete - Rock Salt Finish; Color: Harvest Wheat
H	Trex Accent Decking - Color: Saddle
I	Asphalt Paving per Civil Engineer specs.
J	Decomposed Crushed Granite Gravel
K	Adobe Tan - Scofield Admixture Color Concrete - square pattern; Medium Broom Finish

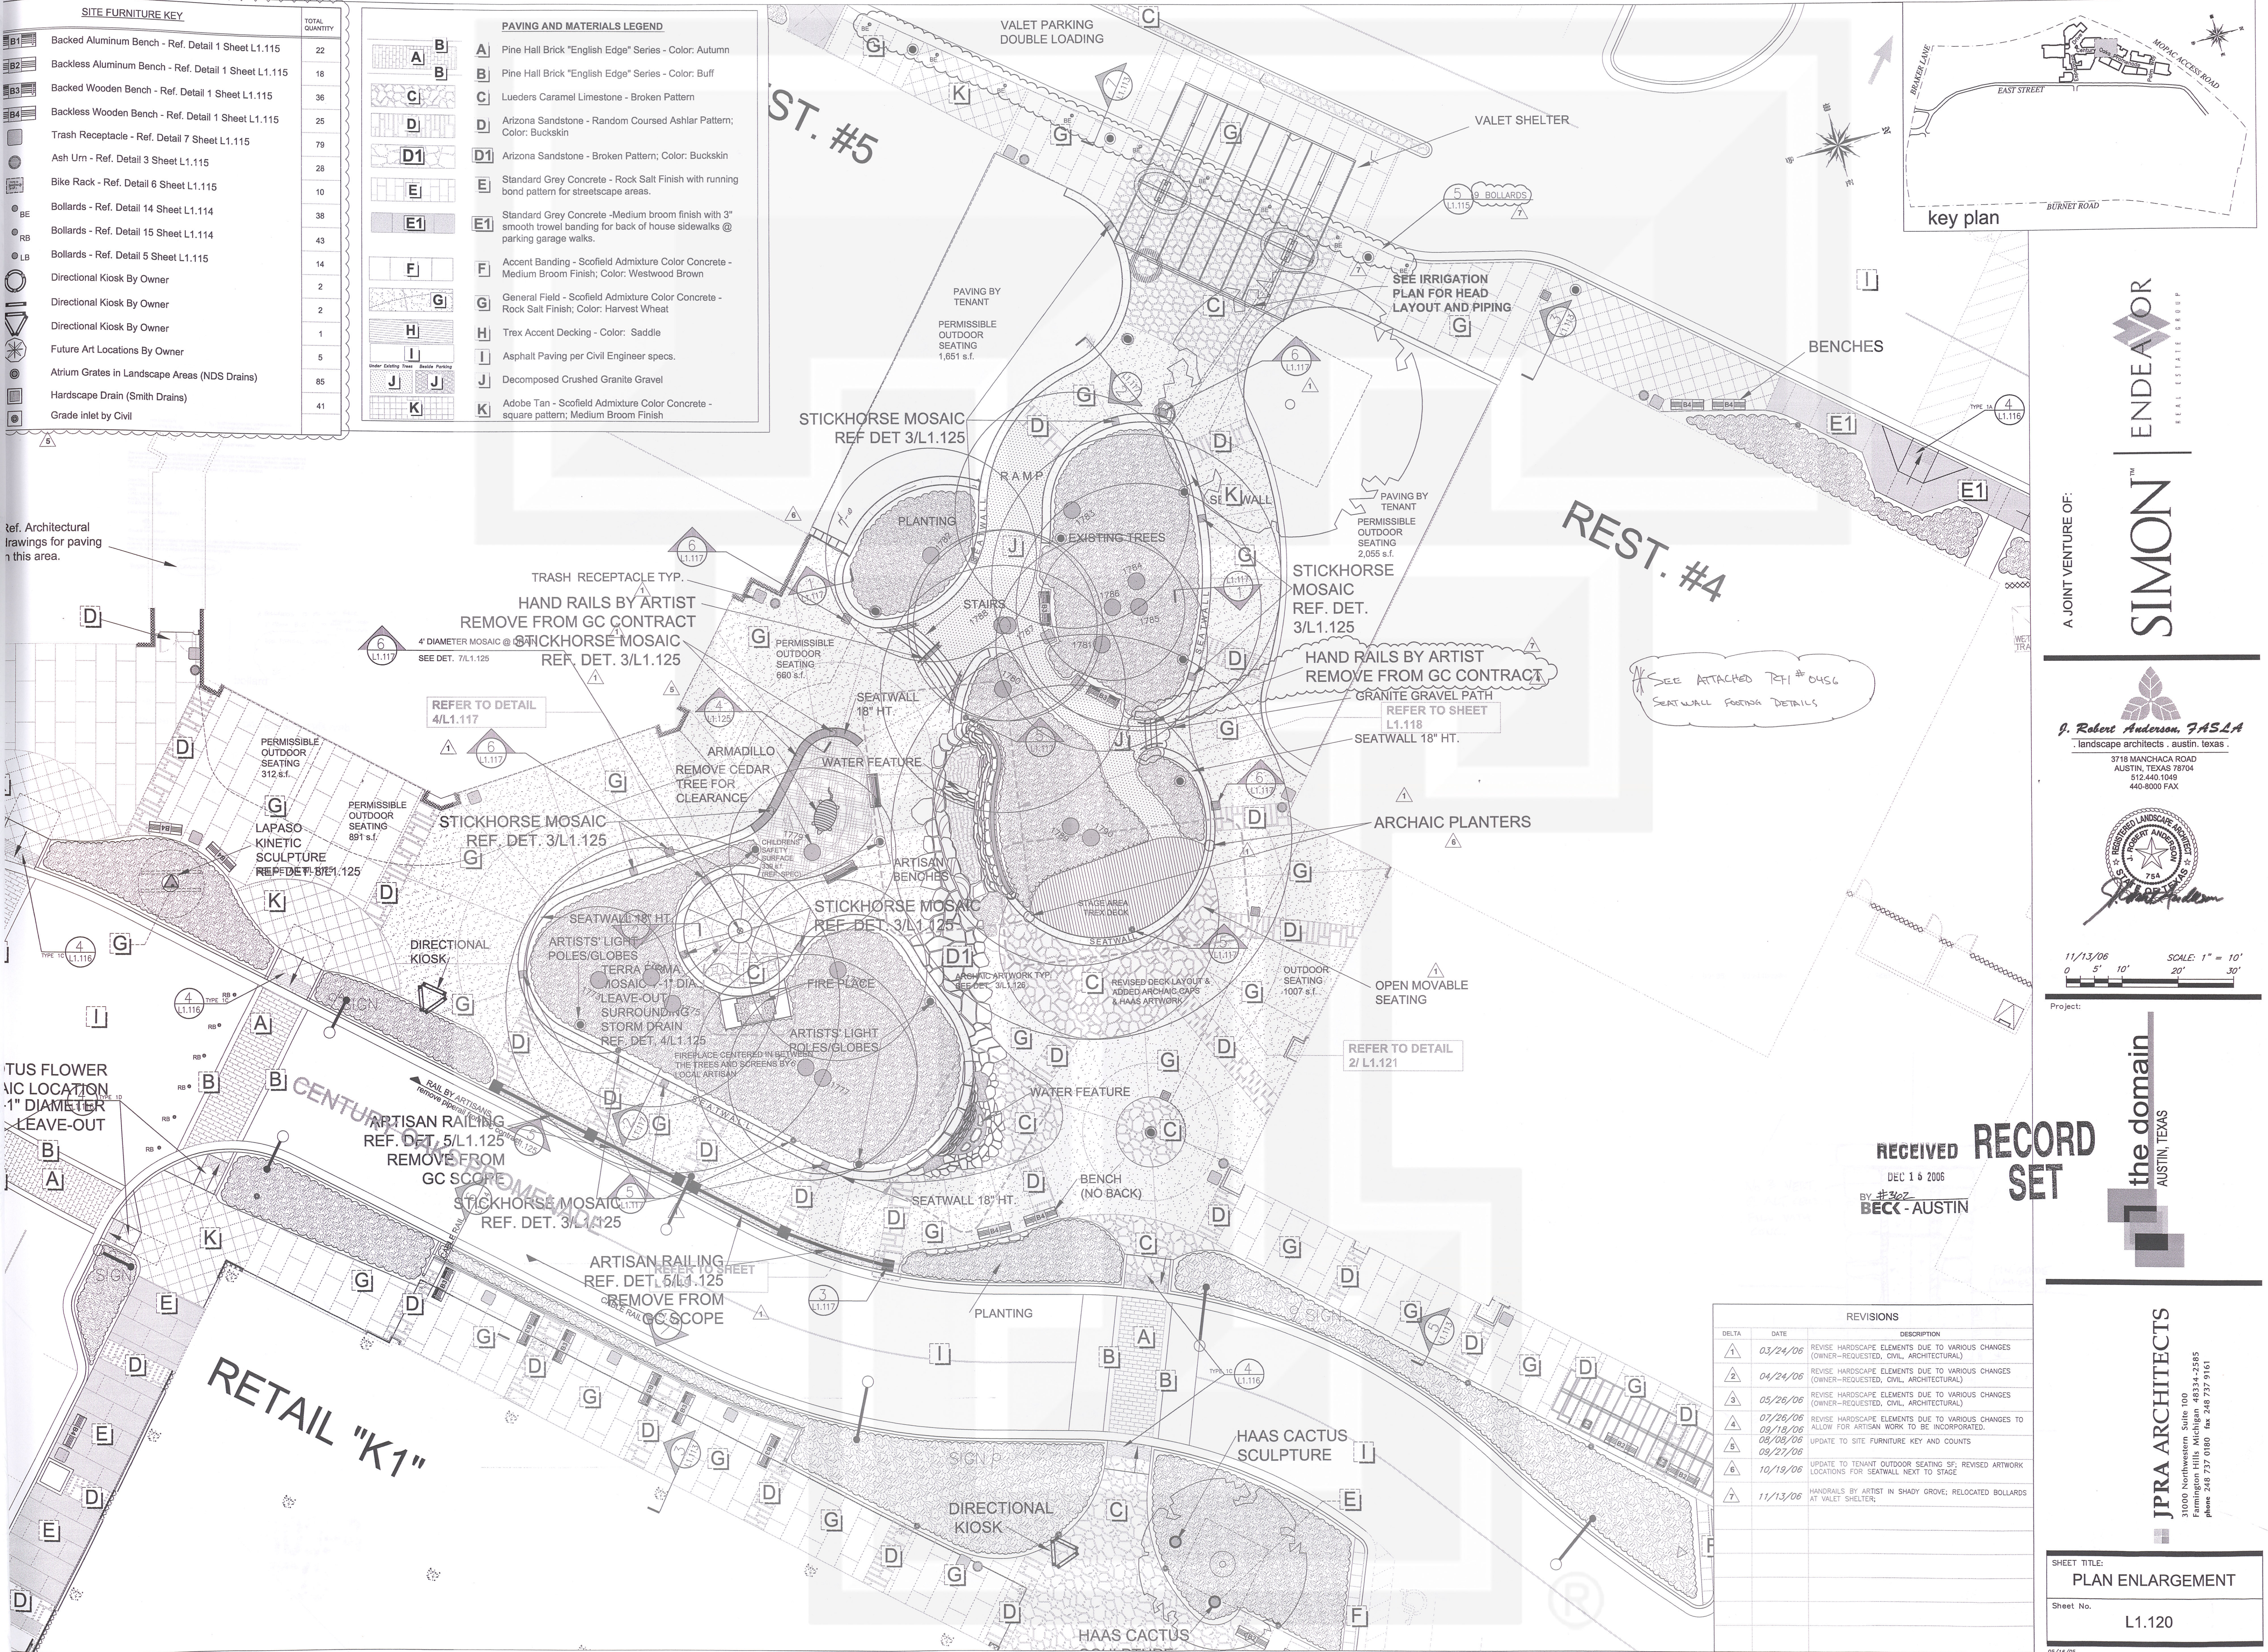


A JOINT VENTURE OF:

SIMON | **ENDEAVOR**

REAL ESTATE GROUP

J. Robert Anderson, FASLA
 landscape architects . austin, texas .
 3718 MANCHACA ROAD
 AUSTIN, TEXAS 78704
 512.440.1049
 440-8000 FAX

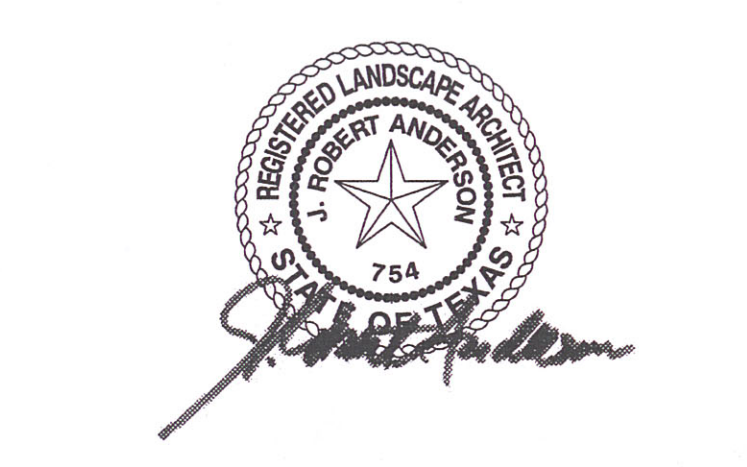

11/13/06
 SCALE: 1" = 10'
 0 5' 10' 20' 30'

Project:

the domain
 AUSTIN, TEXAS

RECEIVED RECORD SET
 DEC 18 2006
 BY #3022
BECK - AUSTIN

DELTA	DATE	DESCRIPTION
1	03/24/06	REVISE HARDSCAPE ELEMENTS DUE TO VARIOUS CHANGES (OWNER-REQUESTED, CIVIL, ARCHITECTURAL)
2	04/24/06	REVISE HARDSCAPE ELEMENTS DUE TO VARIOUS CHANGES (OWNER-REQUESTED, CIVIL, ARCHITECTURAL)
3	05/26/06	REVISE HARDSCAPE ELEMENTS DUE TO VARIOUS CHANGES (OWNER-REQUESTED, CIVIL, ARCHITECTURAL)
4	07/26/06	REVISE HARDSCAPE ELEMENTS DUE TO VARIOUS CHANGES TO ALLOW FOR ARTISAN WORK TO BE INCORPORATED.
5	09/18/06	UPDATE TO SITE FURNITURE KEY AND COUNTS
6	09/27/06	UPDATE TO TENANT OUTDOOR SEATING SF; REVISED ARTWORK LOCATIONS FOR SEATWALL NEXT TO STAGE
7	11/13/06	HANDRAILS BY ARTIST IN SHADY GROVE; RELOCATED BOLLARDS AT VALET SHELTER;

JPR ARCHITECTS
 31000 Northwestern Suite 100
 Farmington Hills Michigan 48334-2585
 phone 248 737 0180 fax 248 737 9161

SHEET TITLE:
PLAN ENLARGEMENT

Sheet No.
L1.120