


key plan

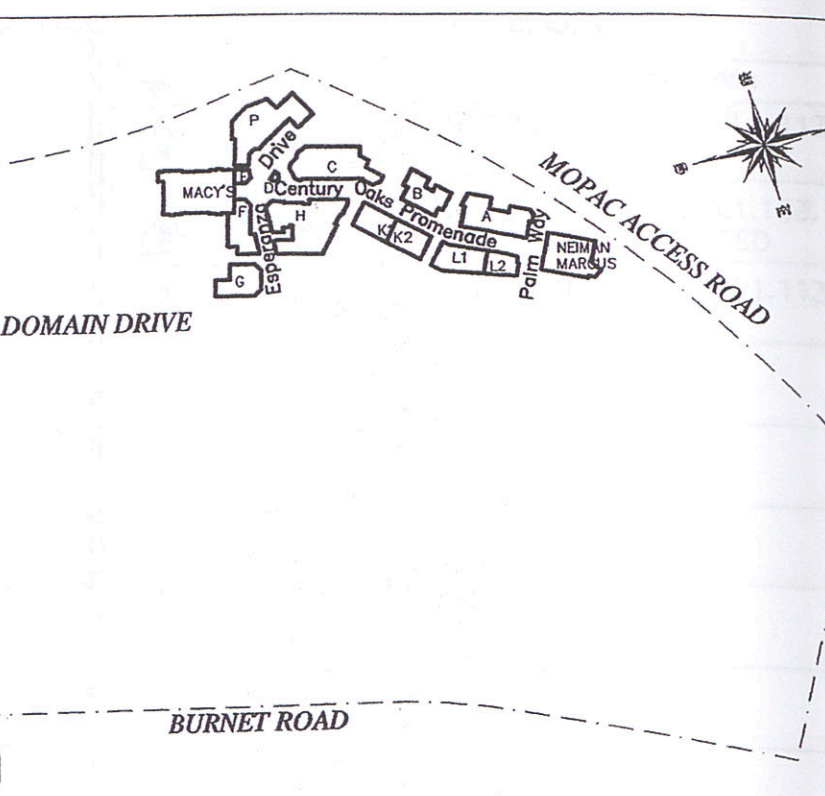

- 1 EXPANSION JOINT @ FLAGSTONE PAVING
- 2 CONCRETE EXPANSION JOINT CONTROL JOINT
- 3 CONCRETE WALK-ADJ. TO BUILDING
- 4 FLAGSTONE PAVING ADJ. TO BUILDING

PAVING AND MATERIALS LEGEND

- A Pine Hall Brick "old Town Series"
- B Pine Hall Brick "Sunset Blend Series"
- C Lueders Caramel Limestone - Broken Pattern
- D Arizona Sandstone - Random Coursed Ashlar Pattern
- D1 Arizona Sandstone - Broken Pattern
- E Standard Grey Concrete - Rock Salt Finish with running bond pattern for streetscape areas and broom finish with 3" smooth trowel banding for back of house sidewalks @ parking garage walks.
- F Accent Banding - Scofield Admixture Color Concrete - Westwood Brown
- G General Field - Scofield Admixture Color Concrete - Summer Beige
- H Trex Accent Decking - Saddle Color
- I Asphalt Paving per Civil Engineer specs.
- J Decomposed Crushed Granite Gravel
- K Adobe Tan - Scofield Admixture Color Concrete - square pattern

SITE FURNITURE KEY

		TOTAL QUANTITY	NORTH PACKAGE	SOUTH PACKAGE
B1	Backed Aluminum Bench - Ref. Detail 1 Sheet L1.115	22	22	-
B2	Backless Aluminum Bench - Ref. Detail 1 Sheet L1.115	21	21	-
B3	Backed Wooden Bench - Ref. Detail 1 Sheet L1.115	32	8	24
B4	Backless Wooden Bench - Ref. Detail 1 Sheet L1.115	21	-	21
	Trash Receptacle - Ref. Detail 7 Sheet L1.115	69	41	28
	Ash Urn - Ref. Detail 3 Sheet L1.115	29	19	10
	Bike Rack - Ref. Detail 6 Sheet L1.115	8	4	4
	Bollards - Ref. Detail 5 Sheet L1.115	17	14	3
	Directional Kiosk By Owner	1	1	-
	Directional Kiosk By Owner	4	2	2
	Directional Kiosk By Owner	1	-	1
	Future Art Locations By Owner	5	5	-

A JOINT VENTURE OF:
SIMON
ENDEAVOR
REAL ESTATE GROUP

J. Robert Anderson, FASLA
landscape architects - austin, texas
3718 MANCHACA ROAD
AUSTIN, TEXAS 78704
512.440.1049
440-8000 FAX



02/10/06 SCALE: 1" = 20'
0 10' 20' 40' 60'

Project:
the domain
AUSTIN, TEXAS

RECEIVED
FEB 15 2006
BY: BECK - AUSTIN
RECORD SET

J.P.R.A. ARCHITECTS
31000 Northwestern Suite 100
Farmingdale Hills, New York 11734-2585
phone 216 737 0180 fax 248 737 9161

SHEET TITLE:
HARDSCAPE MATERIALS PLAN
Sheet No.
L1.112