




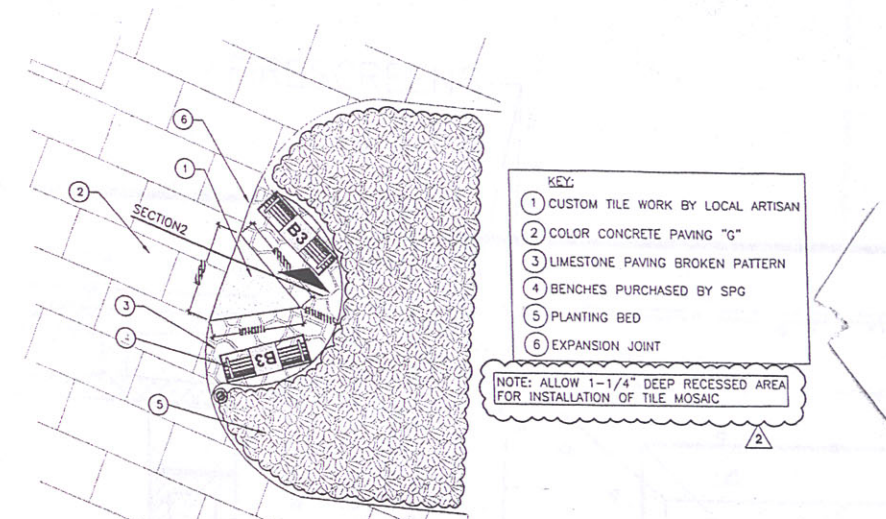

1 PLAN VIEW OF TRIANGLE AREA FOR TILE

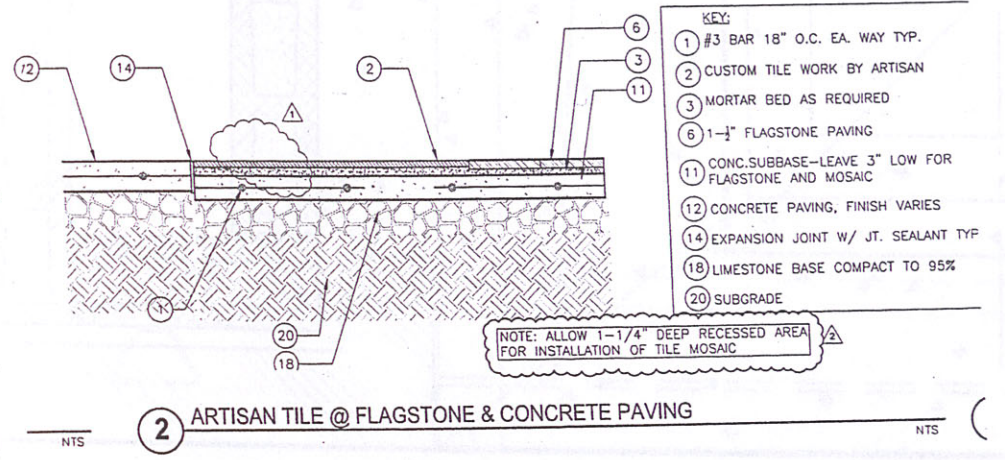

2 ARTISAN TILE @ FLAGSTONE & CONCRETE PAVING

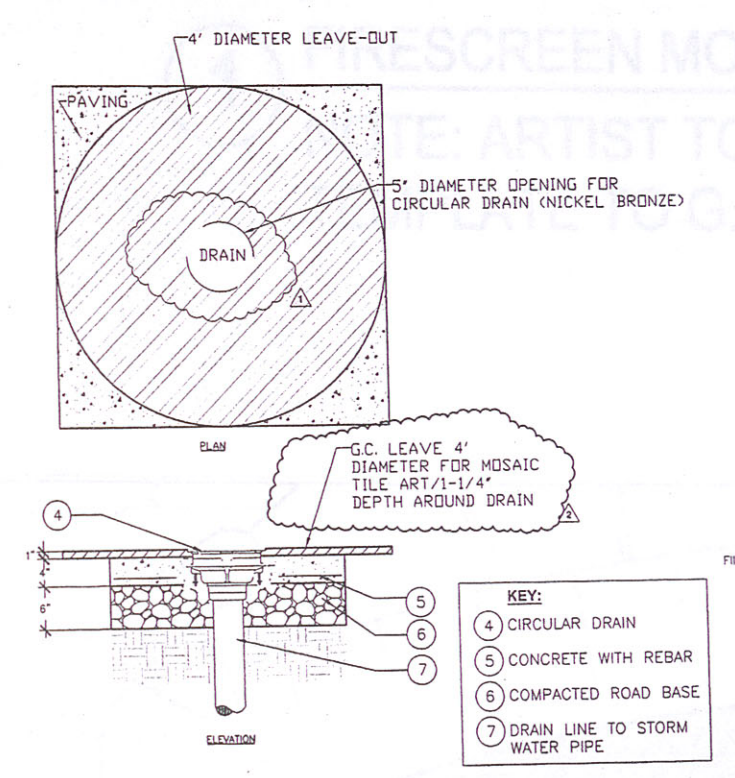

7 SMITH DRAIN IN CONCRETE FOR ARTISAN MOSAIC

SCREEN MOUNTING DETAIL- ENLARGED PLAN (REF DET: 4/L1,117)
E: ARTIST TO PROVIDE METAL FIRESCREEN
SCALE 1"=1'

SCREEN DIMENSIONS (REF DET: 4/L1,117)
ARTIST TO BUILD TO DIMENSIONS SHOWN
SCALE 1"=1'

ARTIST MOUNTING DETAIL
STAGE SEATWALL-ARCHAIC SCULPTURE
SCALE 1 1/2"=1'



5 ARTIST BASE @ 4 CORNERS LAPASO/C LATIMER PIECE
SCALE 1"=1'-0"

JPR Architects, PLLC
10000 N. Mopac Expressway, Suite 200
Austin, Texas 78753
Phone: 512.452.1234
Fax: 512.452.1235
www.jpra.com



the domain
AUSTIN, TEXAS

JPR ARCHITECTS
10000 N. Mopac Expressway, Suite 200
Austin, Texas 78753
Phone: 512.452.1234
Fax: 512.452.1235
www.jpra.com

RECEIVED
JPR ARCHITECTS

RECORD SET

SHEET NO.	HARDSCAPE DETAILS
Sheet No.	L1.128