



## 1 MORTARED LIMESTONE RETAINING WALL: RAISED ISLAND


TYPE 1A

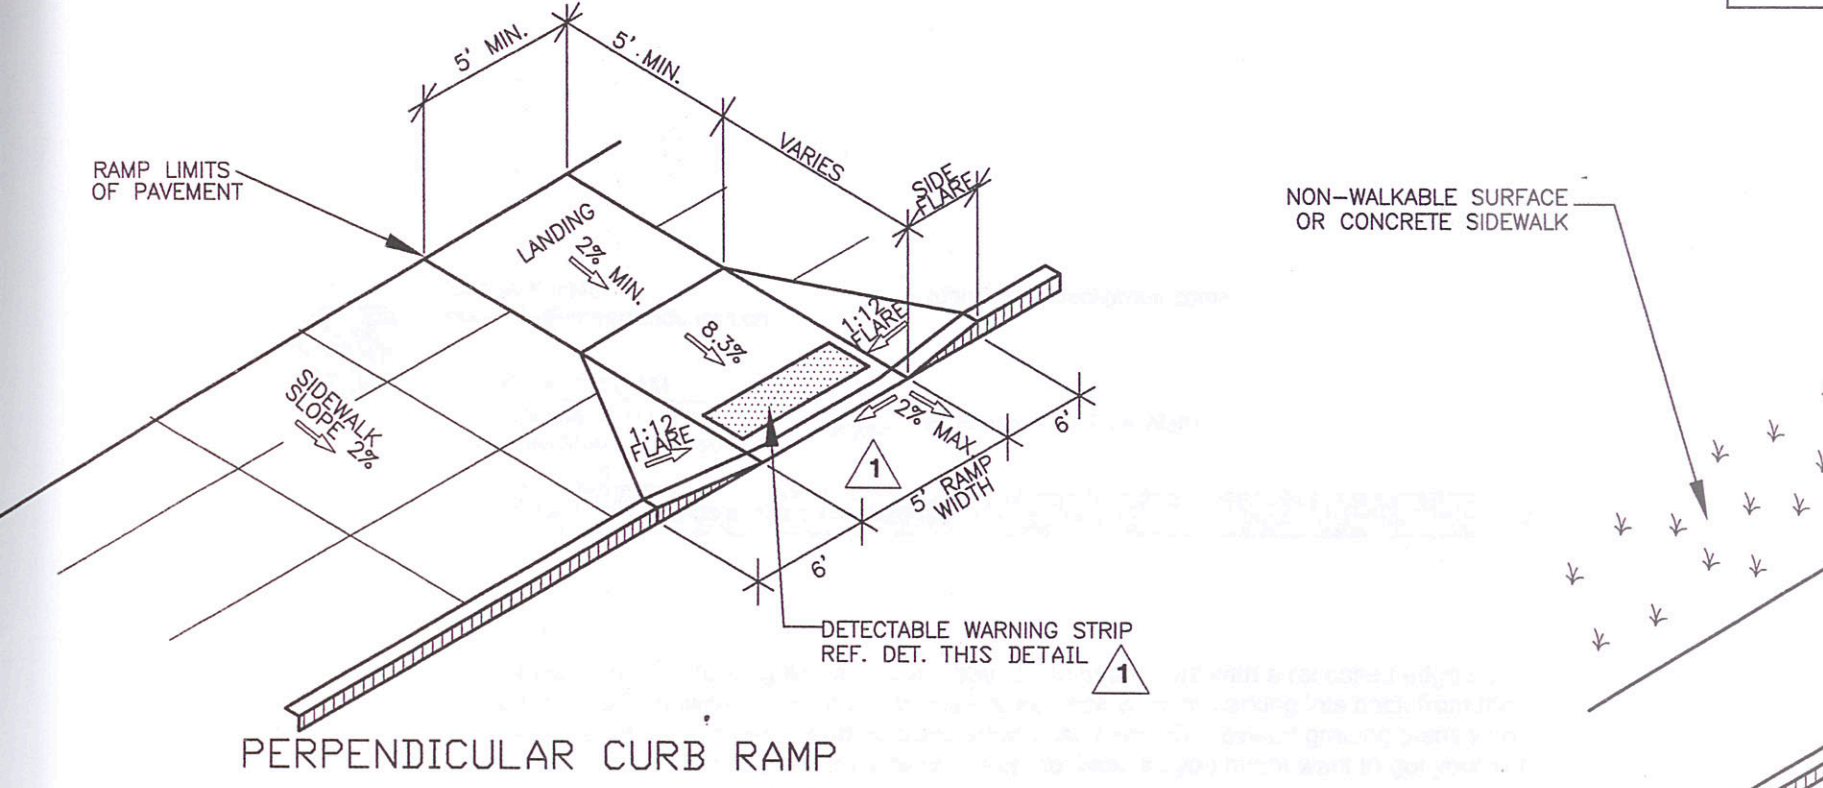


TYPE 1D

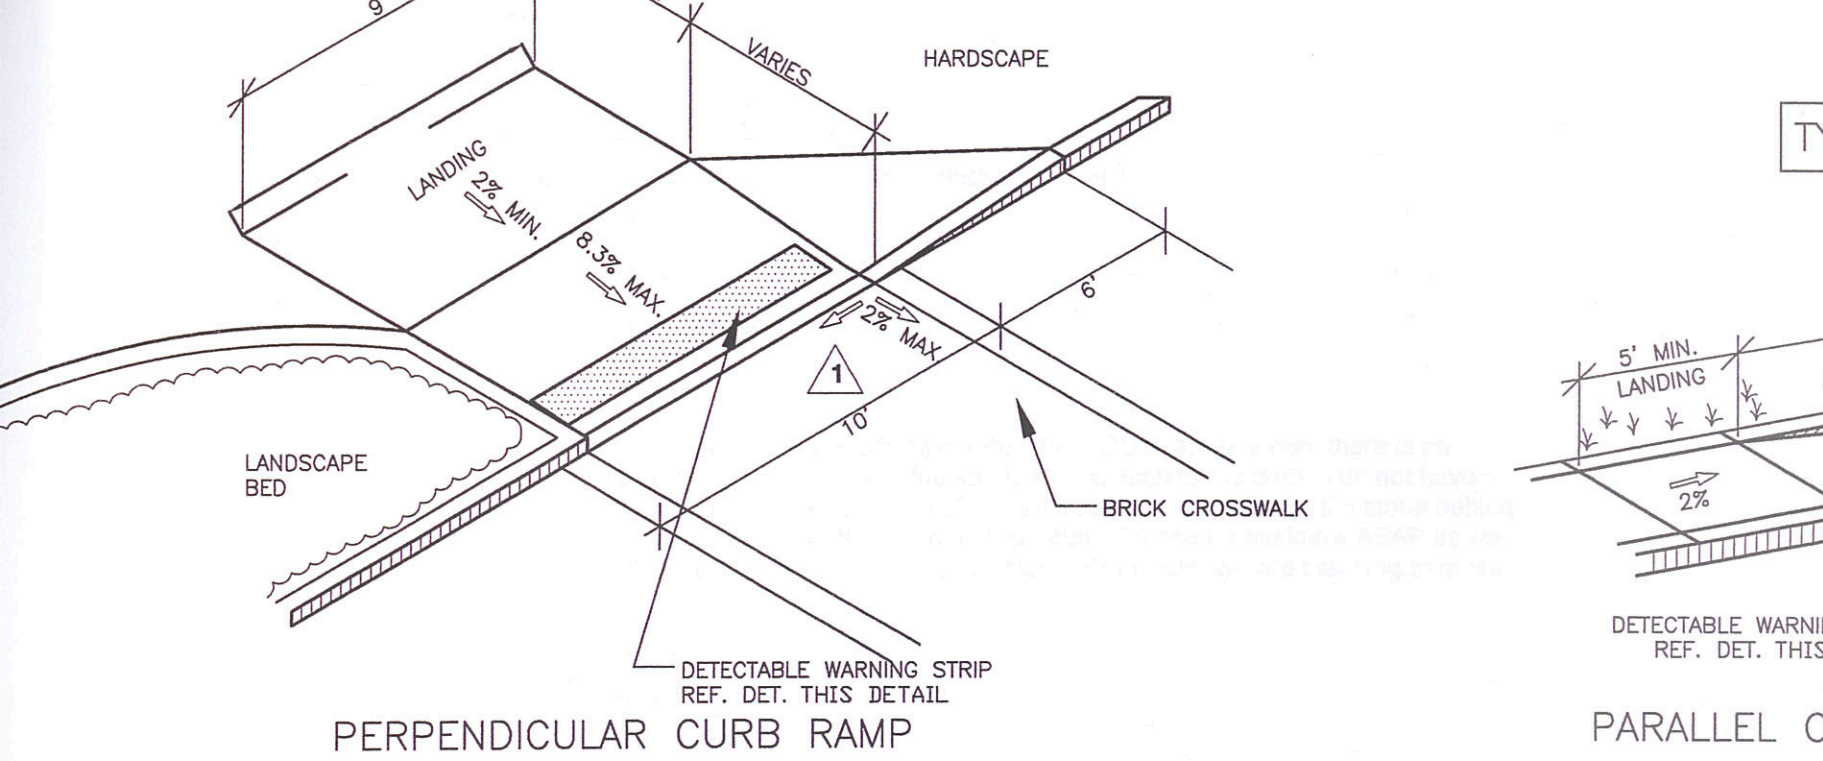


TYPE 7

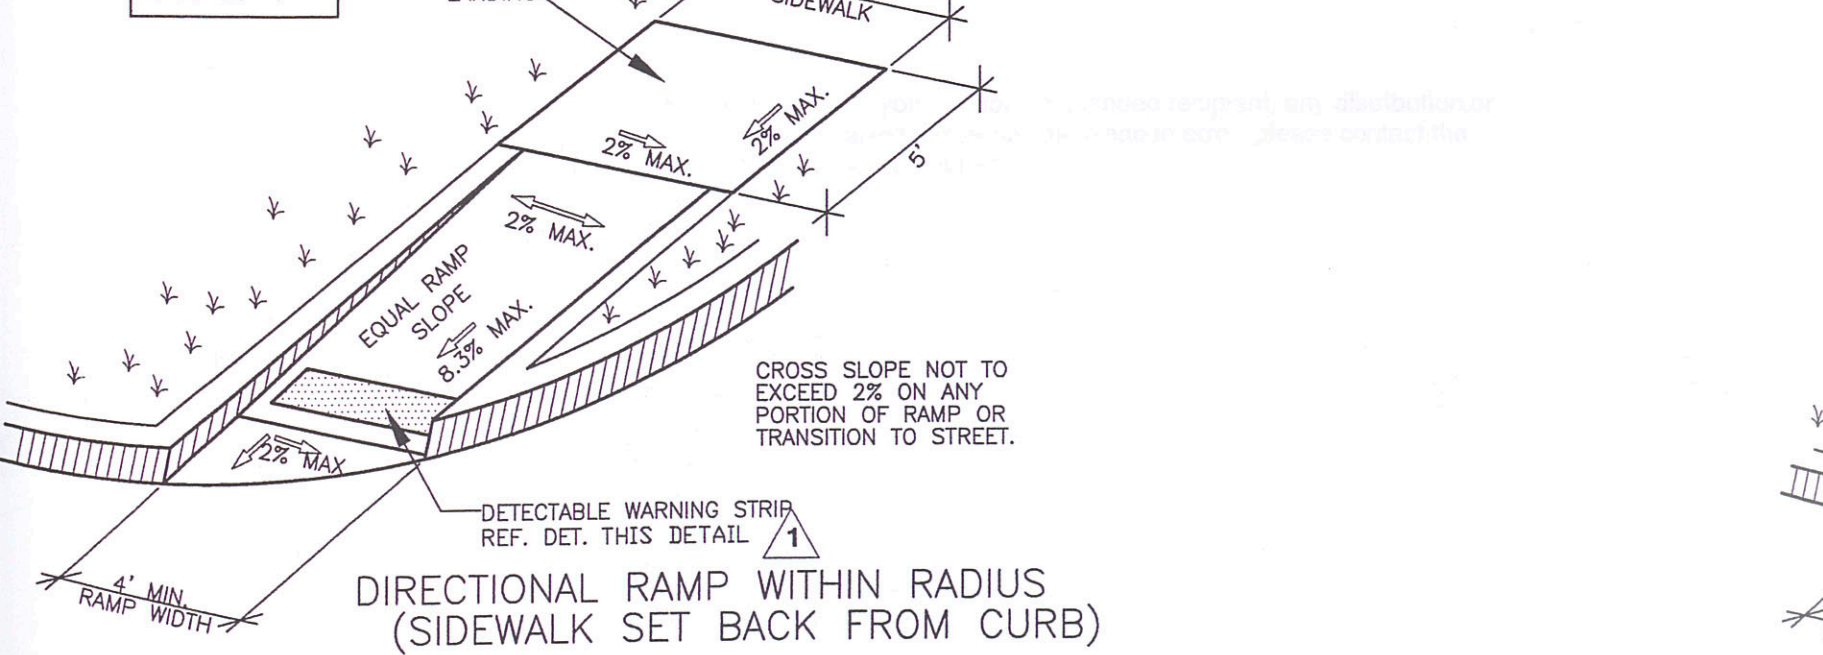

TYPE 5A

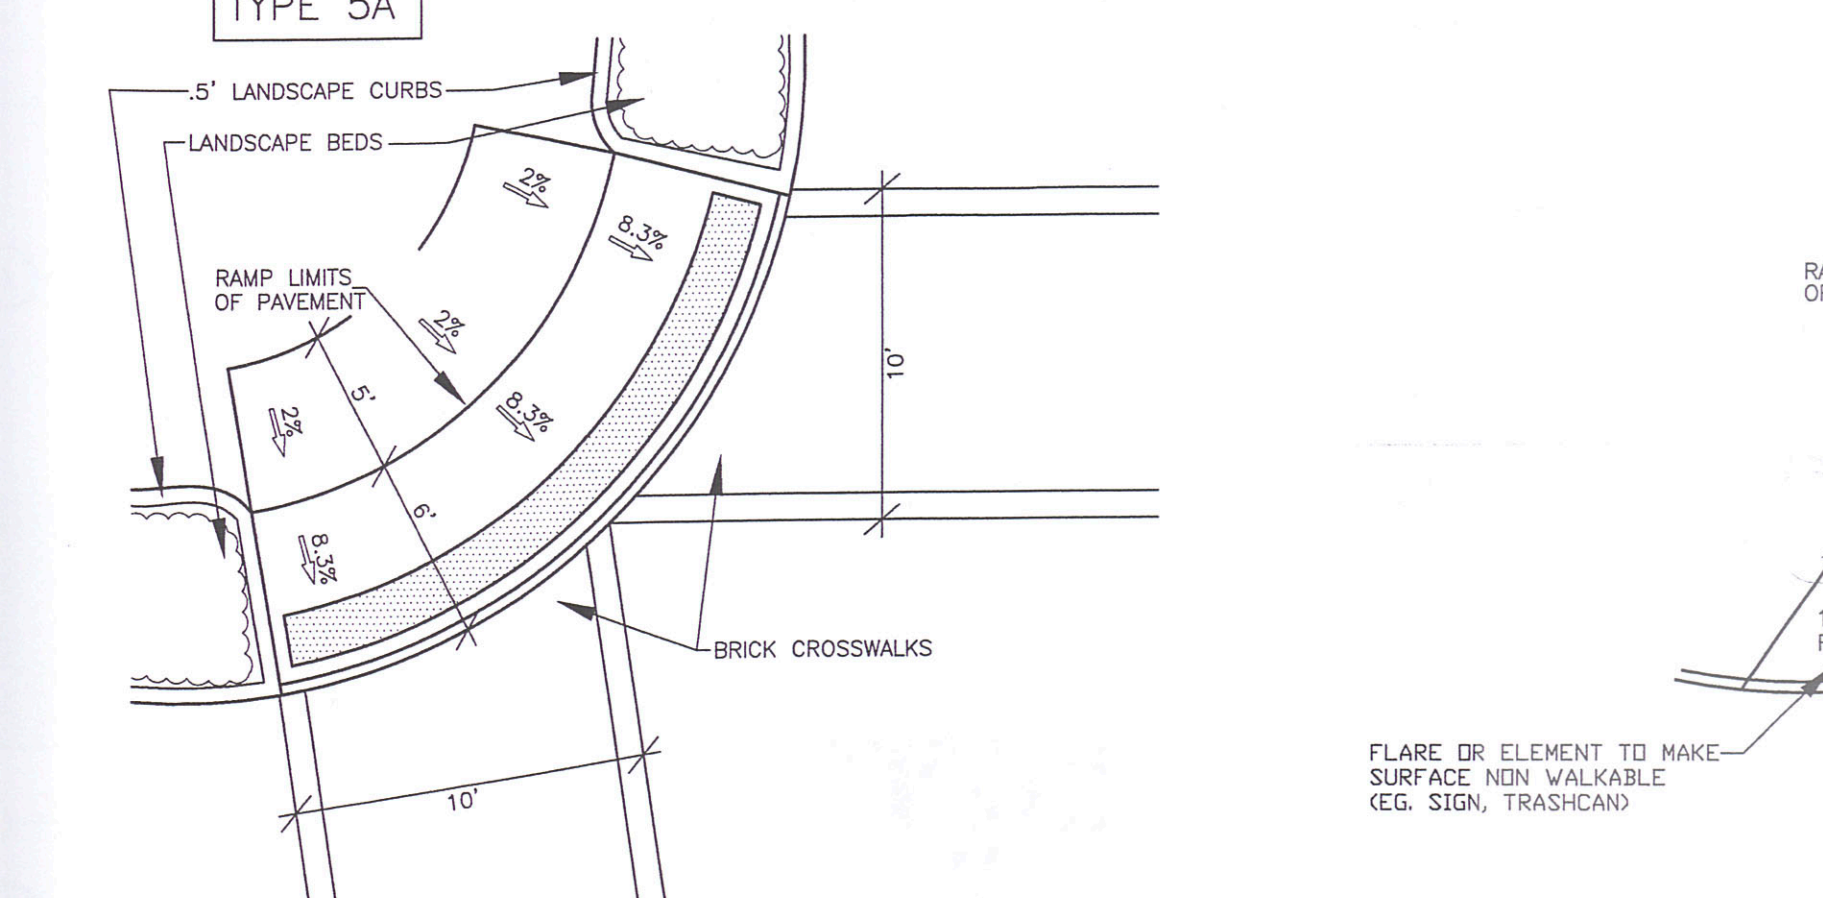


TYPE 5B

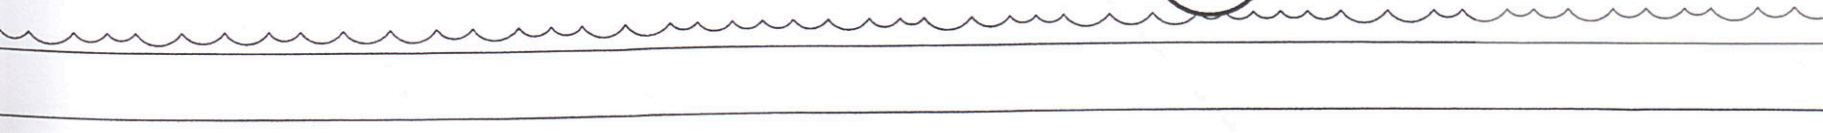


## 2 MORTARED LIMESTONE RETAINING WALL: TREE WELL


TYPE 1B

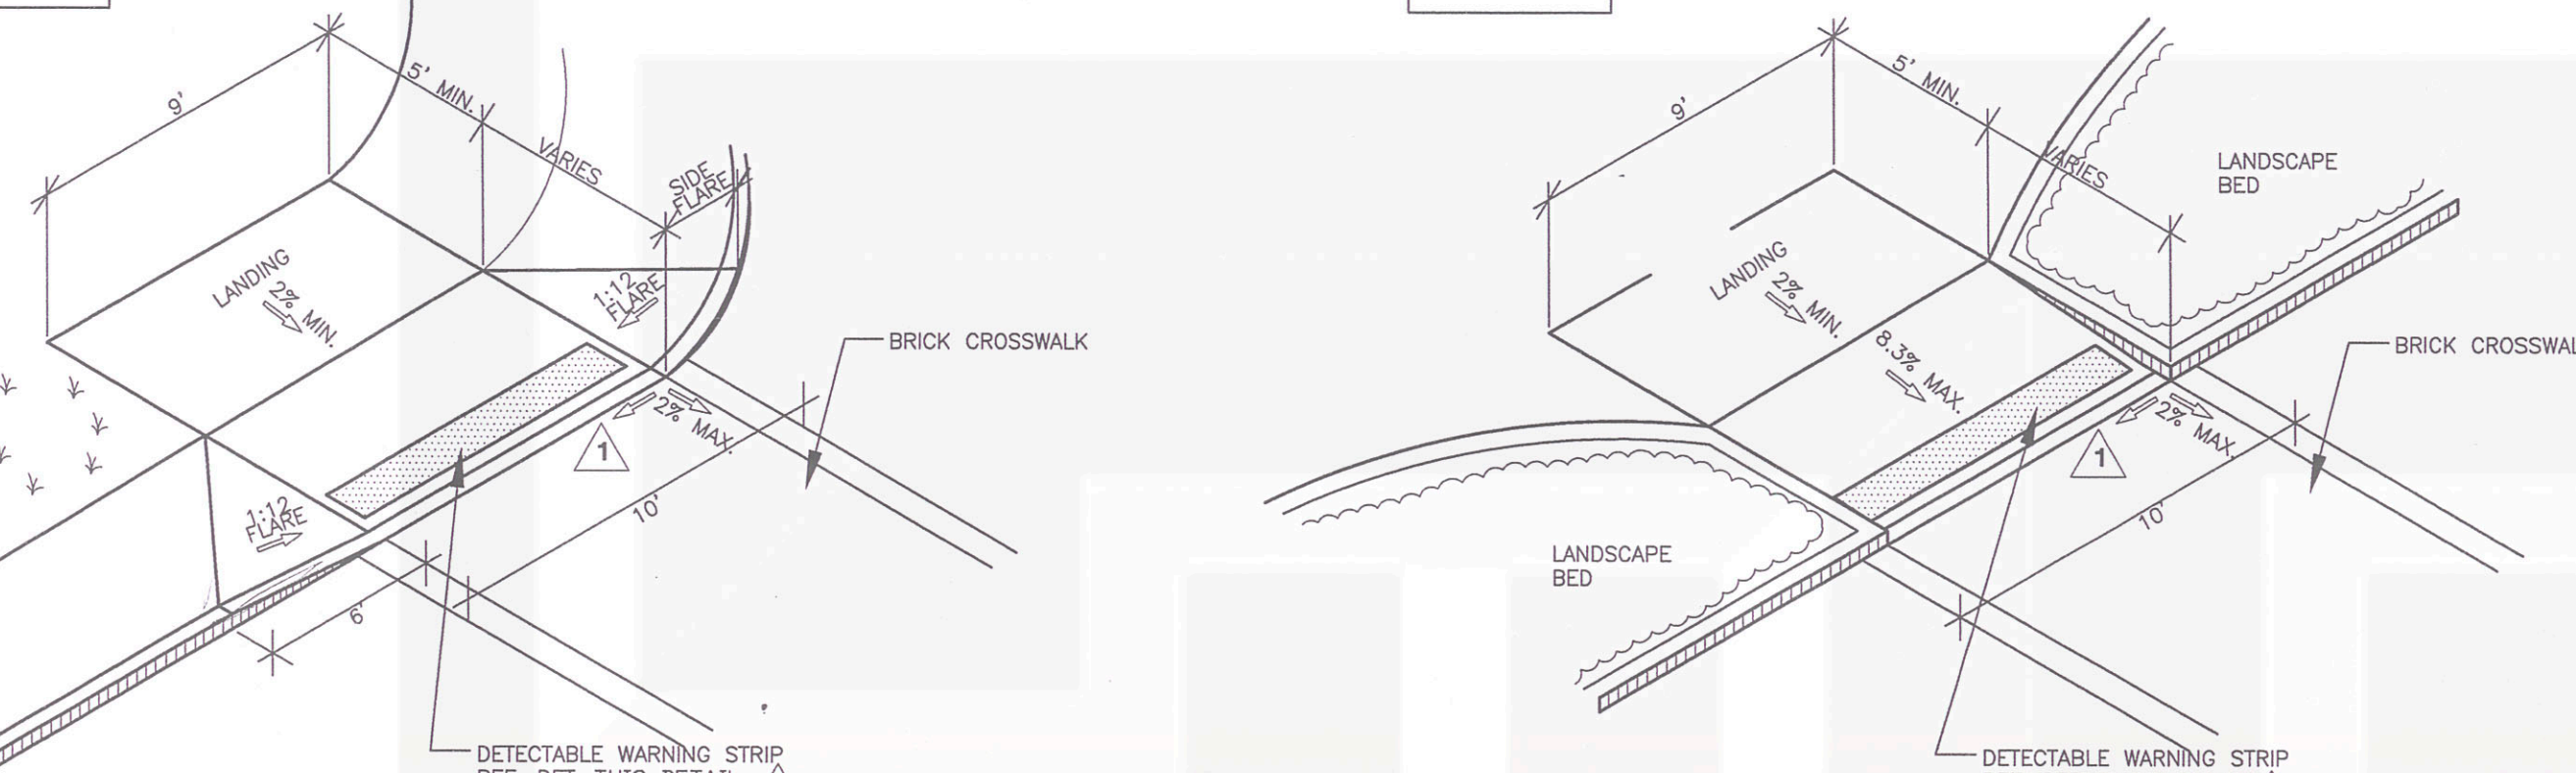


TYPE 2A

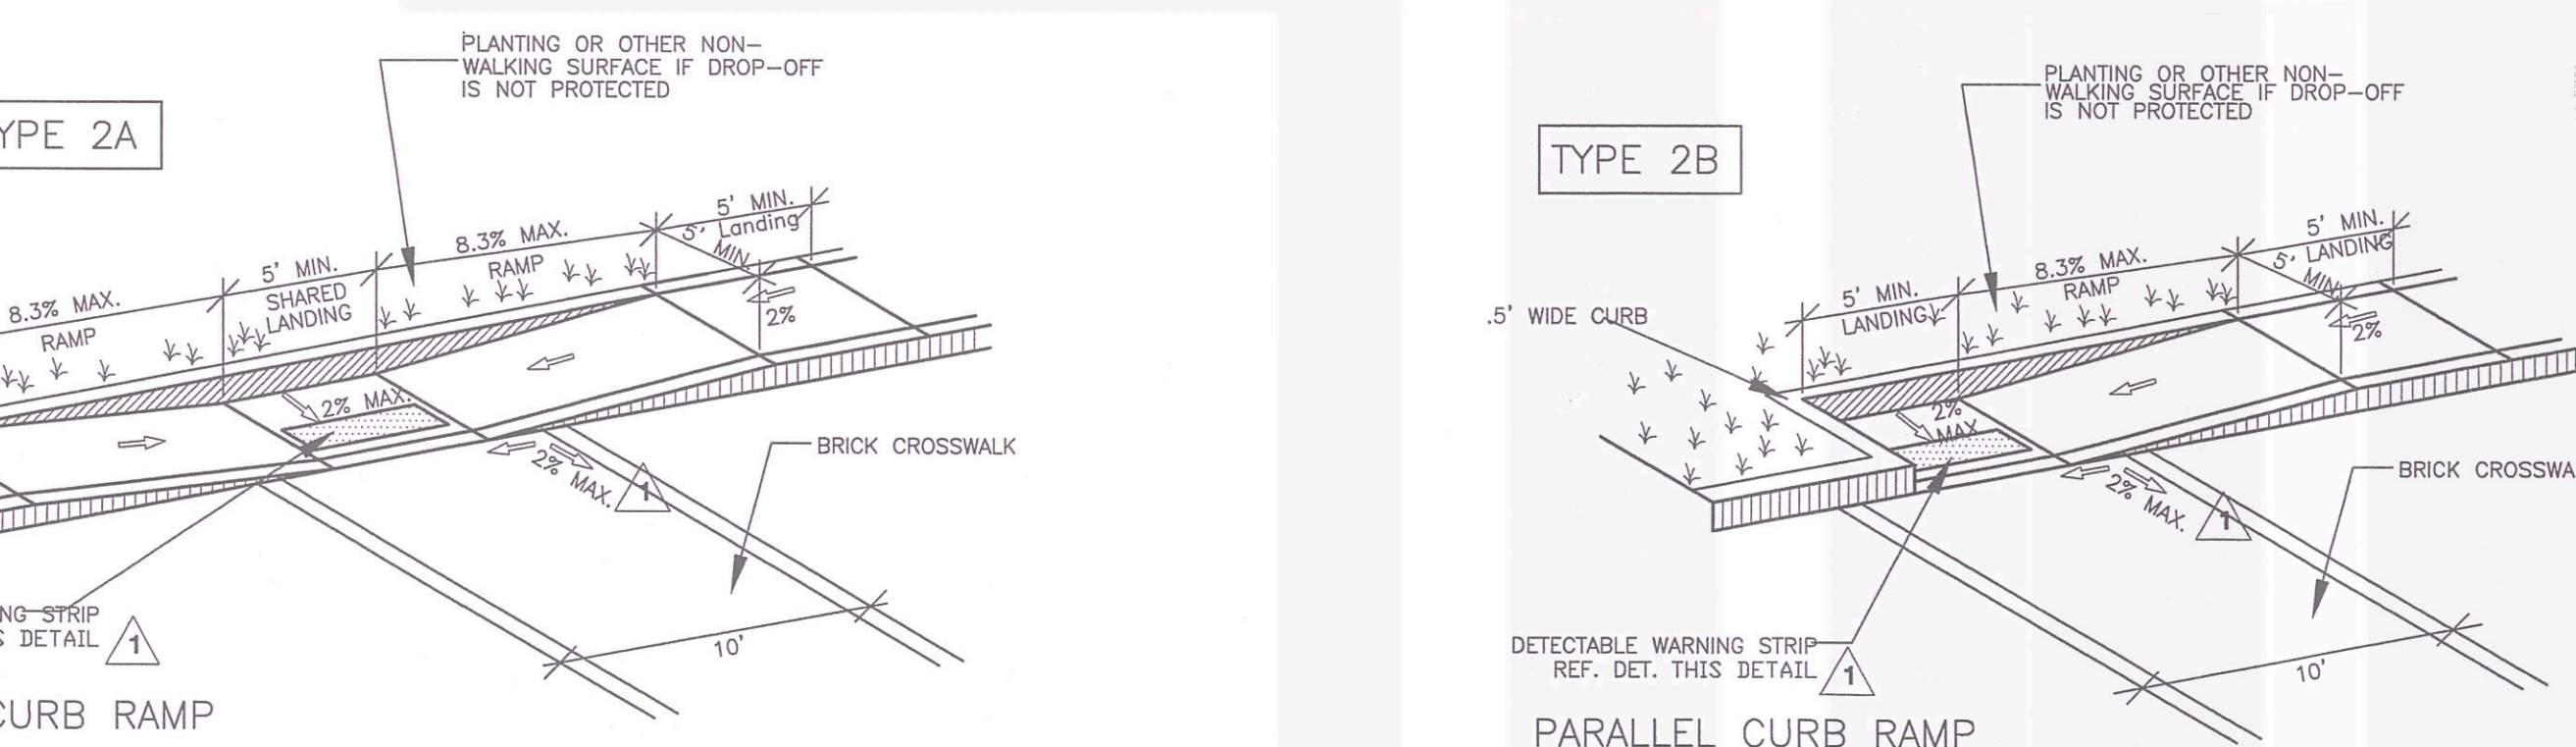


TYPE 10

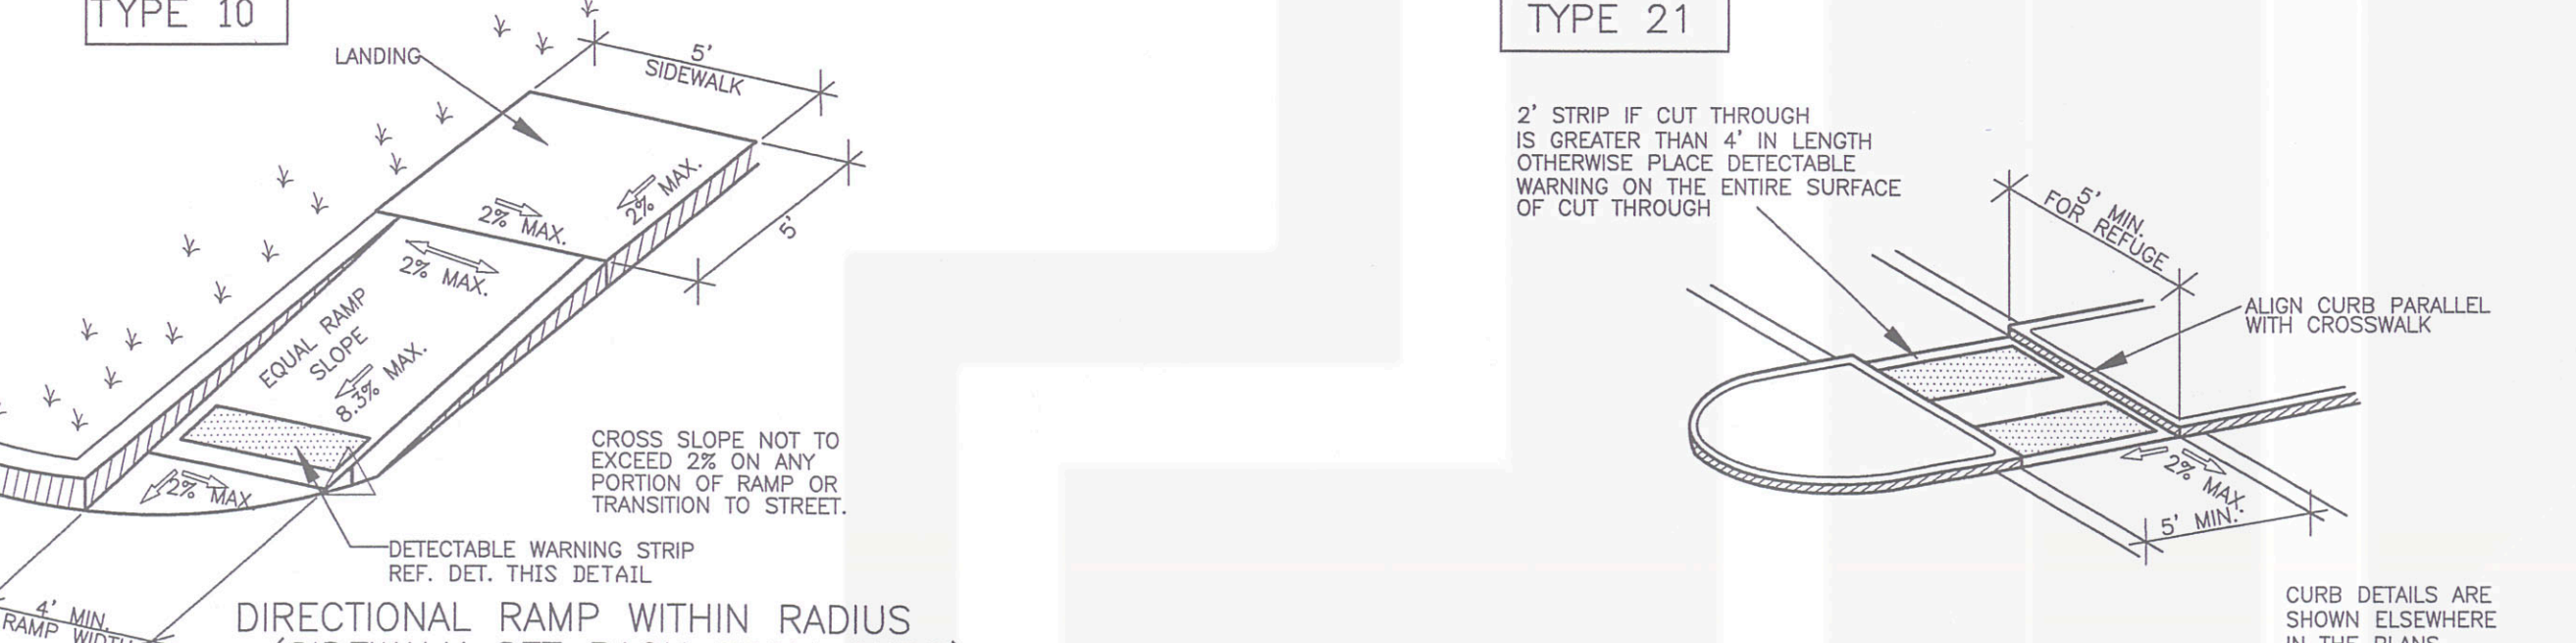

TYPE 10B

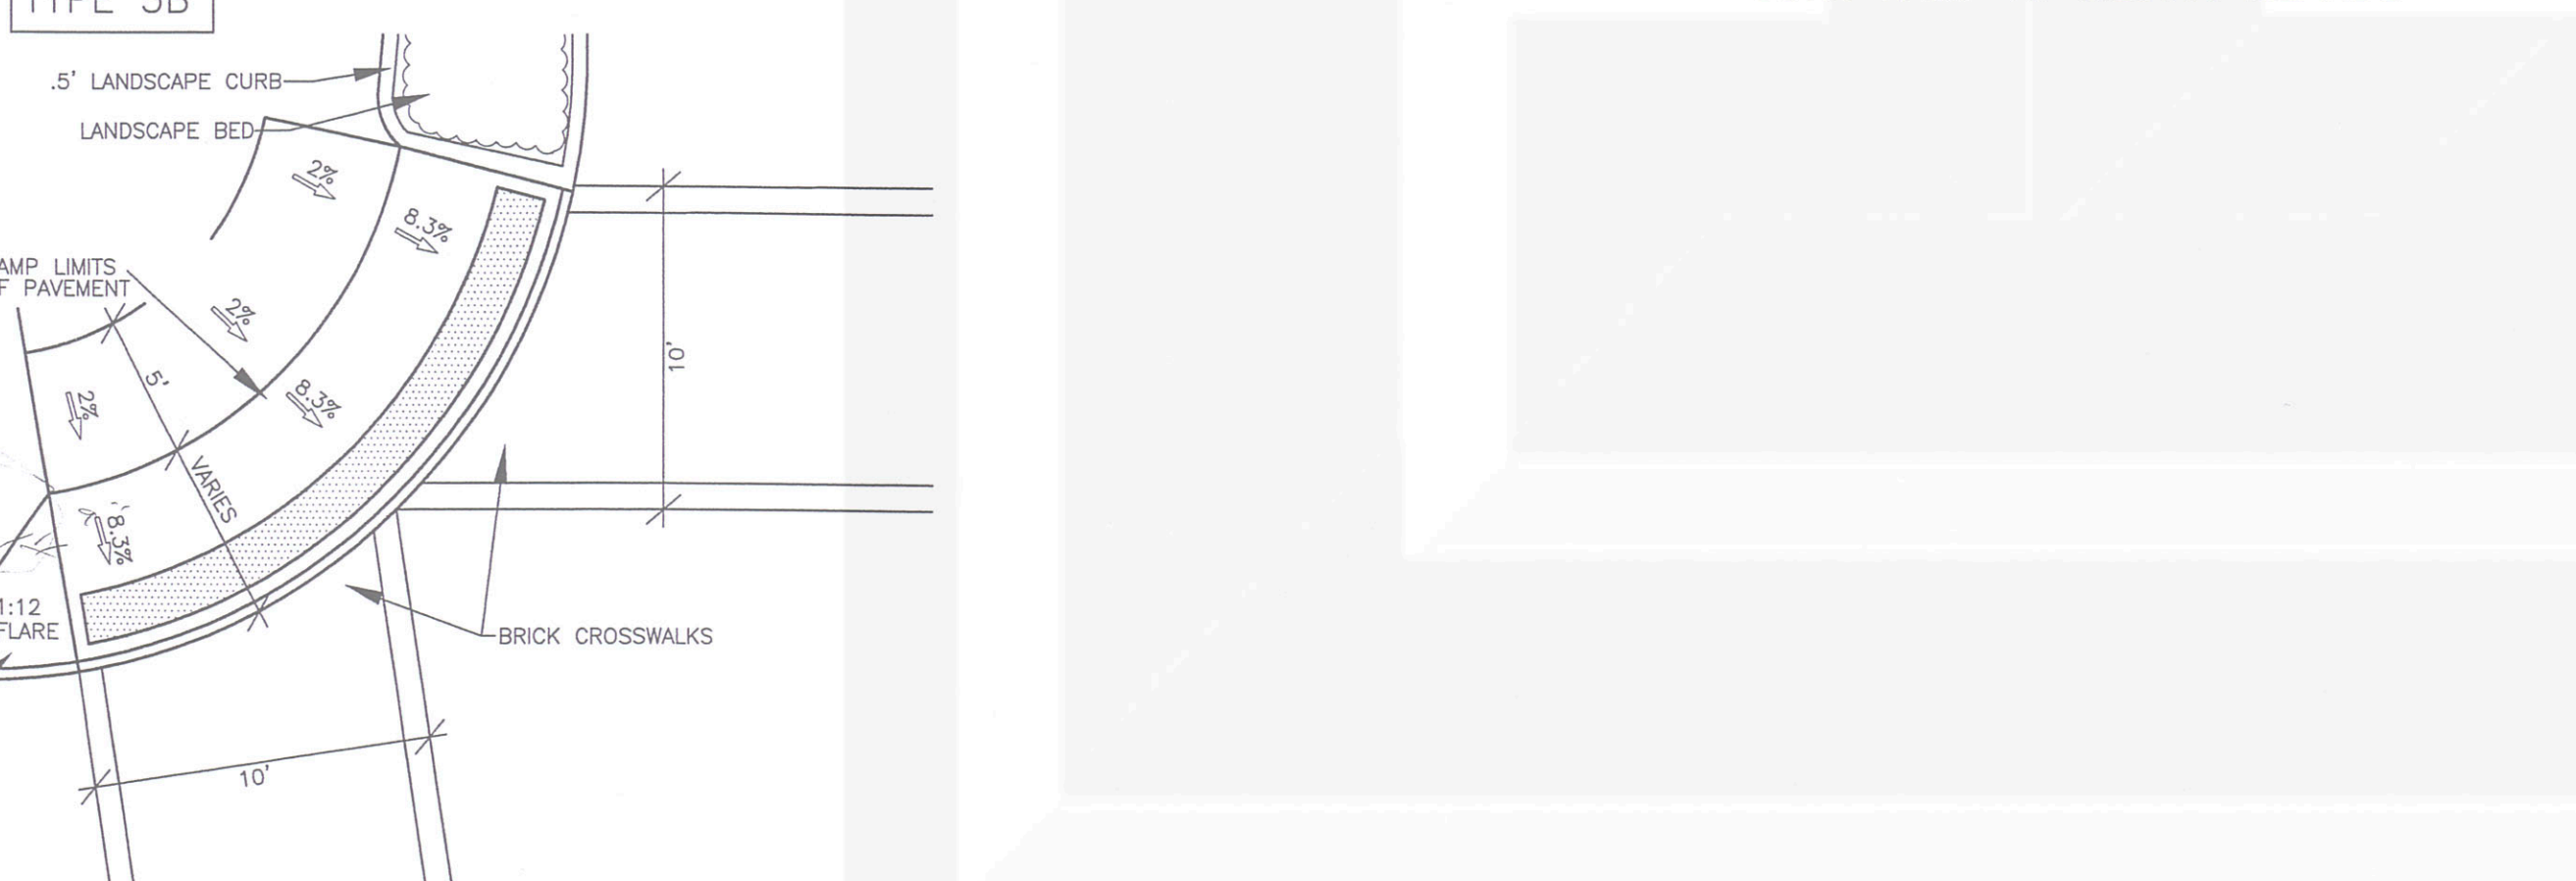


TYPE 10C

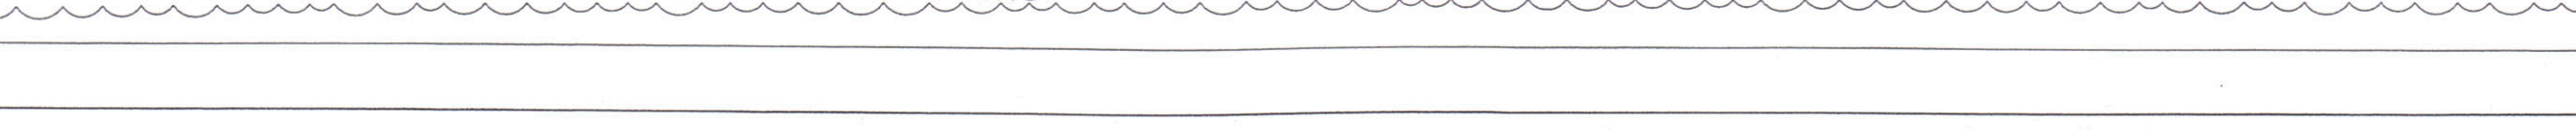


## 3 MORTARED LIMESTONE RETAINING WALL: ELEVATION


TYPE 1C

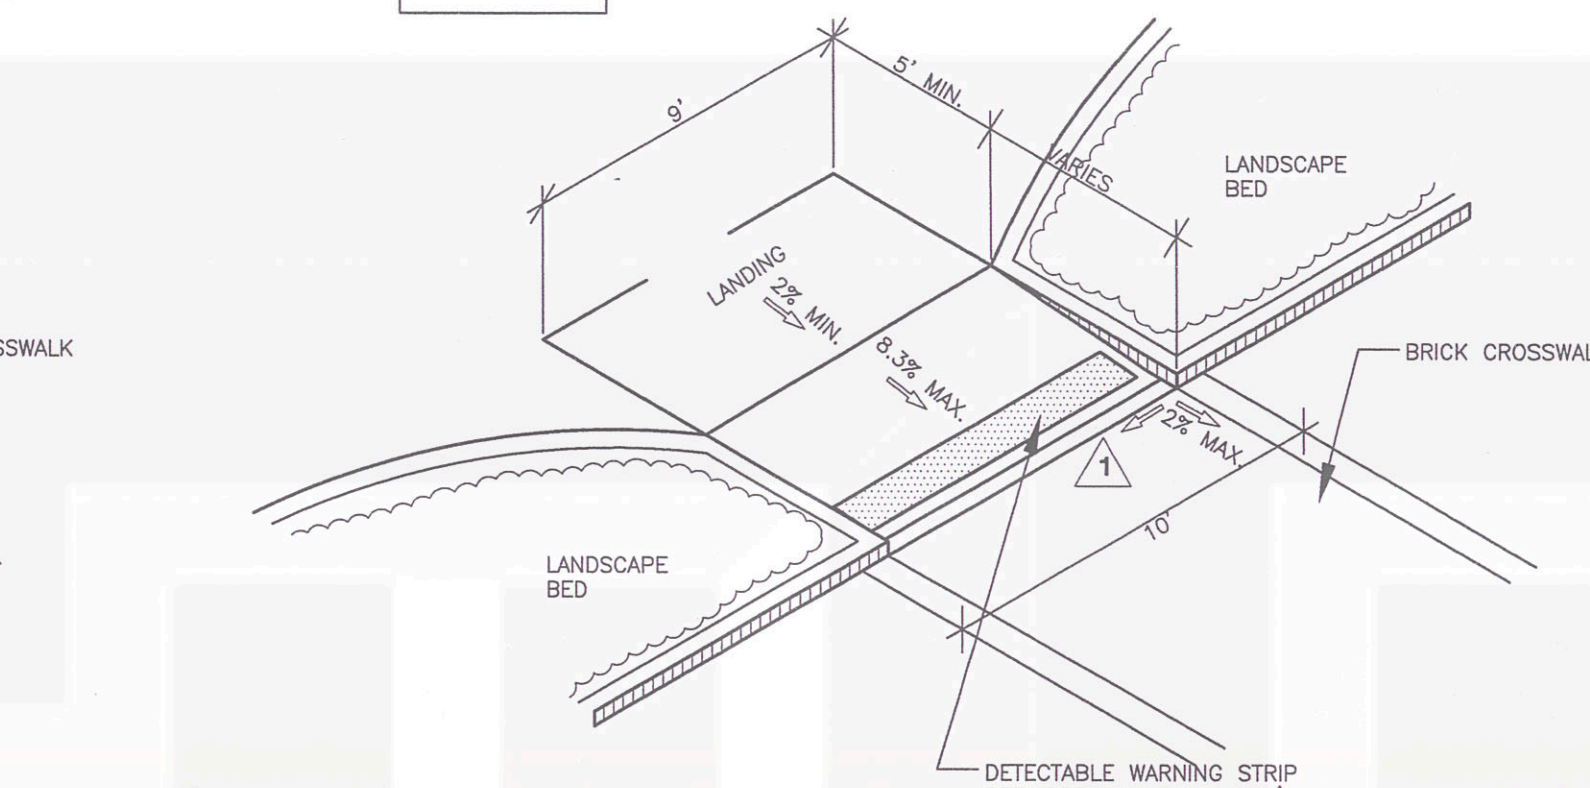


TYPE 2B

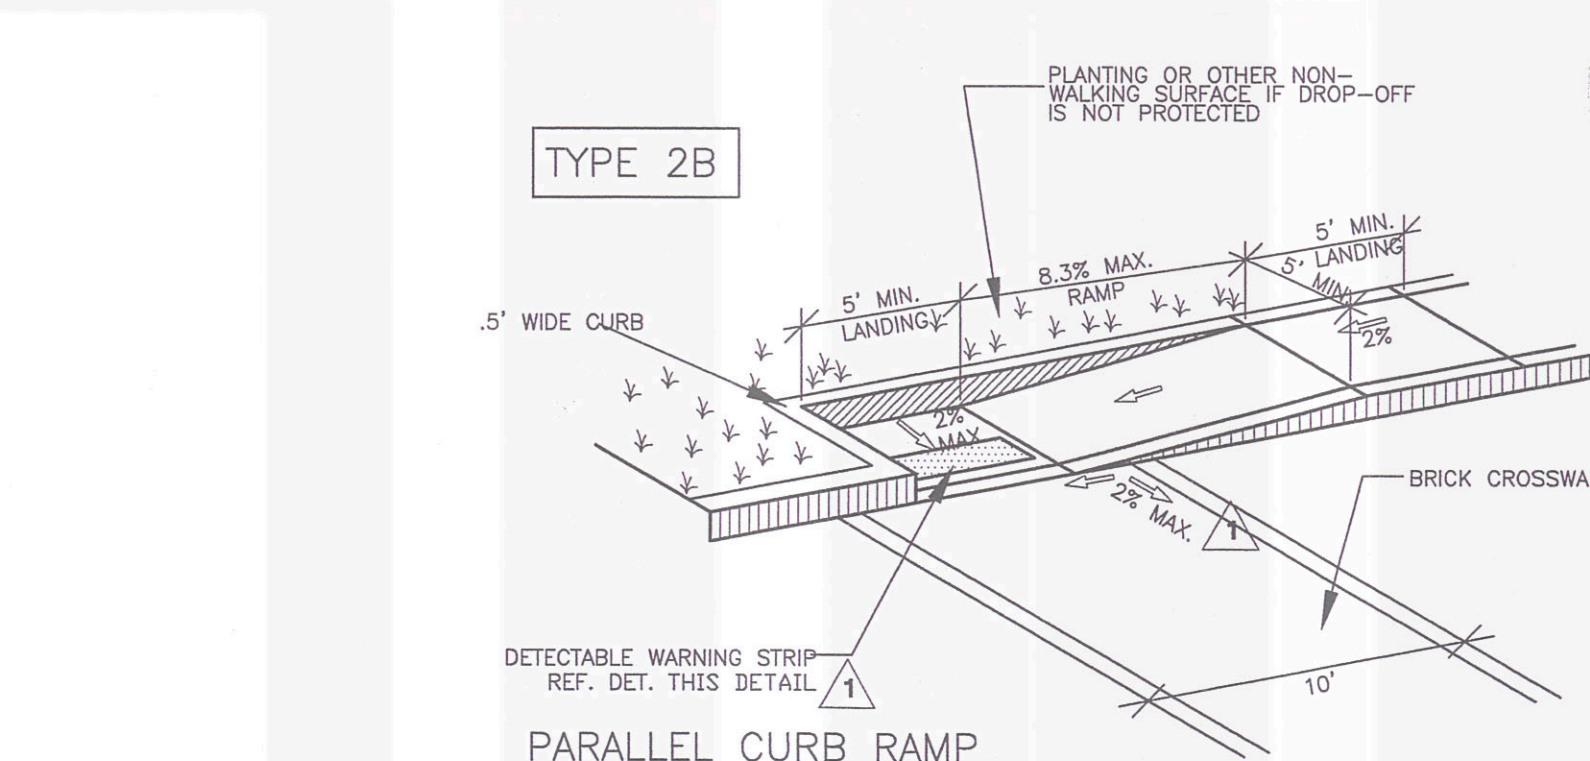


TYPE 21

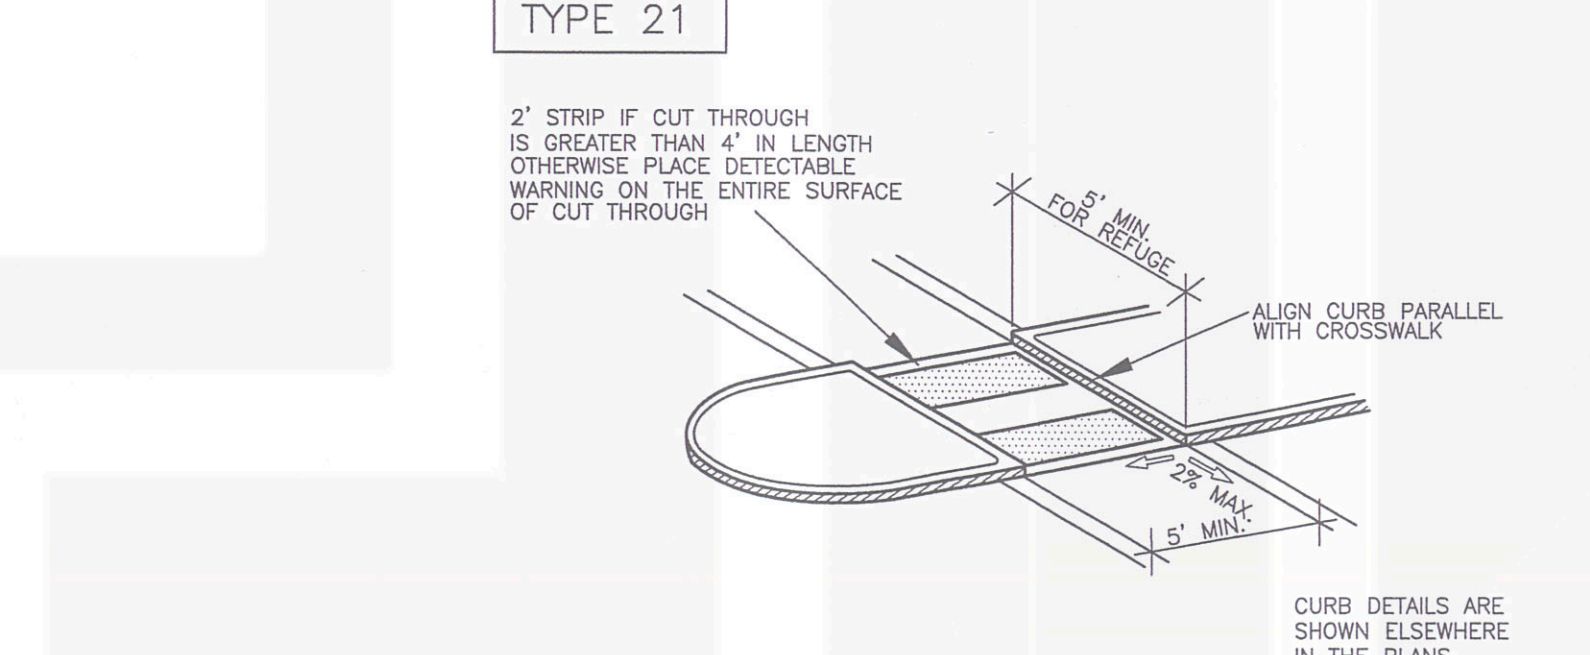

TYPE 21B

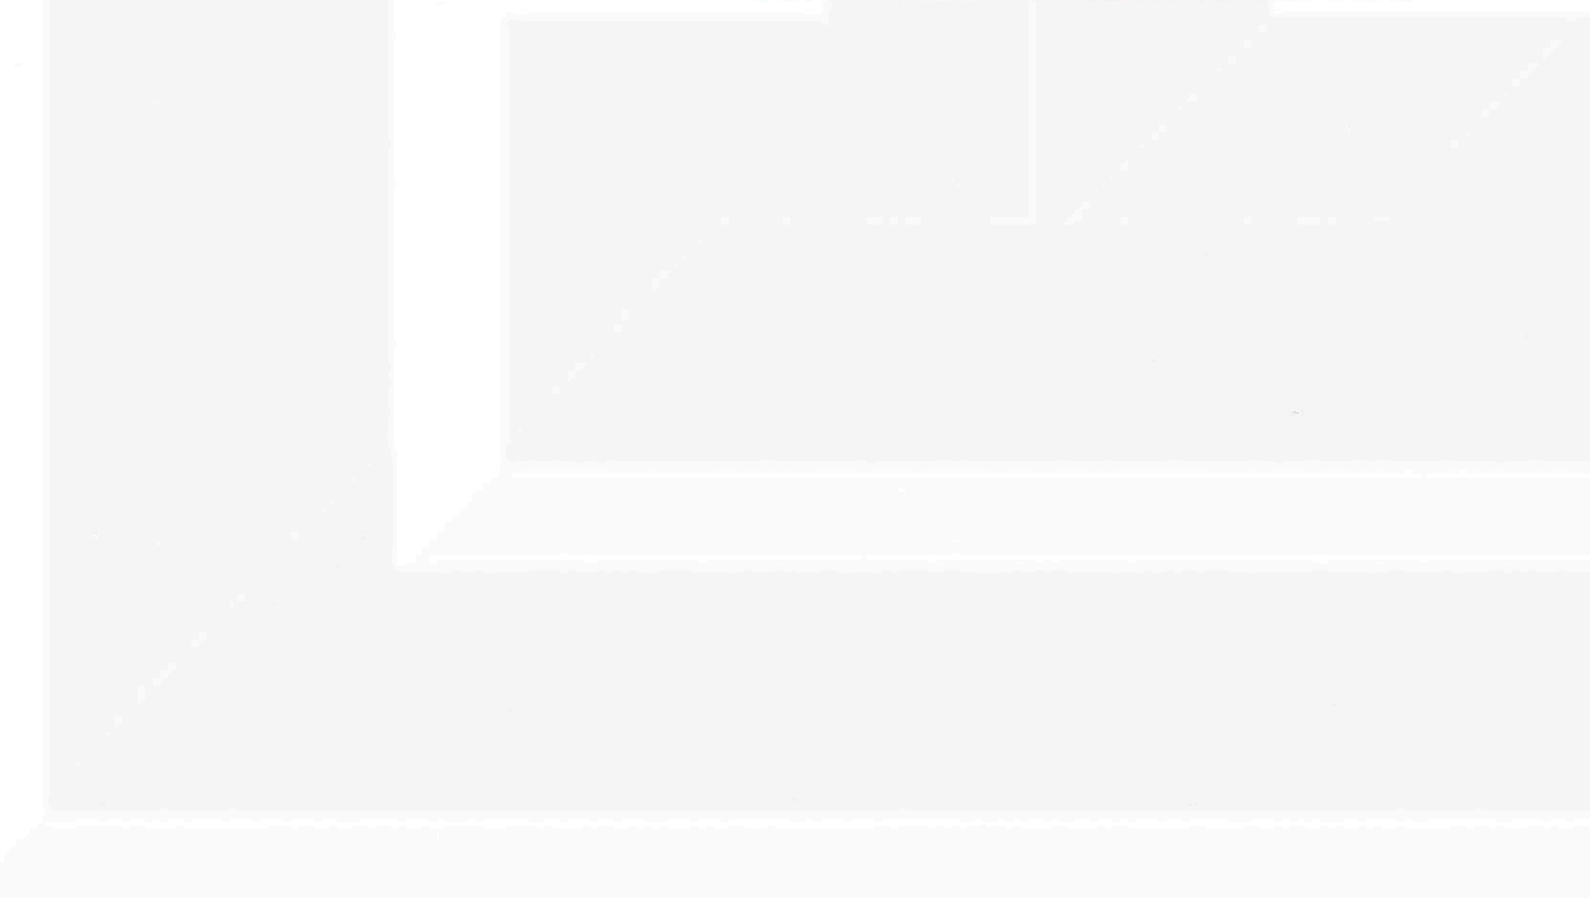


TYPE 21C

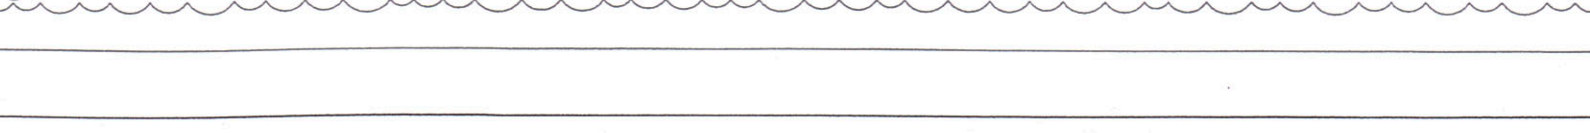


## 4 CURB RAMP DETAILS


TYPE 1A

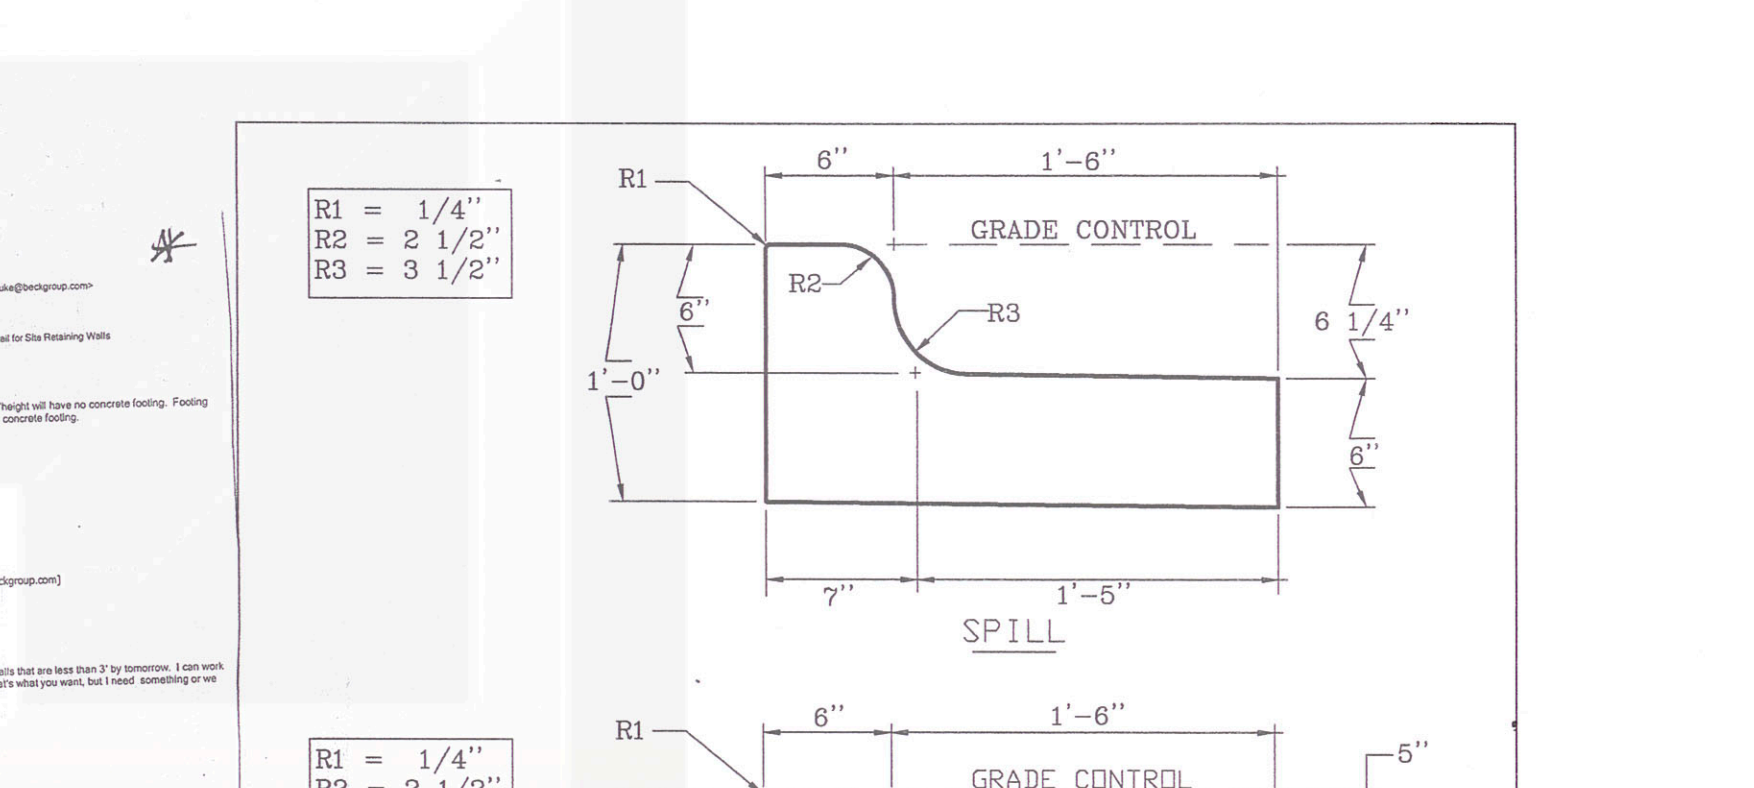


TYPE 1D

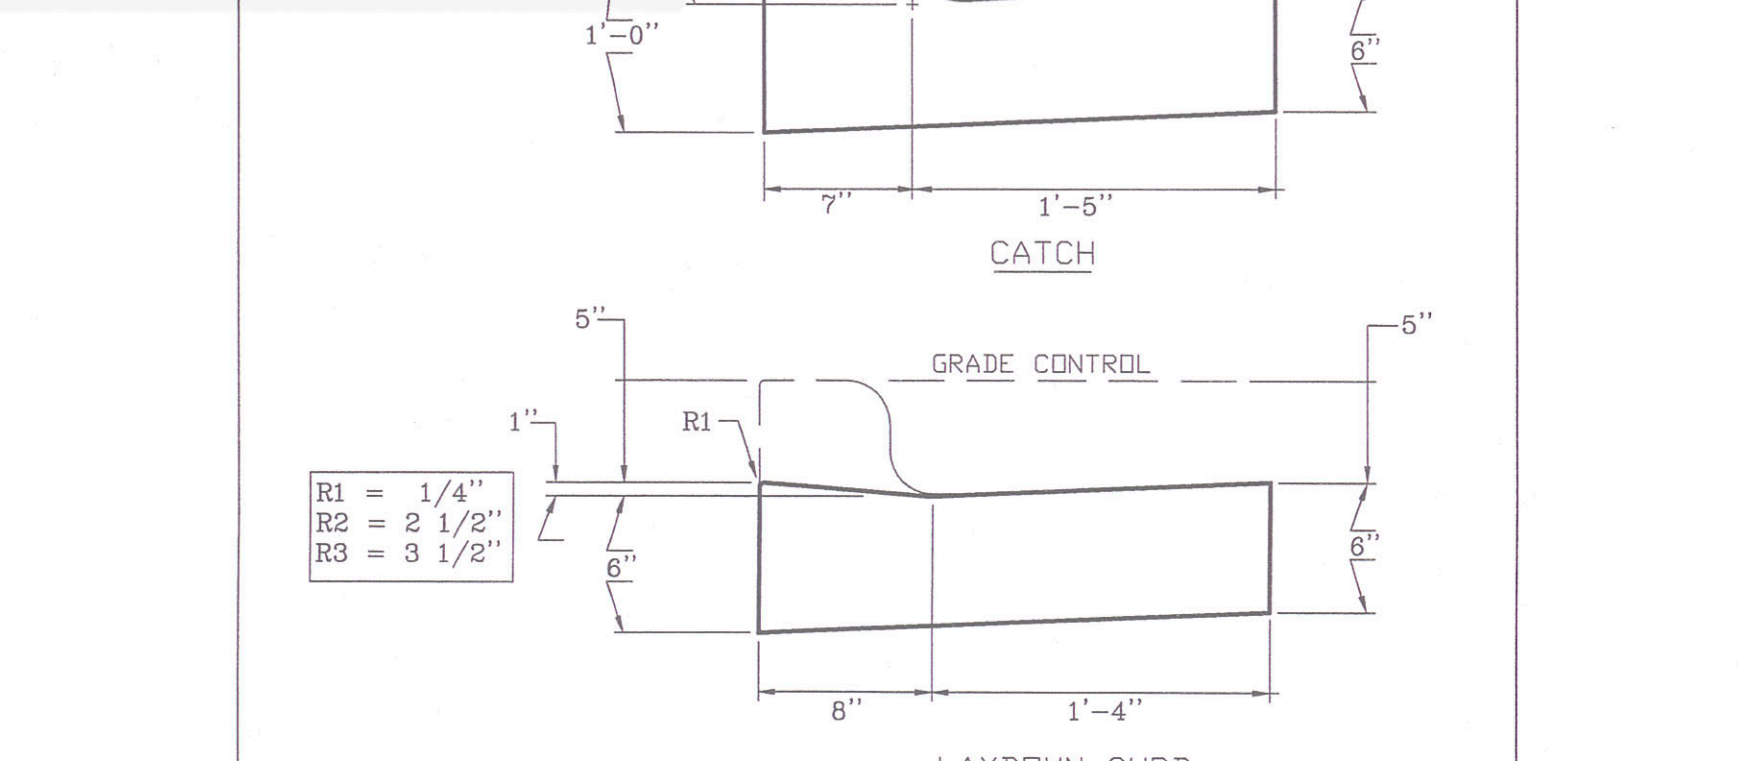


TYPE 7

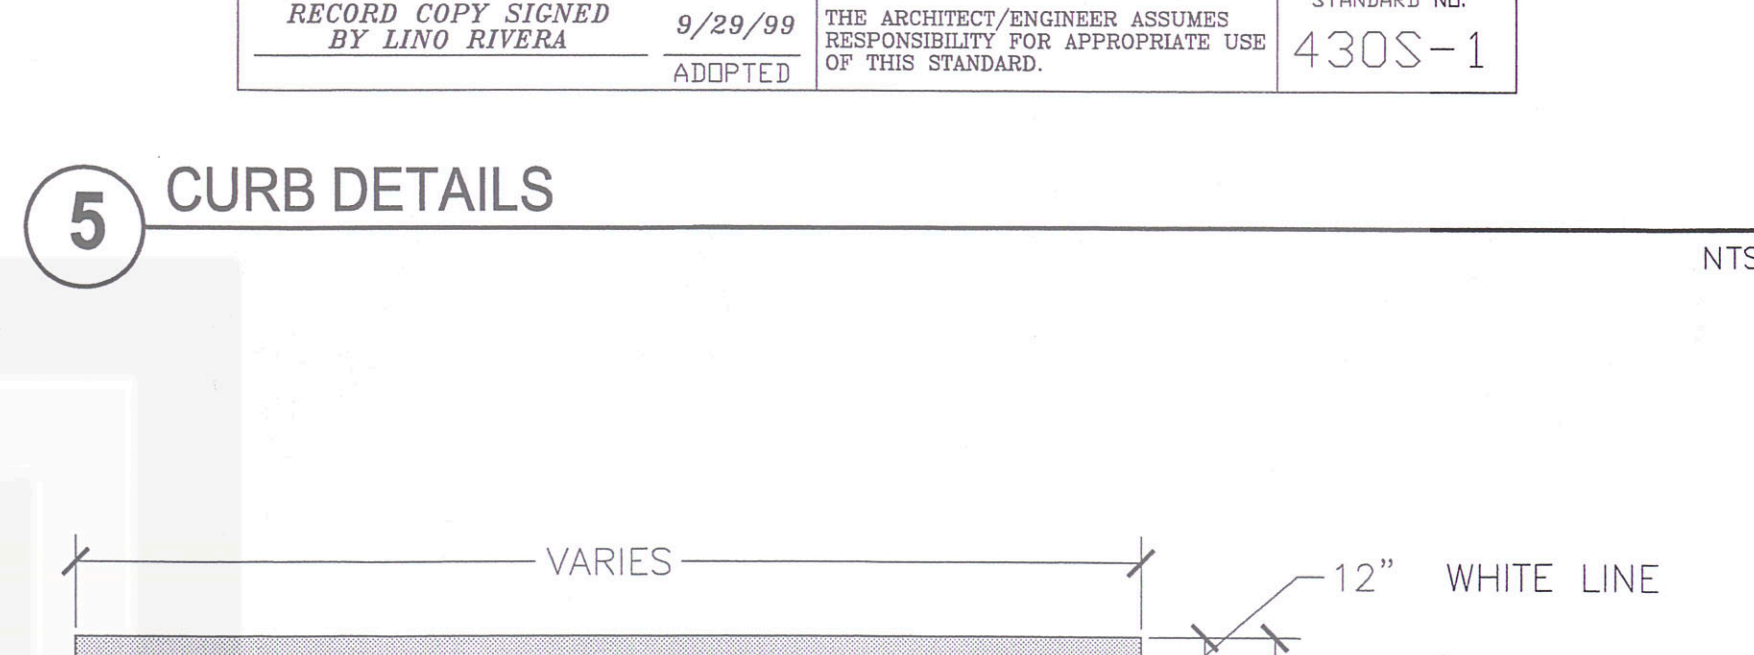


TYPE 5A

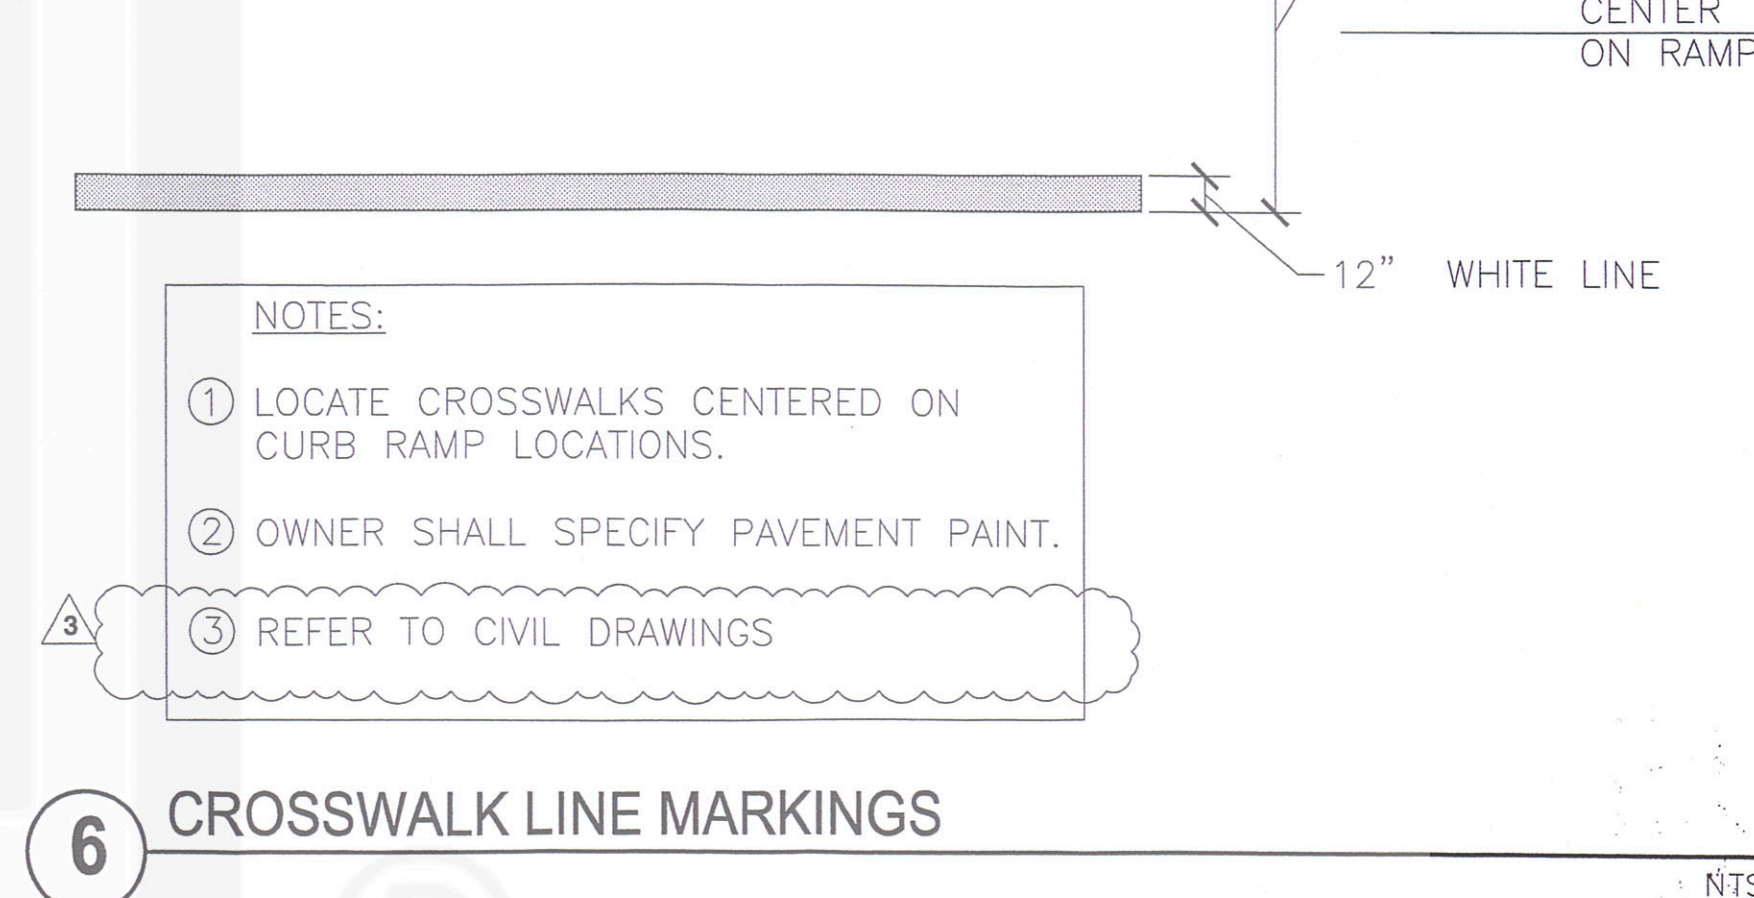

TYPE 5B

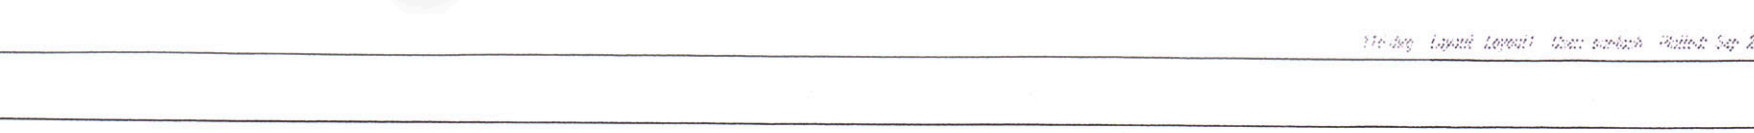


RECORD COPY SIGNED BY LINDA RIVERA 9/29/99

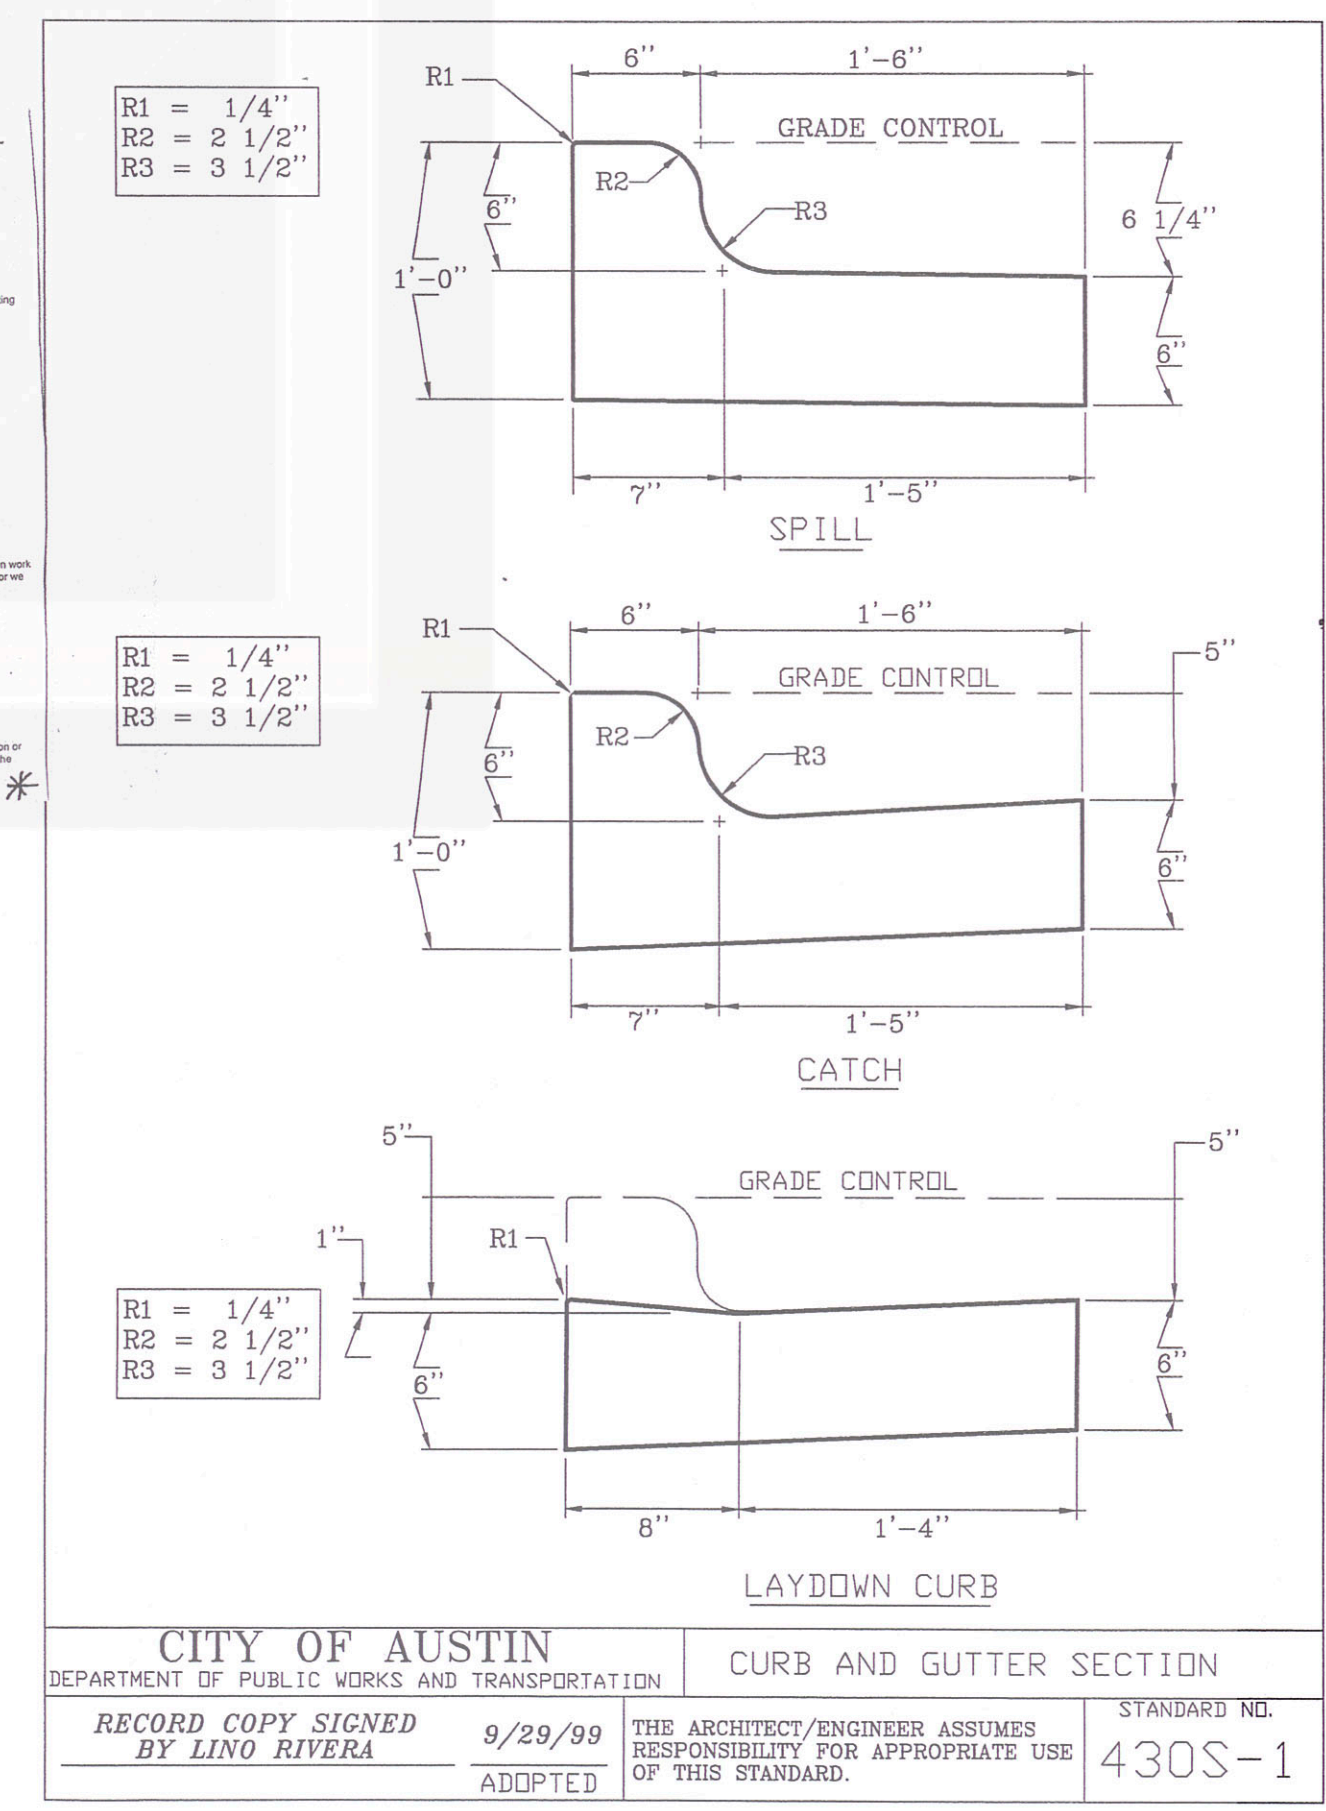


## 5 CURB DETAILS


TYPE 1A

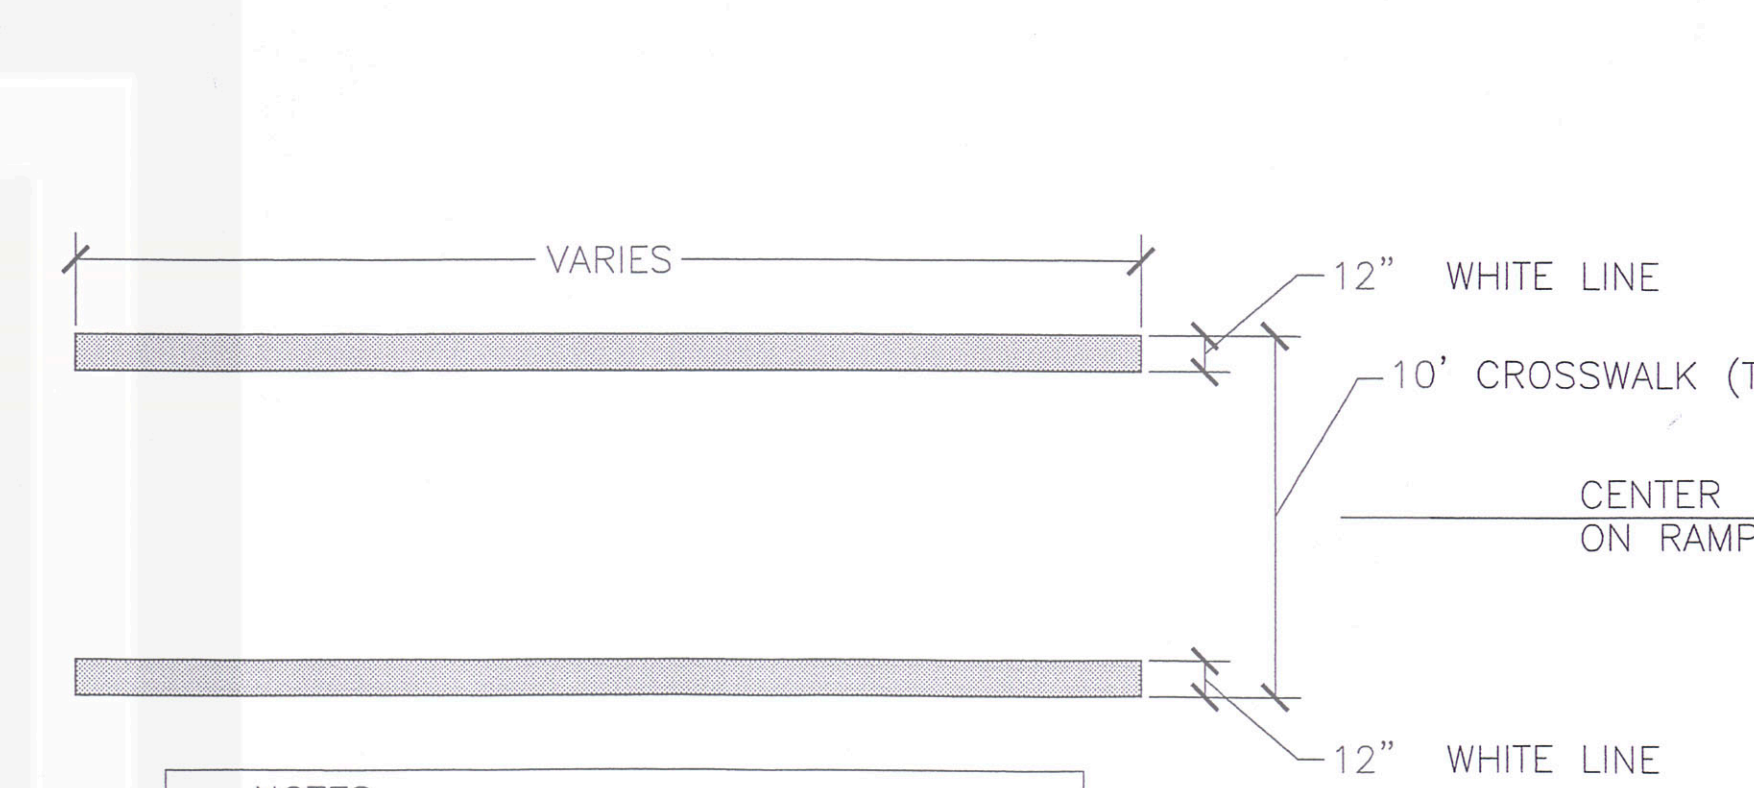

TYPE 1D

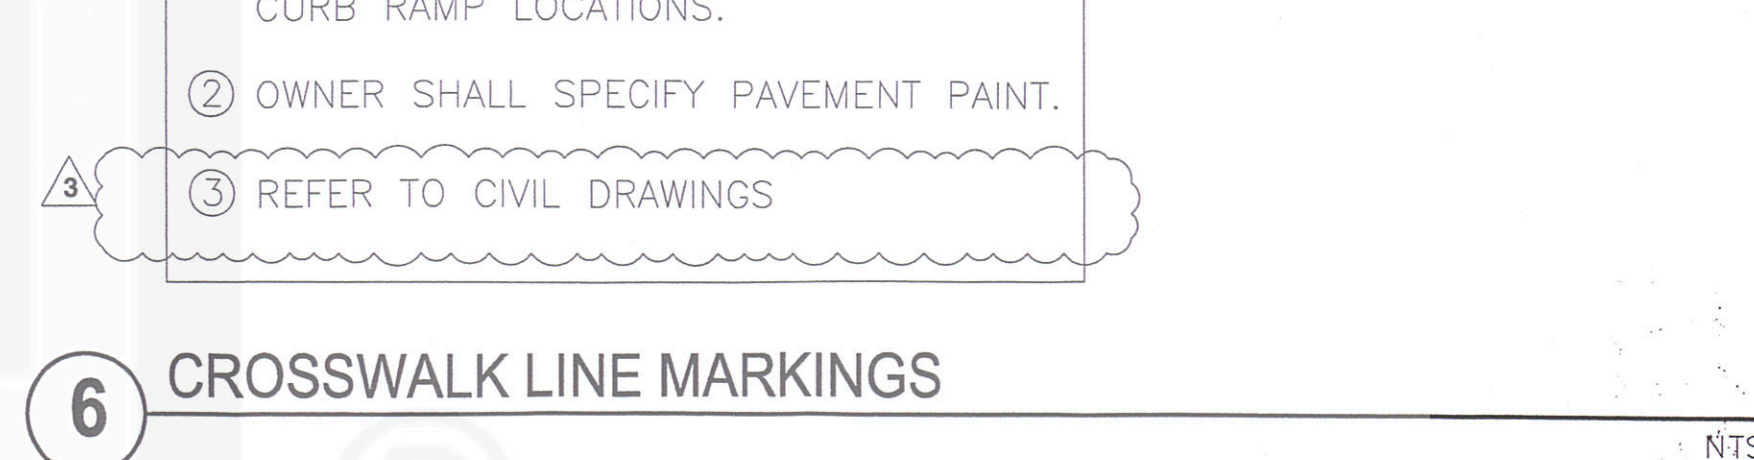


TYPE 7

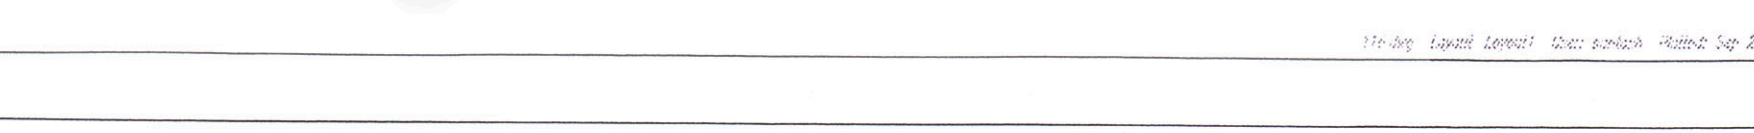

## 6 CROSSWALK LINE MARKINGS

TYPE 1A

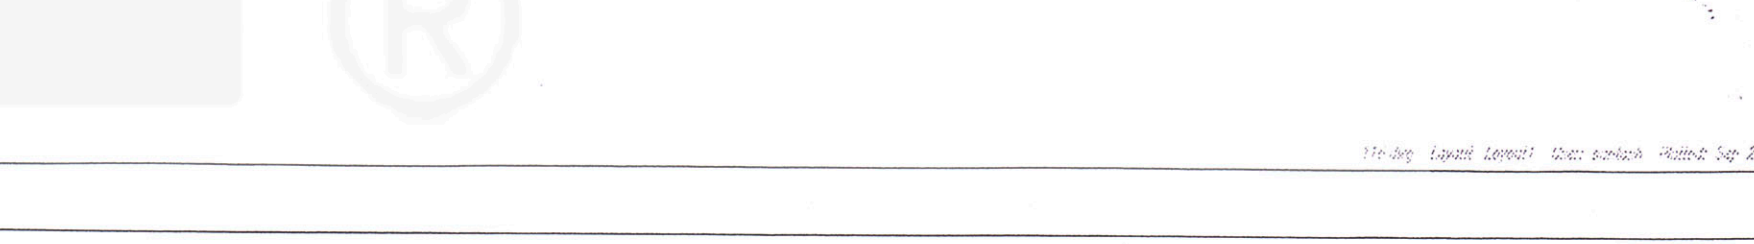

REVISIONS	DATE	DESCRIPTION
1	05/10/06	REVISE DETAILS DUE TO VARIOUS CHANGES (OWNER-REQUESTED, CIVIL, ARCHITECTURAL); REVISED WEEP HOLE SYSTEM ON ROCK WALL
2	05/24/06	REVISE DETAILS DUE TO VARIOUS CHANGES (OWNER-REQUESTED, CIVIL, ARCHITECTURAL); ADDED CROWN LINE DETAIL
3	08/08/06	REVISE CURB RAMP DETAIL VARIOUS CHANGES (OWNER-REQUESTED, CIVIL, ARCHITECTURAL)

A JOINT VENTURE OF:

**SIMON**

**ENDEAVOR**

REAL ESTATE GROUP

J. Robert Anderson, FASLA

landscape architects . austin . texas

3718 MANCHACA ROAD  
AUSTIN, TEXAS 78704  
512.440.1049  
440-8000 FAX

9.27m

09/27/06

Project:

Sheet No.

L1.116

HARDSCAPE DETAILS

RECEIVED

BY 11303

RECORD SET

DATE 04/20/06

PROJECT 11303

PROJECT 11303

