

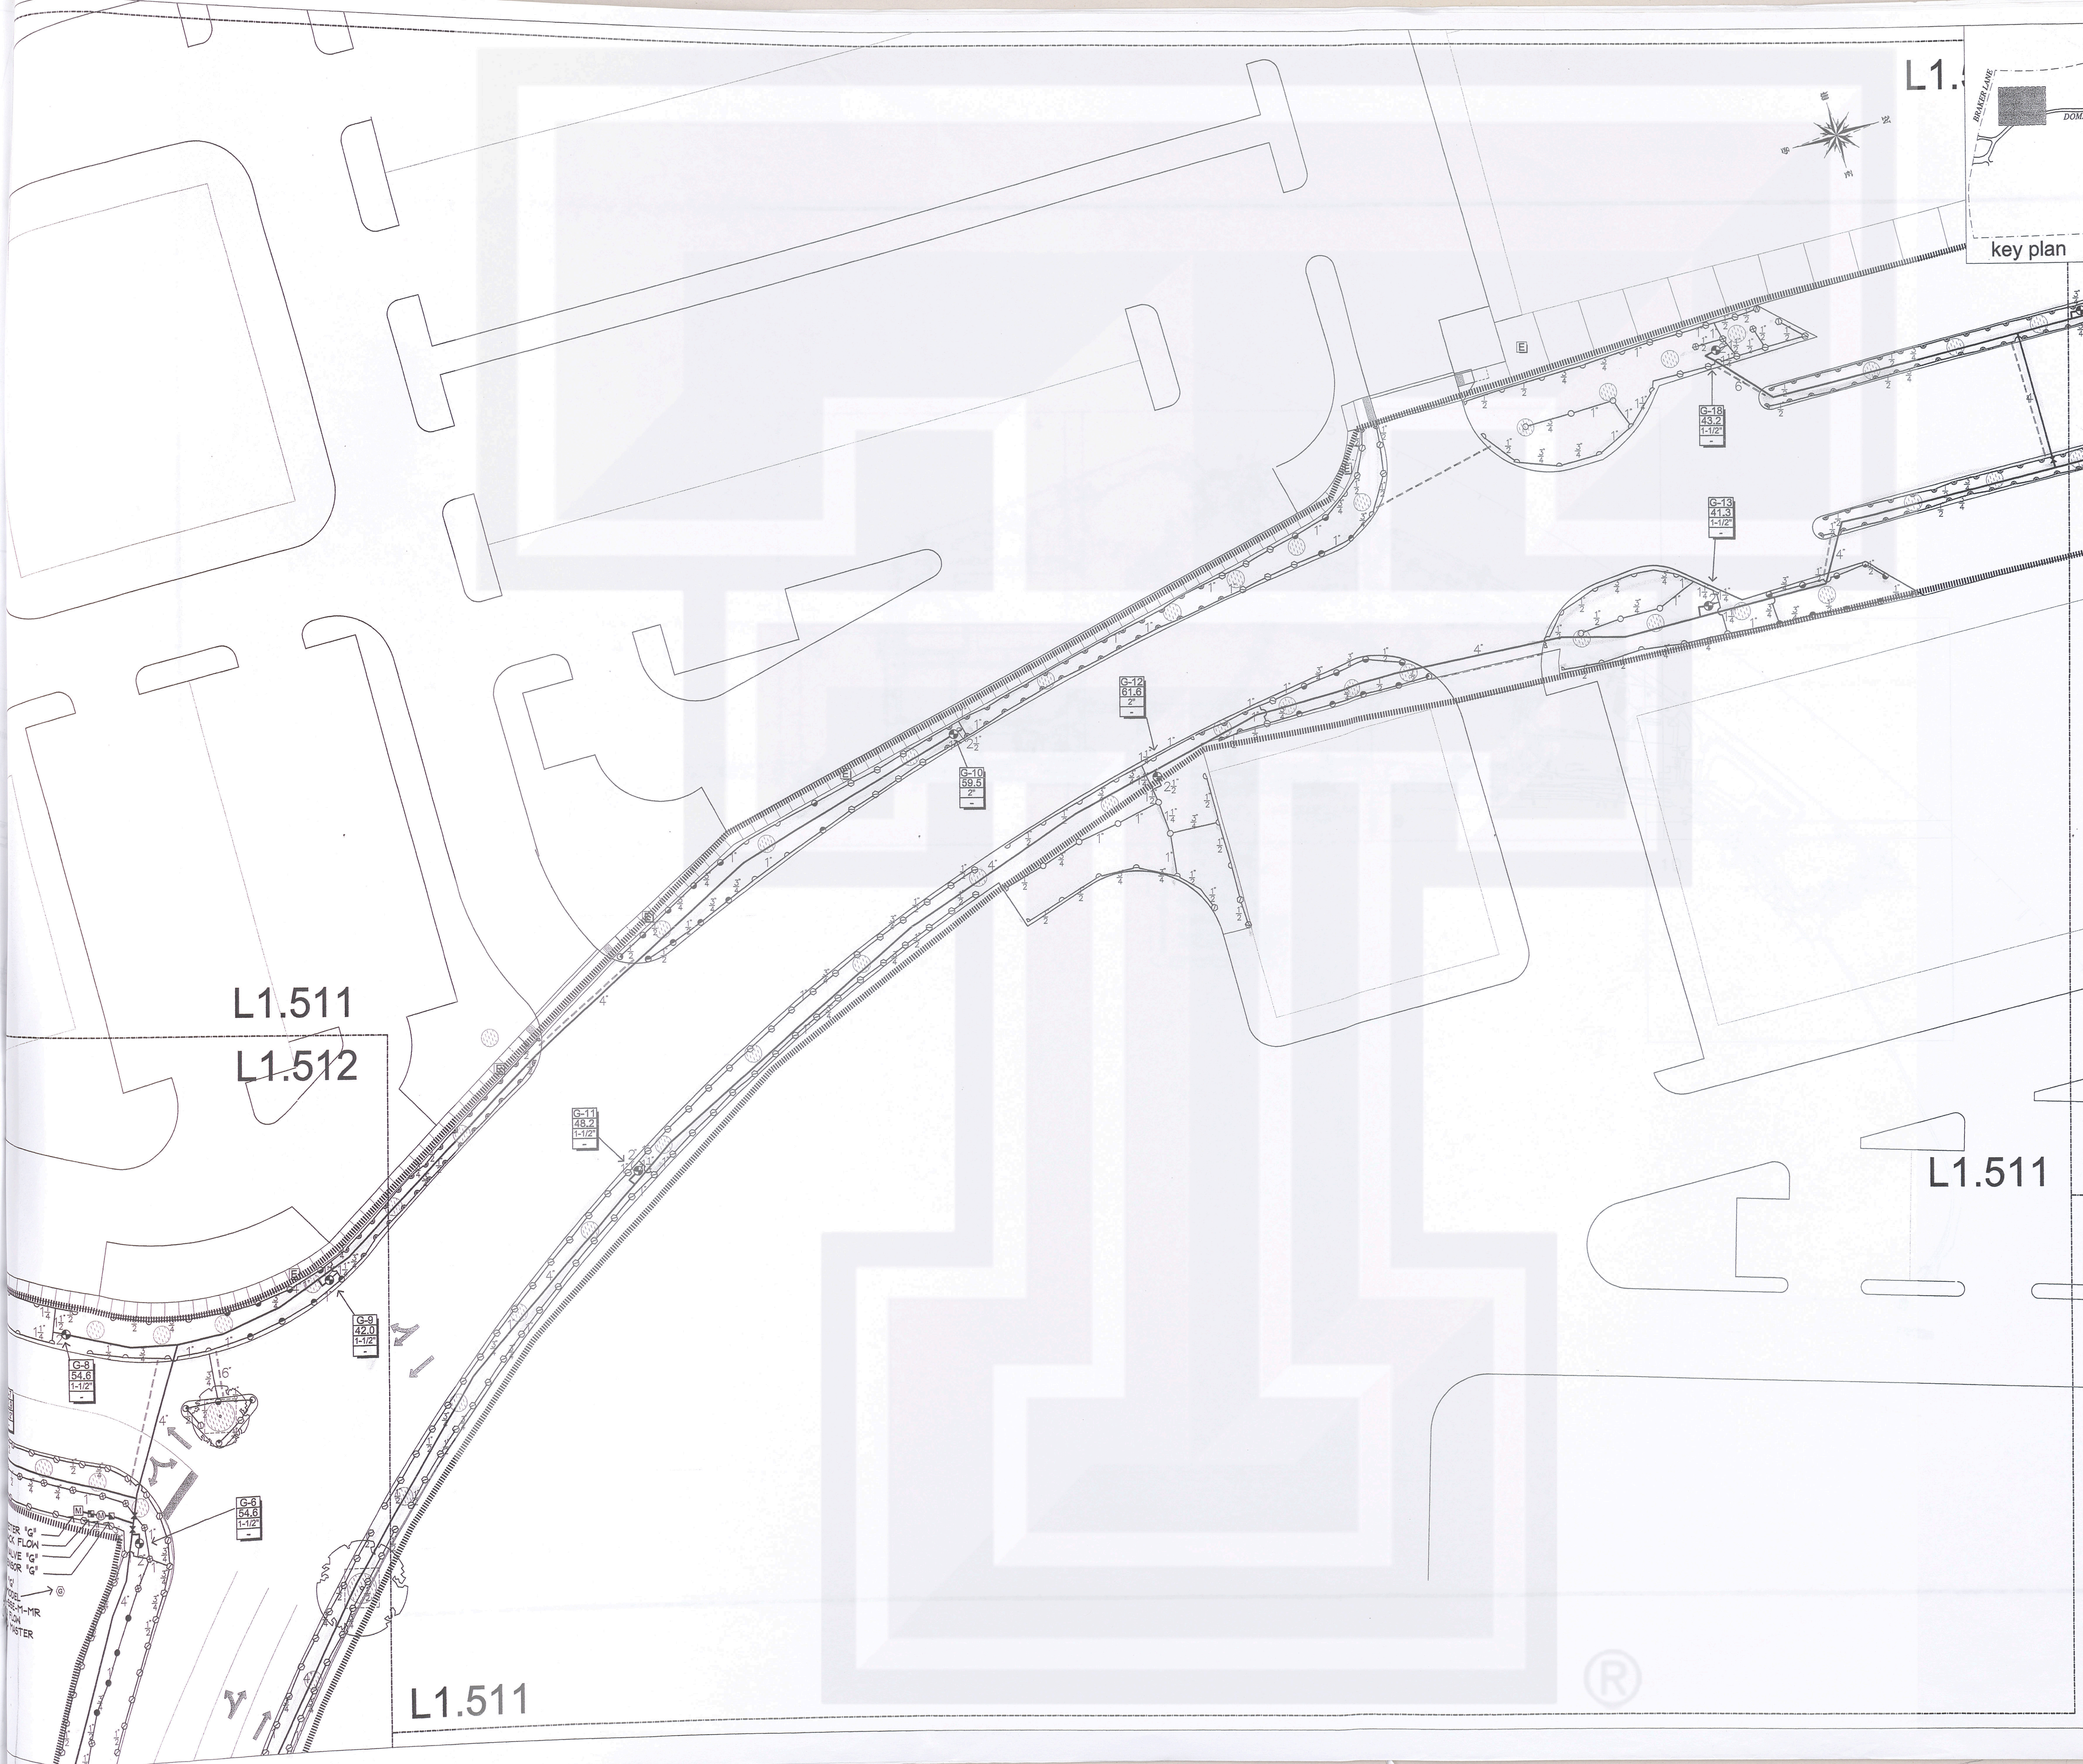


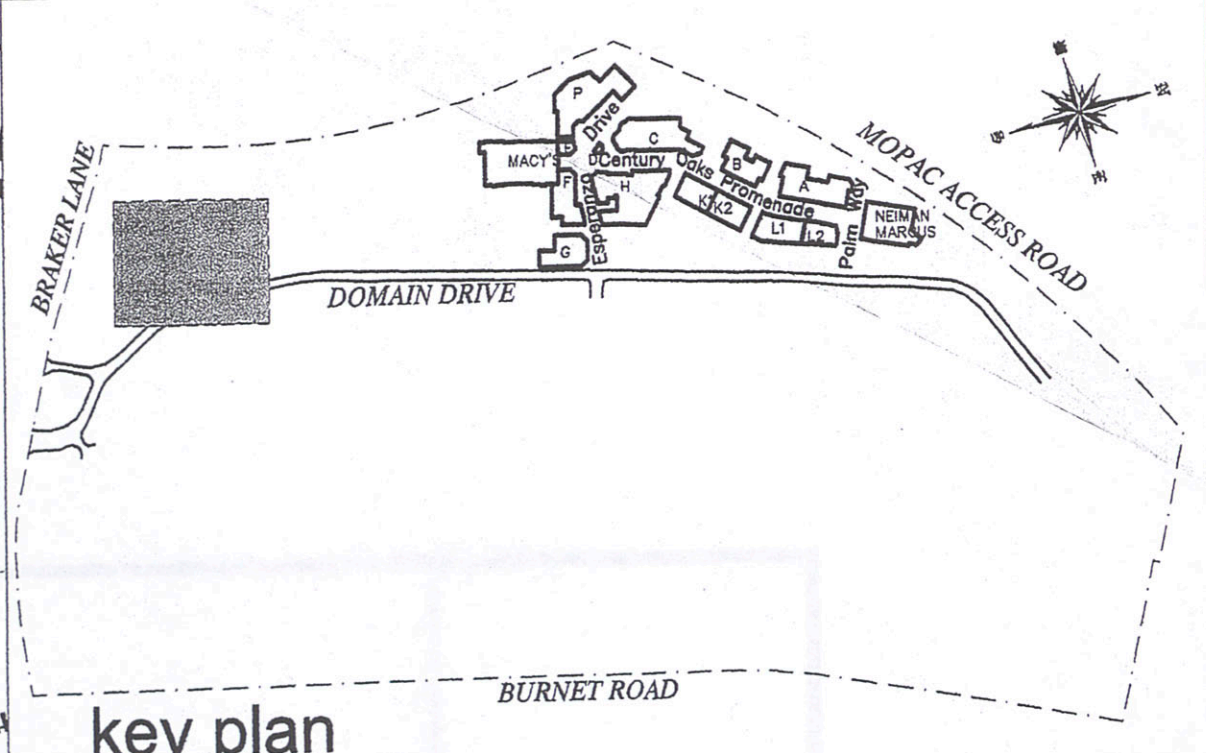

L1.

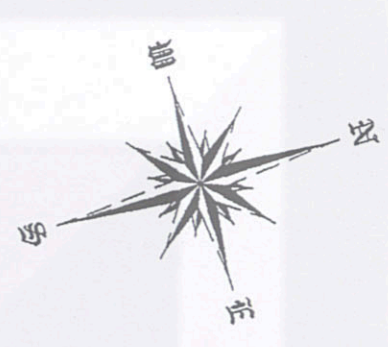


L1.511
L1.512

L1.511

L1.511

A JOINT VENTURE OF:
SIMON
ENDEAVOR
REAL ESTATE GROUP

J. Robert Anderson, FASLA
Landscape Architect - Austin, Texas
5718 Manchaca Road
Austin, Texas 78704
512-440-1000
440-8000 FAX

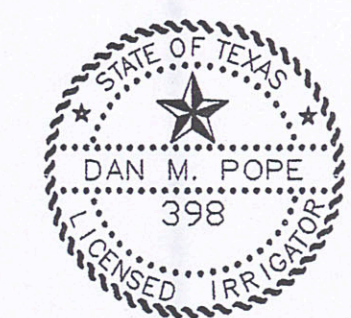

02/10/06
0 10' 20' 40' 60'
SCALE: 1" = 20'

Project:

the domain
AUSTIN, TEXAS

RECEIVED
FEB 15 2006
BY
BECK - AUSTIN
RECORD SET
JPRA ARCHITECTS
31000 Northwestern Suite 100
Farmington Hills Michigan 48334-2585
phone 248 737 0180 fax 248 737 9161

SHEET TITLE:
IRRIGATION PLAN
Sheet No.
L1.511