


IRRIGATION SYSTEM LAYOUT IS DIAGRAMMATIC
EXACT LOCATION OF PIPING, HEADS AND
VALVES SHALL BE ESTABLISHED IN THE
FIELD AT THE TIME OF INSTALLATION.

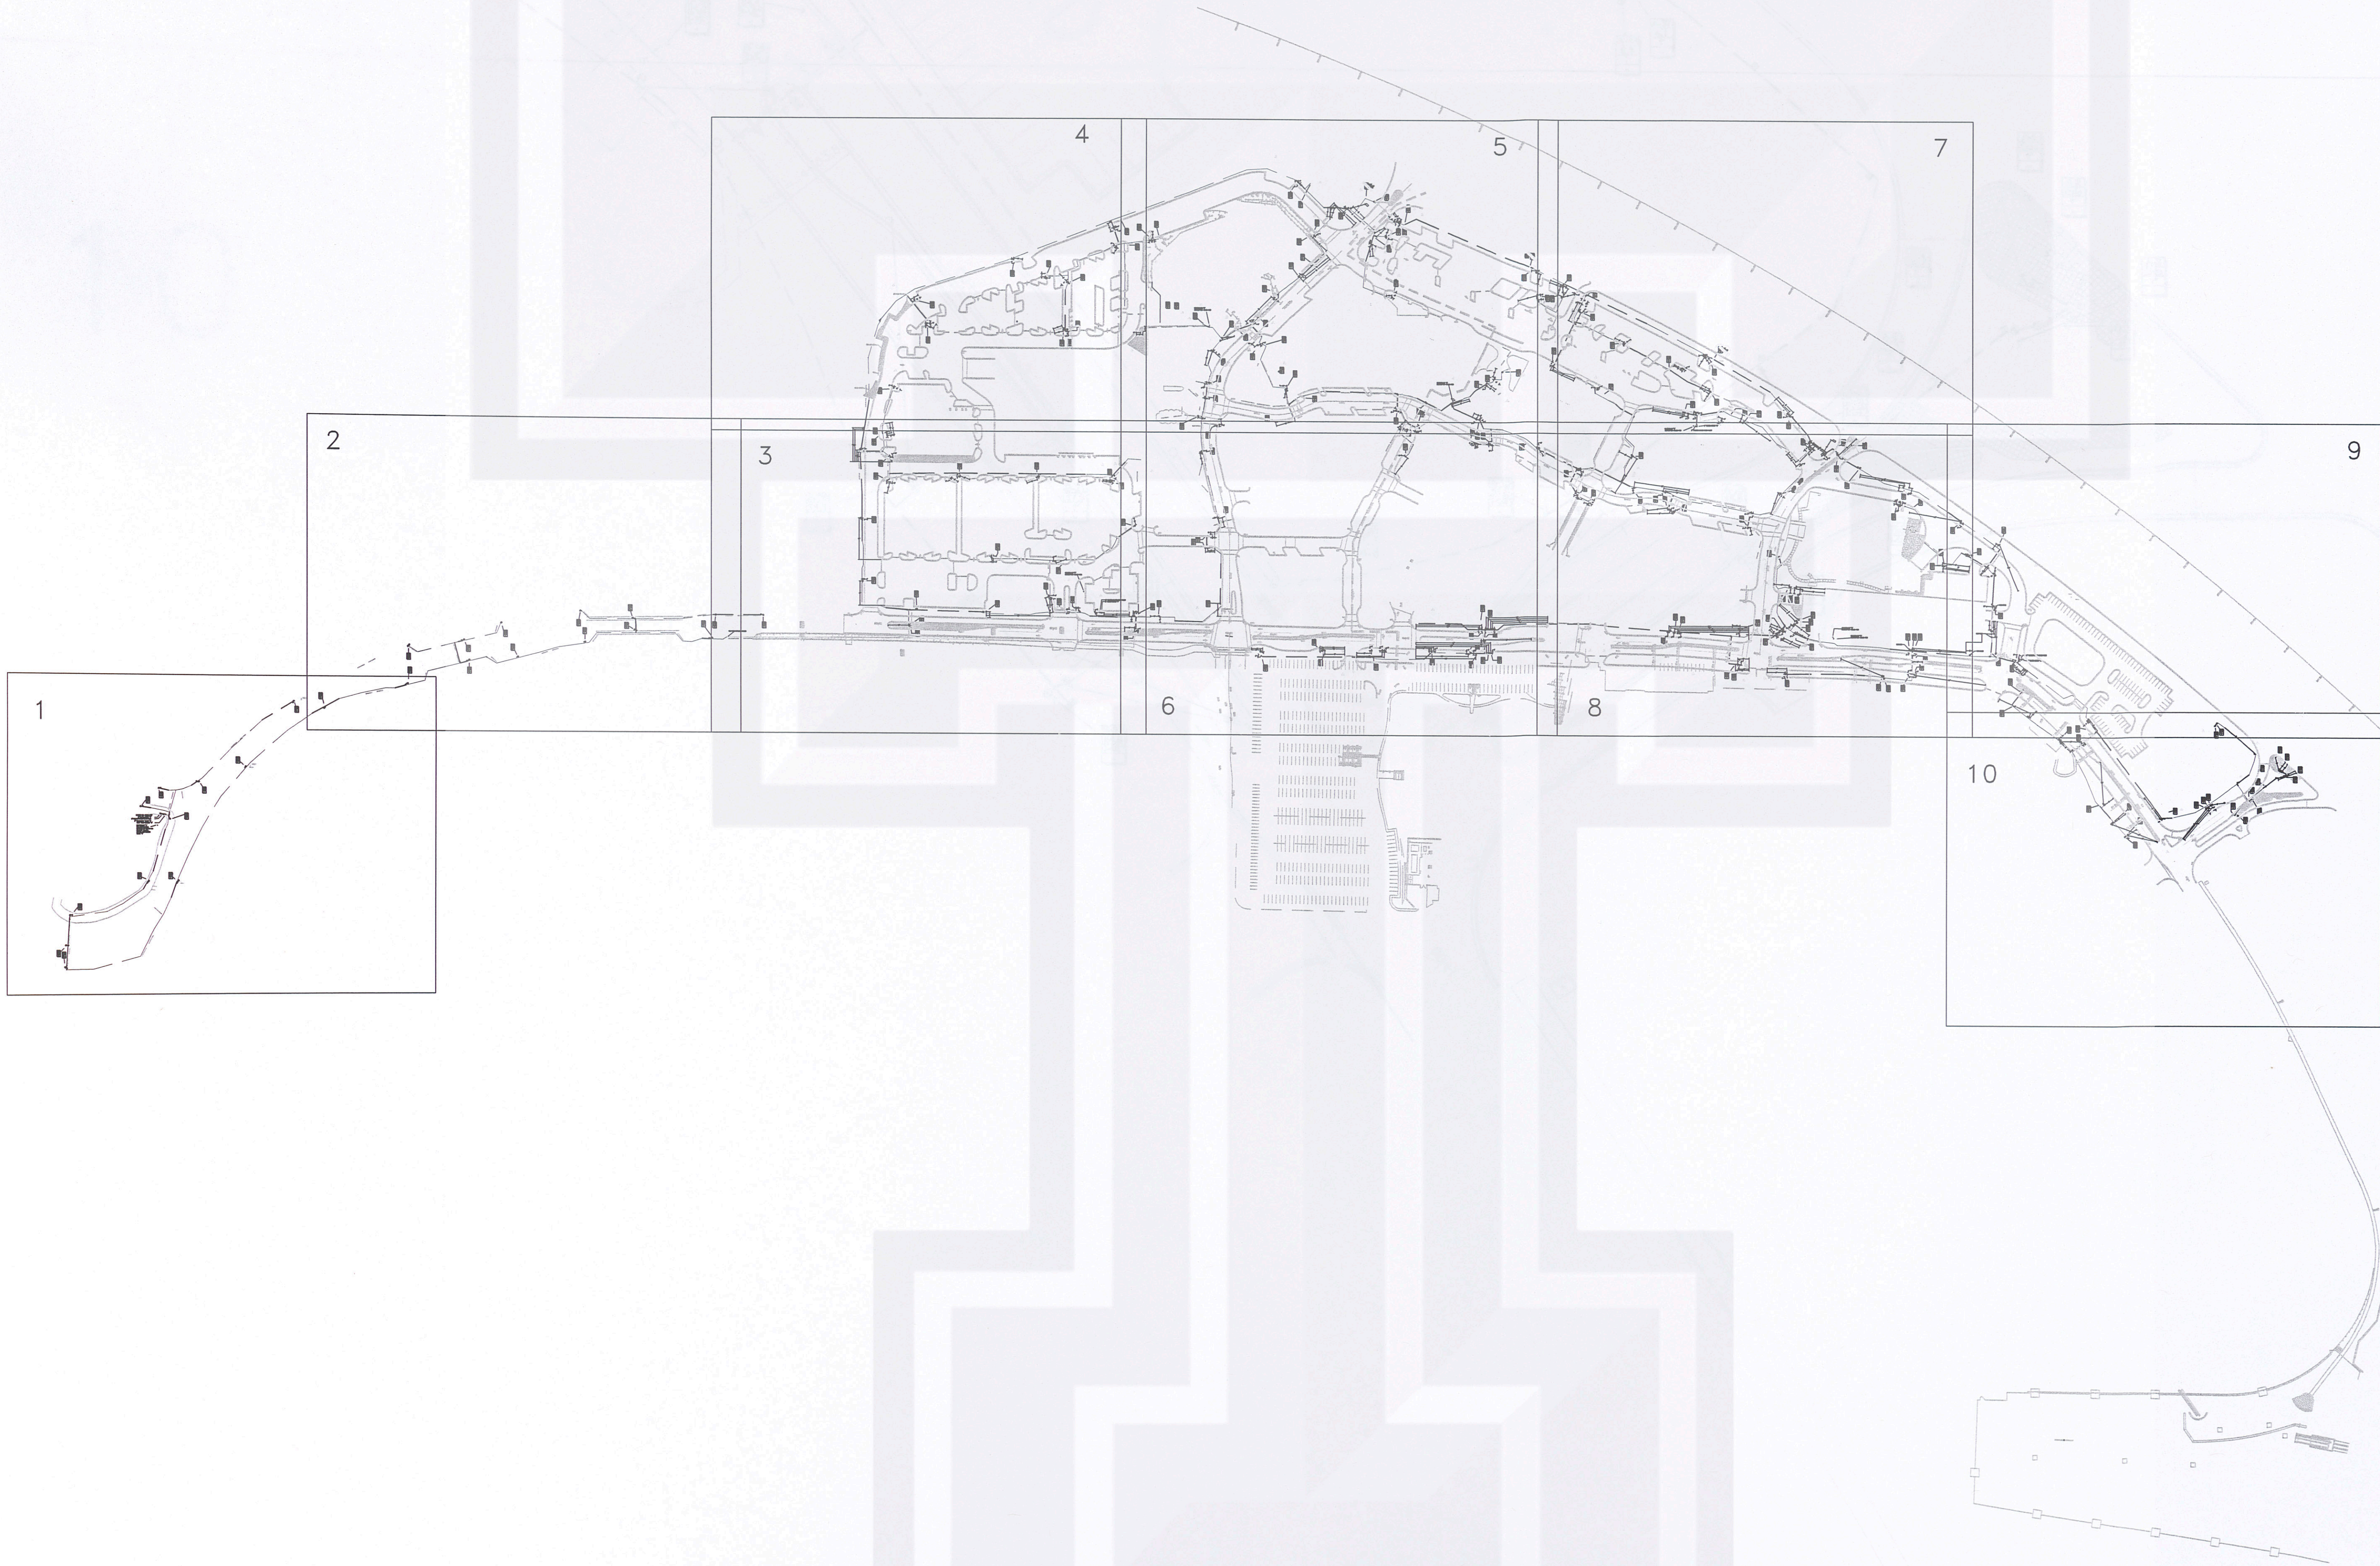

PHOENIX
IRRIGATION

AUSTIN, TX
(512) 282-7394
SAN ANTONIO, TX
(210) 496-5185

PROJECT:

DATE: 06/15/07

SCALE: NONE

PAGE 0 OF 10

AS-BUILT

The Domain

AUSTIN, TEXAS