




IRRIGATION SYSTEM LAYOUT IS DIAGRAMMATIC
EXACT LOCATION OF PIPING, HEADS AND
VALVES SHALL BE ESTABLISHED IN THE
FIELD AT THE TIME OF INSTALLATION.

CONTROLLER "C"
HUNTER ICC-4000M-PED
2" DOUBLE CHECK BACK FLOW
2" WATER METER "C"

MAKE 4" LINE
FROM METER
TO 4" VALVE

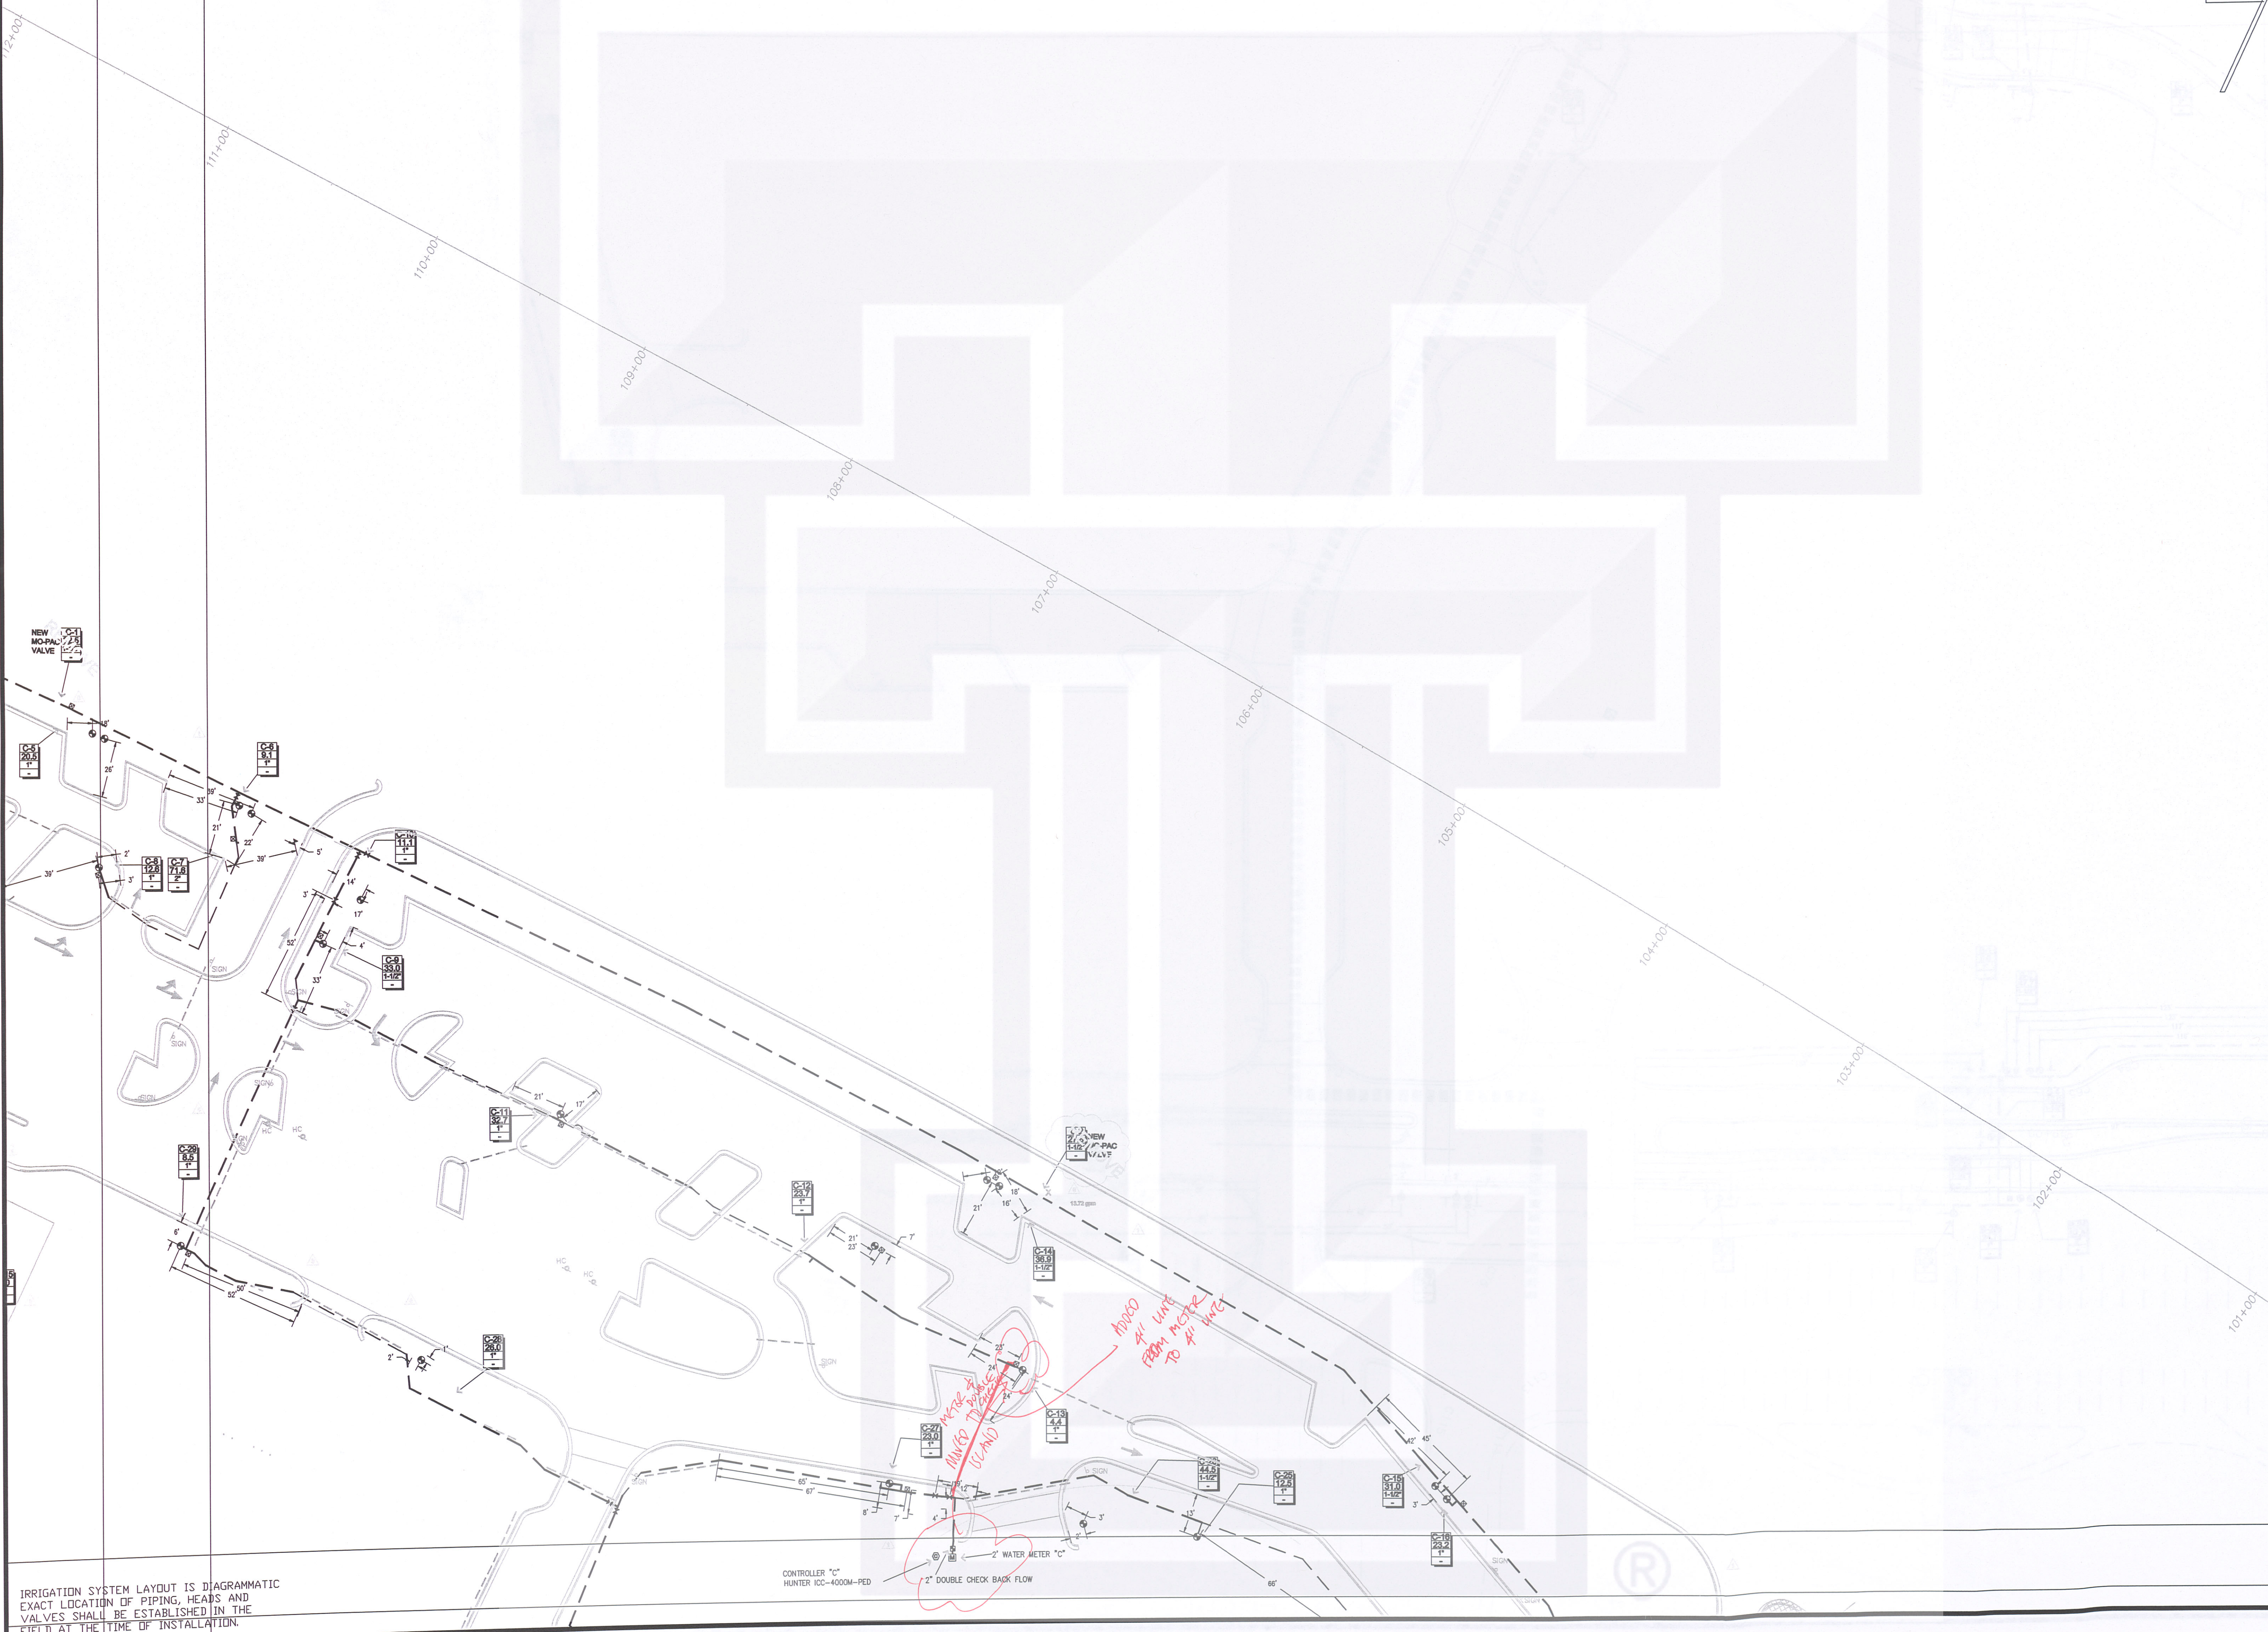

PHOENIX
IRRIGATION

AUSTIN, TX
(512) 282-7394
SAN ANTONIO, TX
(210) 496-5185

DATE: 06/15/07
SCALE: 1"=30' 0"
PAGE 7 OF 10
AS-BUILT

The Domain
AUSTIN, TEXAS

7