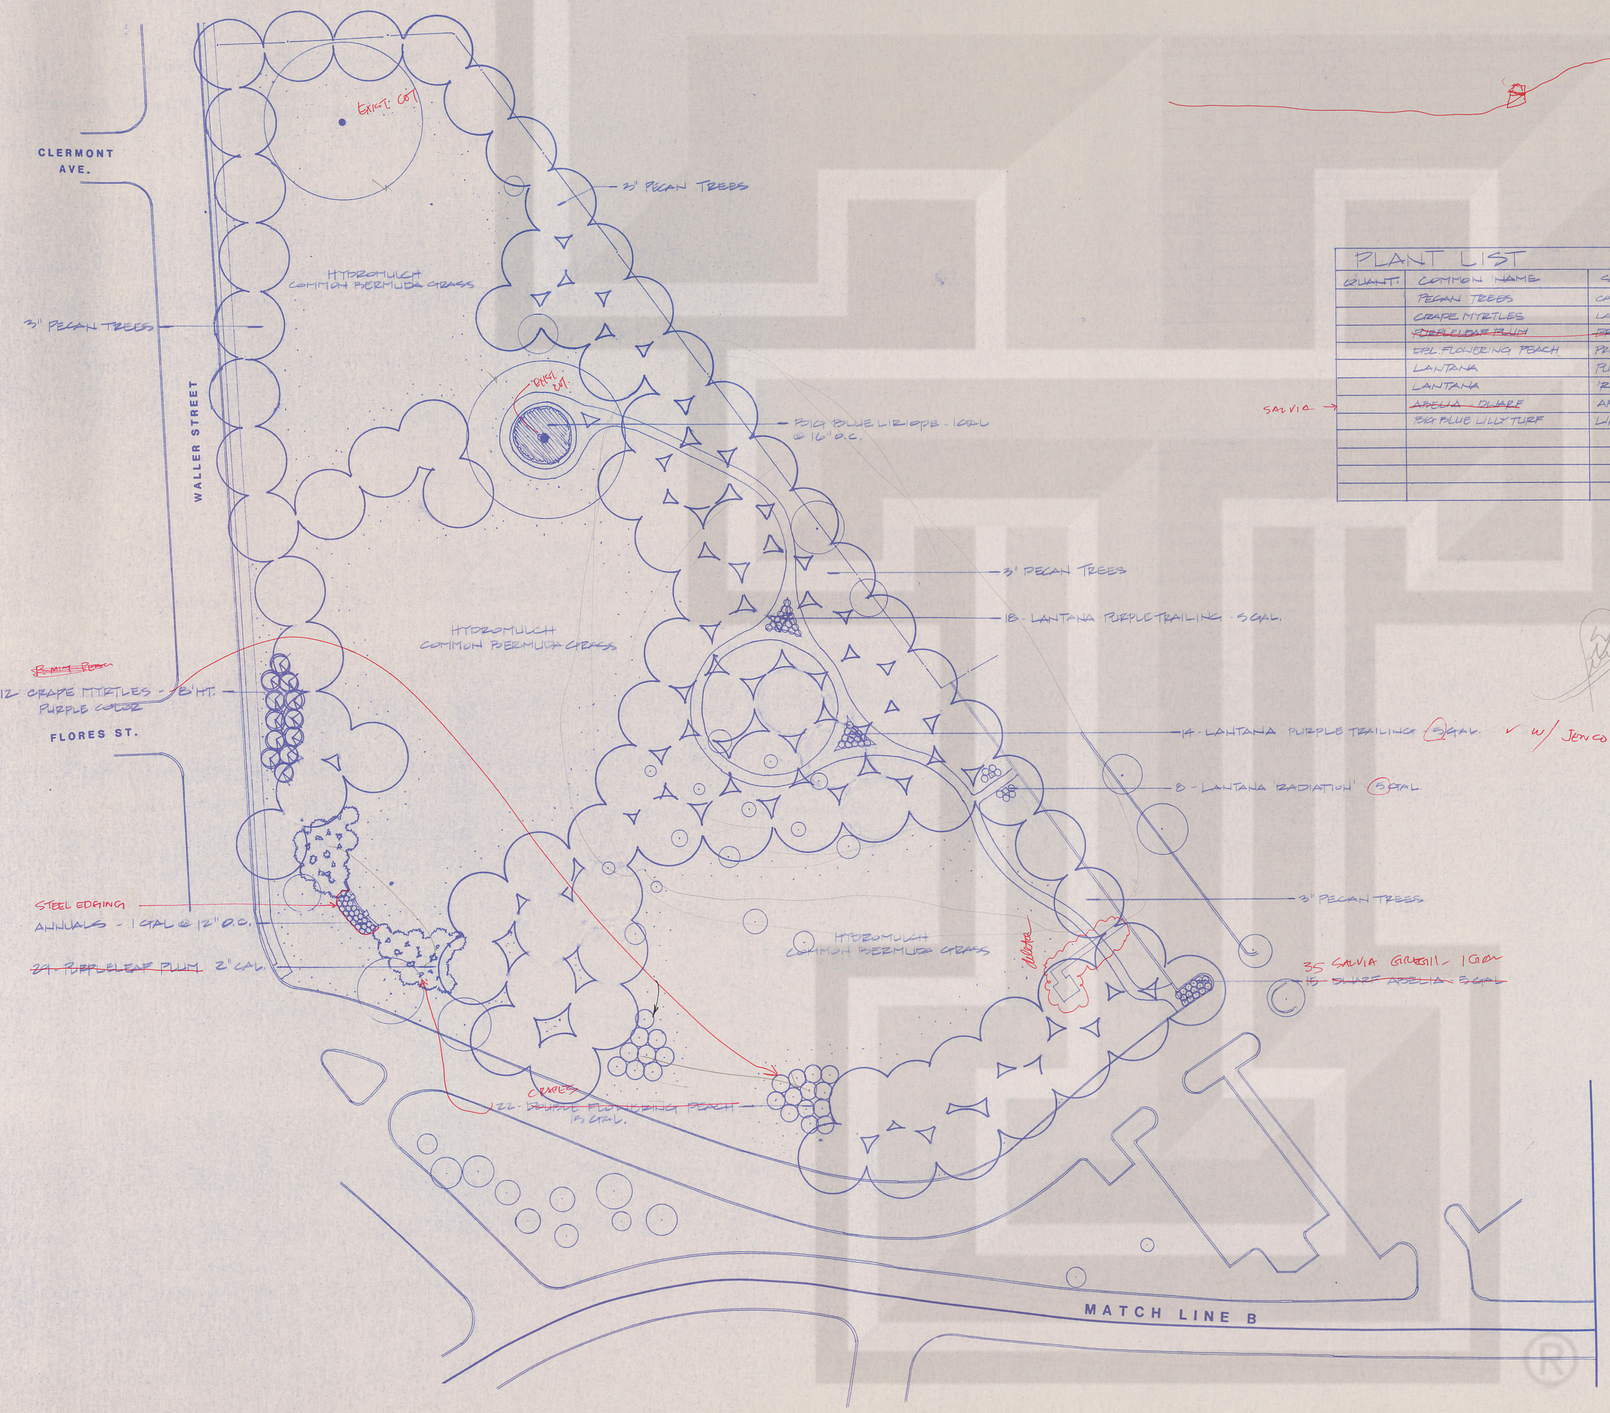

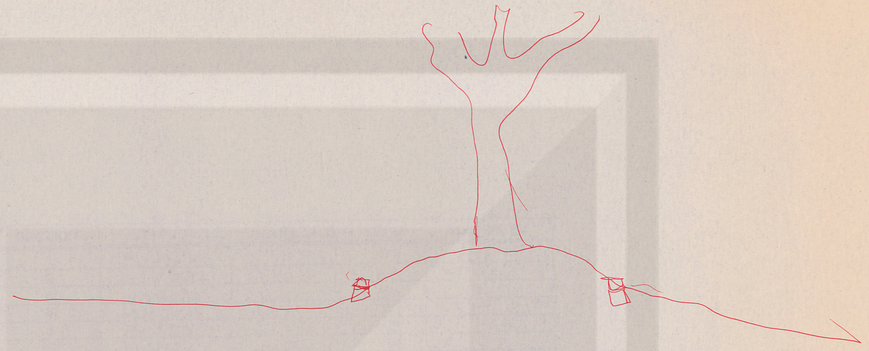

PLANT LIST				
QUANT.	COMMON NAME	SCIENTIFIC NAME	SIZE	REMARKS
	PECAN TREES	CARYA ILLINOENSIS	3" CAL	B&B - FULL HEAD
	CRAPE MYRTLES	LAGERSTROEMIA INDICA	8' HT.	CONT. 'PURPLE'
	~~PURPLELEAF PLUM~~	~~PRUNUS CERACIFERA~~	~~2" CAL~~	~~CONT.~~
	DBL FLOWERING PEACH	PRUNUS PERSICA 'PEPPERMINT'	15 GAL.	CONT.
	LANTANA	PURPLE TRAILING LANTANA	5 GAL.	CONT.
	LANTANA	'RADIATION'	5 GAL	CONT.
SALVIA →	~~APELIA~~ ~~DWARF~~	APELIA GRANDIFLORA 'SEELLIDI'	5 GAL	CONT.
	BIG BLUE LILLYTURF	LIRIOPE MUSCARI 'BIG BLUE'	1 GAL.	CONT. @ 16" O.C.

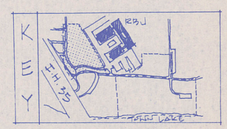

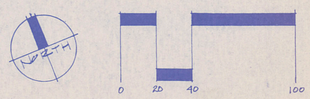

SCALE: 1" = 40' - 0"

RBJ PLANTING PLAN

J. ROBERT ANDERSON, ASLA
LANDSCAPE ARCHITECT - LAND PLANNER
2700 BEE CAVE ROAD, SUITE 120 AUSTIN, TEXAS 78746
512/ 327-9772

LANDSCAPE ARCHITECTURAL DRAWINGS
PHASE I REBECCA BAINES JOHNSON PARK AND FESTIVAL BEACH IMPROVEMENTS

CITY OF AUSTIN
PARKS & RECREATION DEPARTMENT
CIP PROJECT 867793
AUSTIN, TEXAS

DATE
SCALE
REVISIONS
DRAWN BY
SHEET 3 OF