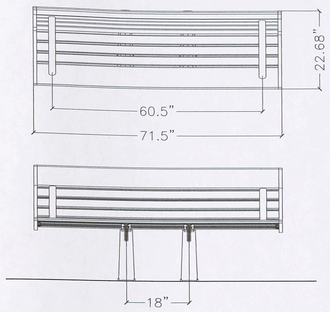

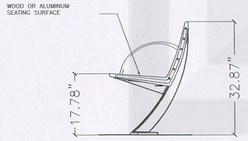

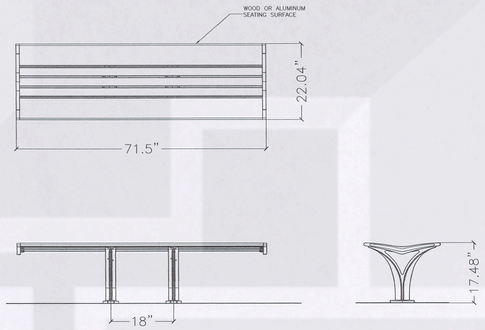

1 BENCH DETAIL

NTS

landscapeforms®
431 LAWNDALE AVE. PHONE: 800-521-2546
KALAMAZOO, MI 49048 FAX: 269-381-3455

CONFIDENTIAL DRAWING INFORMATION CONTAINED HEREIN IS THE PROPERTY OF LANDSCAPE FORMS, INC. INTENDED USE IS LIMITED TO DESIGN PROFESSIONALS SPECIFYING LANDSCAPE FORMS, INC. PRODUCTS AND THEIR DIRECT CLIENTS. DRAWING IS NOT TO BE COPIED OR DISCLOSED TO OTHERS WITHOUT THE CONSENT OF LANDSCAPE FORMS, INC.
©2004 LANDSCAPE FORMS, INC. ALL RIGHTS RESERVED.

TITLE: Backed or Flat Bench – Cantilever
Aluminum or Wood (Jarrah wood)
No Arms
DESIGN: AUSTIN
MOUNTING: Surface
PATENT: D481,211
FILE: 453-01
DATE: 6/8/2004
DRAWN BY: mdk

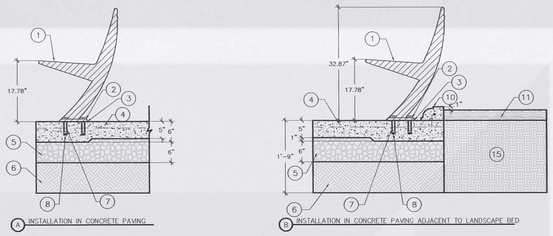

A INSTALLATION IN CONCRETE PAVING

B INSTALLATION IN CONCRETE PAVING ADJACENT TO LANDSCAPE BED

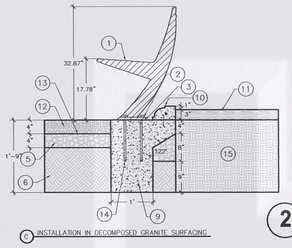

C INSTALLATION IN DECOMPOSED GRANITE SURFACING

KEY:

1. SEATING SURFACE
2. NYLON WASHER BETWEEN ANCHOR WASHER AND SUPPORT
3. NYLON PAD
4. 300 P.S.I CONC. CHROMIX ADMIXTURE REF. MATERIALS PLANS FOR COLOR AND FINISH
5. FLEXIBLE LIMESTONE BASE, COMPACT TO 95%
6. NATIVE SOIL OR FILL, COMPACT TO 95%
7. CORE DRILL CONC. PAVING EPOXY CEMENT FILL
8. 1" x 4" S.S. WEDGE ANCHOR THREAD W/ HEX NUT AND WASHER
9. 300 P.S.I. CONC. FOOTING, 12" x 18" x 46"
10. 4" LAND. CURB, REF. DETAIL 5 SHT L1.113
11. MULCHED LANDSCAPE BED 3" DEPTH
12. 6" DECOMPOSED GRANITE GRAVEL COMPACTED TO 4" DEPTH
13. FILTER FABRIC – SRW PRO PLUS V 502
14. 3/4" x 12" WEDGE EXPANSION ANCHOR, PROVIDE 2 – 18" O.C. FOR EACH LEG
15. PLANTING BED REF. LANDSCAPE DETAILS

2 BENCH INSTALLATION DETAILS

NTS

REVISIONS		
DELTA	DATE	DESCRIPTION
1	05/10/06	REVISE DETAILS DUE TO VARIOUS CHANGES (OWNER-REQUESTED, CIVIL, ARCHITECTURAL)

A JOINT VENTURE OF:

SIMON™ | ENDEAVOR REAL ESTATE GROUP

J. Robert Anderson, FASLA
. landscape architects . austin. texas .
3718 MANCHACA ROAD
AUSTIN, TEXAS 78704
512.440.1049
440-8000 FAX

LICENSED LANDSCAPE ARCHITECT
ROBERT ANDERSON
754
STATE OF TEXAS
9.18.06

09/18/06

Project:

the domain
AUSTIN, TEXAS

JPRA ARCHITECTS
31000 Northwestern Suite 100
Farmington Hills Michigan 48334-2585
phone 248 737 0180 fax 248 737 9161

SHEET TITLE:
HARDSCAPE DETAILS

Sheet No.
L1.115

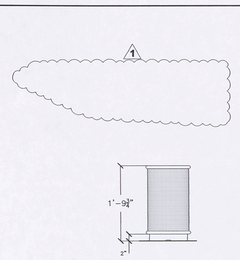

landscapeforms®
431 LAWNDALE AVE. PHONE: 800-521-2546
KALAMAZOO, MI 49048 FAX: 269-381-3455

CONFIDENTIAL DRAWING INFORMATION CONTAINED HEREIN IS THE PROPERTY OF LANDSCAPE FORMS, INC. INTENDED USE IS LIMITED TO DESIGN PROFESSIONALS SPECIFYING LANDSCAPE FORMS, INC. PRODUCTS AND THEIR DIRECT CLIENTS. DRAWING IS NOT TO BE COPIED OR DISCLOSED TO OTHERS WITHOUT THE CONSENT OF LANDSCAPE FORMS, INC.
©1992 LANDSCAPE FORMS, INC. ALL RIGHTS RESERVED.

TITLE: PETOSKEY ASH URN
DESIGN: PESOAKEY
MOUNTING: NONE 1
PATENT: PATENT PENDING
FILE: PK4210
DATE: 01/08/92
DRAWN BY: TAH

3 ASH URN DETAIL

NTS

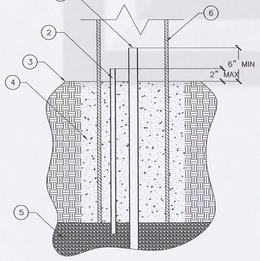

CAST IN PLACE

FAIRWEATHER SITE FURNISHINGS & ACCESSORIES
1525 VIVIAN COURT
PORT ORCHARD, WA 98367-6400
PHONE: 800-323-1798
FAX: 360-895-2626

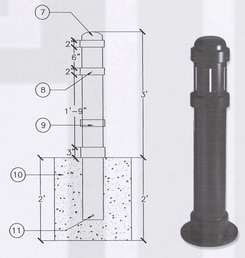

EMBED MOUNTING

TITLE: LED LIGHTED BOLLARD
DESIGN: B-1-L
MOUNTING: GROUND, EMBED MOUNTING

KEY:

1. WIRE CONDUIT BY OTHERS
2. DRAIN CONDUIT BY OTHERS
3. GRADE
4. CONCRETE
5. GRAVEL
6. BOLLARD
7. SCH 40 STEEL CAP
8. DECORATIVE COLLARS (6.62" OD)
9. 5" SCH 10 PIPE (5.56" OD)
10. CONCRETE FOOTING
11. 1/2" HOLE FOR #3 REBAR (REBAR BY OTHERS)

5 BOLLARD DETAIL

NTS

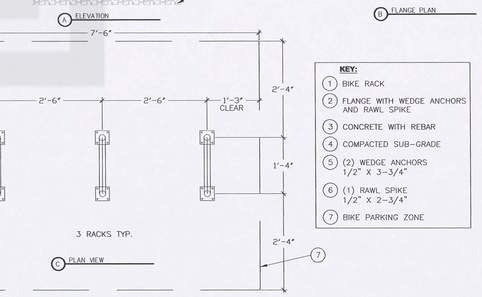

A ELEVATION

B FLANGE PLAN

C PLAN VIEW

KEY:

1. BIKE RACK
2. FLANGE WITH WEDGE ANCHORS AND RAWL SPIKE
3. CONCRETE WITH REBAR
4. COMPACTED SUB-GRADE
5. (2) WEDGE ANCHORS 1/2" X 3-3/4"
6. (1) RAWL SPIKE 1/2" X 2-3/4"
7. BIKE PARKING ZONE

6 BIKE RACK DETAIL

NTS

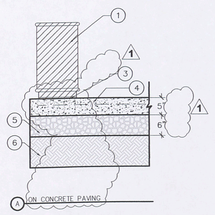

A ON CONCRETE PAVING

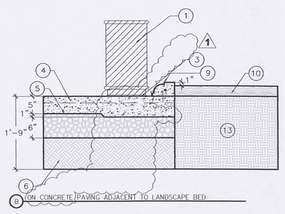

B ON CONCRETE PAVING ADJACENT TO LANDSCAPE BED

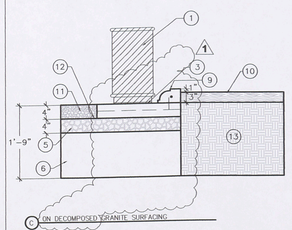

C ON DECOMPOSED GRANITE SURFACING

4 ASH URN INSTALLATION DETAILS

NTS

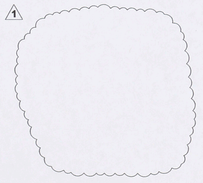

KEY:

1. ASH URN
2. ~~NYLON WASHER BETWEEN ANCHOR WASHER AND SUPPORT~~
3. NYLON PAD
4. 3000 P.S.I. CONC. CHROMIX ADMIXTURE REF. MATERIALS PLANS FOR COLOR AND FINISH
5. FLEXIBLE LIMESTONE BASE, COMPACT TO 95%
6. NATIVE SOIL, OR FILL, COMPACT TO 95%
7. ~~CORE DRILL CONC. PAVING EPOXY CEMENT FILL~~
8. ~~3/8" S.S. WEDGE ANCHOR THREAD W/ HEX NUT AND WASHER~~
9. 4" LAND. CURB REF. DETAIL 5 SHT L1.113
10. MULCHED LANDSCAPE BED 3" DEPTH
11. 6" DECOMPOSED GRANITE GRAVEL COMPACTED TO 4" DEPTH.
12. FILTER FABRIC – SRW PRO PLUS V 502.
13. PLANTING BED REF LANDSCAPE DETAILS
14. ANCHOR HOLES (2X)
15. ANCHOR TAB

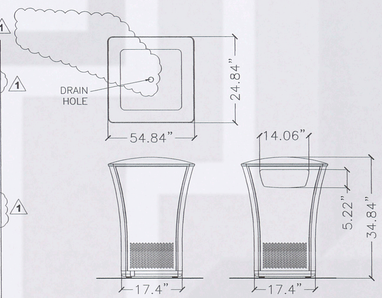

landscapeforms®
431 LAWNDALE AVE. PHONE: 800-521-2546
KALAMAZOO, MI 49048 FAX: 269-381-3455

CONFIDENTIAL DRAWING INFORMATION CONTAINED HEREIN IS THE PROPERTY OF LANDSCAPE FORMS, INC. INTENDED USE IS LIMITED TO DESIGN PROFESSIONALS SPECIFYING LANDSCAPE FORMS, INC. PRODUCTS AND THEIR DIRECT CLIENTS. DRAWING IS NOT TO BE COPIED OR DISCLOSED TO OTHERS WITHOUT THE CONSENT OF LANDSCAPE FORMS, INC.
©2004 LANDSCAPE FORMS, INC. ALL RIGHTS RESERVED.

TITLE: Side Opening Litter
DESIGN: PSOL
MOUNTING: None 1
PATENT: Patent Pending
FILE: 492-01
DATE: 7/23/2004
DRAWN BY: mdk

7 TRASH RECEPTACLE DETAIL

NTS

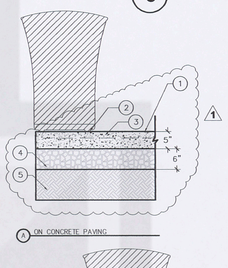

A ON CONCRETE PAVING

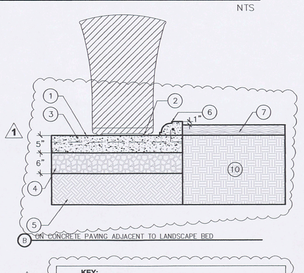

B ON CONCRETE PAVING ADJACENT TO LANDSCAPE BED

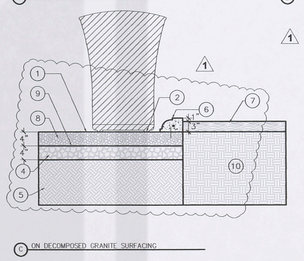

C ON DECOMPOSED GRANITE SURFACING

KEY:

1. FINISH GRADE
2. FREESTANDING
3. 3000 P.S.I. CONC. CHROMIX ADMIXTURE REF. MATERIALS PLANS FOR COLOR AND FINISH
4. FLEXIBLE LIMESTONE BASE, COMPACT TO 95%
5. NATIVE SOIL, OR FILL, COMPACT TO 95%
6. 4" LAND. CURB REF. DETAIL 5 SHT L1.113
7. MULCHED LANDSCAPE BED 3" DEPTH
8. 6" DECOMPOSED GRANITE GRAVEL COMPACTED TO 4" DEPTH.
9. FILTER FABRIC – SRW PRO PLUS V 502.
10. PLANTING BED REF LANDSCAPE DETAILS

8 TRASH RECEPTACLE INSTALLATION DETAILS

NTS

File: J:\Current Jobs\The Domain\DRAWINGS\CONSTRUCTION DOCUMENTS\SHEETS 10-100+\L1.115.DWG Layout: Layout1 User: John Plotted: Sep 18, 2006 – 8:30am