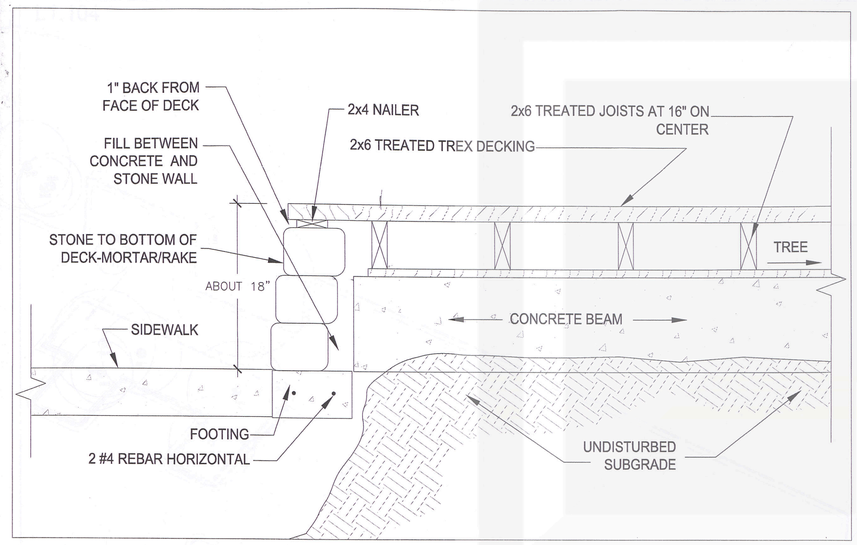

3 DECK & WALL DETAIL
SCALE: 1-1/2" = 1'

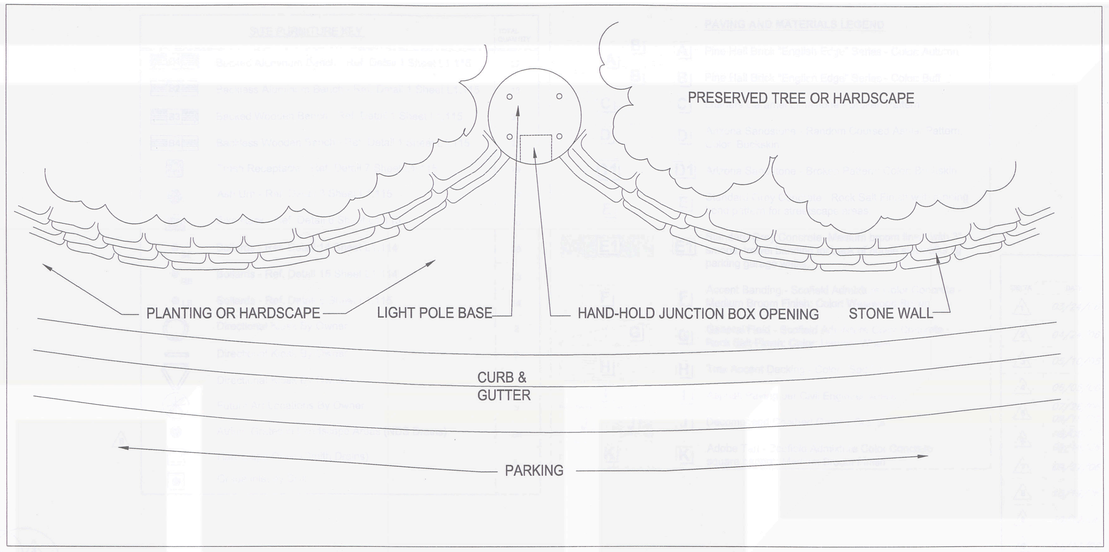

2 LIGHT POLE BASE AND WALL TYP.
N.T.S.

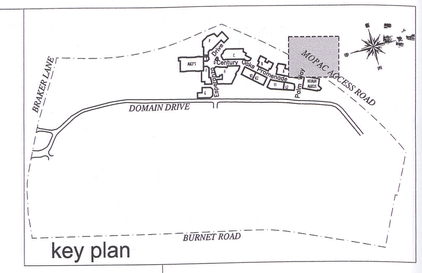

A JOINT VENTURE OF:
SIMON™ | ENDEAVOR REAL ESTATE GROUP

RECEIVED
DEC 15 2006
BY #302
BECK - AUSTIN

L1.104
L1.103

PAVING AND MATERIALS LEGEND

A	A	Pine Hall Brick "English Edge" Series - Color: Autumn
B	B	Pine Hall Brick "English Edge" Series - Color: Buff
C	C	Lueders Caramel Limestone - Broken Pattern
D	D	Arizona Sandstone - Random Coursed Ashlar Pattern; Color: Buckskin
D1	D1	Arizona Sandstone - Broken Pattern; Color: Buckskin
E	E	Standard Grey Concrete - Rock Salt Finish with running bond pattern for streetscape areas.
E1	E1	Standard Grey Concrete -Medium broom finish with 3" smooth trowel banding for back of house sidewalks @ parking garage walks.
F	F	Accent Banding - Scofield Admixture Color Concrete - Medium Broom Finish; Color: Westwood Brown
G	G	General Field - Scofield Admixture Color Concrete - Rock Salt Finish; Color: Harvest Wheat
H	H	Trex Accent Decking - Color: Saddle
I (Under Existing Trees / Beside Parking)	I	Asphalt Paving per Civil Engineer specs.
J	J	Decomposed Crushed Granite Gravel
K	K	Adobe Tan - Scofield Admixture Color Concrete - square pattern; Medium Broom Finish

SITE FURNITURE KEY		TOTAL QUANTITY
B1	Backed Aluminum Bench - Ref. Detail 1 Sheet L1.115	22
B2	Backless Aluminum Bench - Ref. Detail 1 Sheet L1.115	18
B3	Backed Wooden Bench - Ref. Detail 1 Sheet L1.115	36
B4	Backless Wooden Bench - Ref. Detail 1 Sheet L1.115	25
	Trash Receptacle - Ref. Detail 7 Sheet L1.115	79
	Ash Urn - Ref. Detail 3 Sheet L1.115	28
	Bike Rack - Ref. Detail 6 Sheet L1.115	10
BE	Bollards - Ref. Detail 14 Sheet L1.114	38
RB	Bollards - Ref. Detail 15 Sheet L1.114	43
LB	Bollards - Ref. Detail 5 Sheet L1.115	14
	Directional Kiosk By Owner	2
	Directional Kiosk By Owner	2
	Directional Kiosk By Owner	1
	Future Art Locations By Owner	5
	Atrium Grates in Landscape Areas (NDS Drains)	85
	Hardscape Drain (Smith Drains)	41
	Grade inlet by Civil	

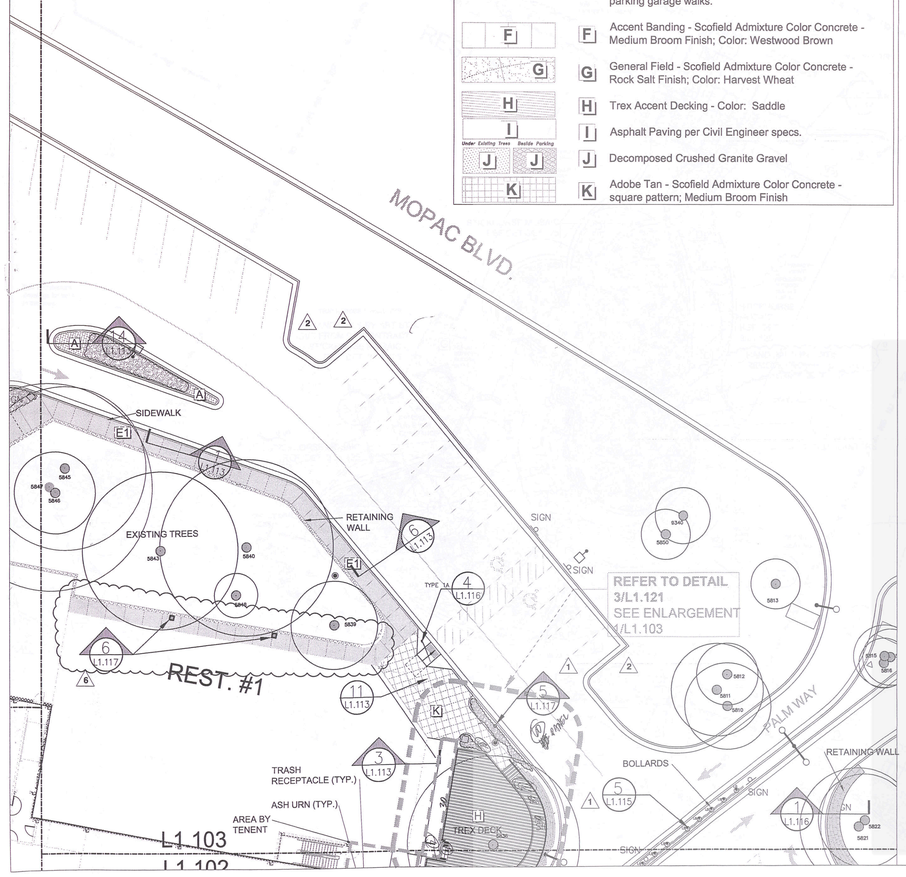

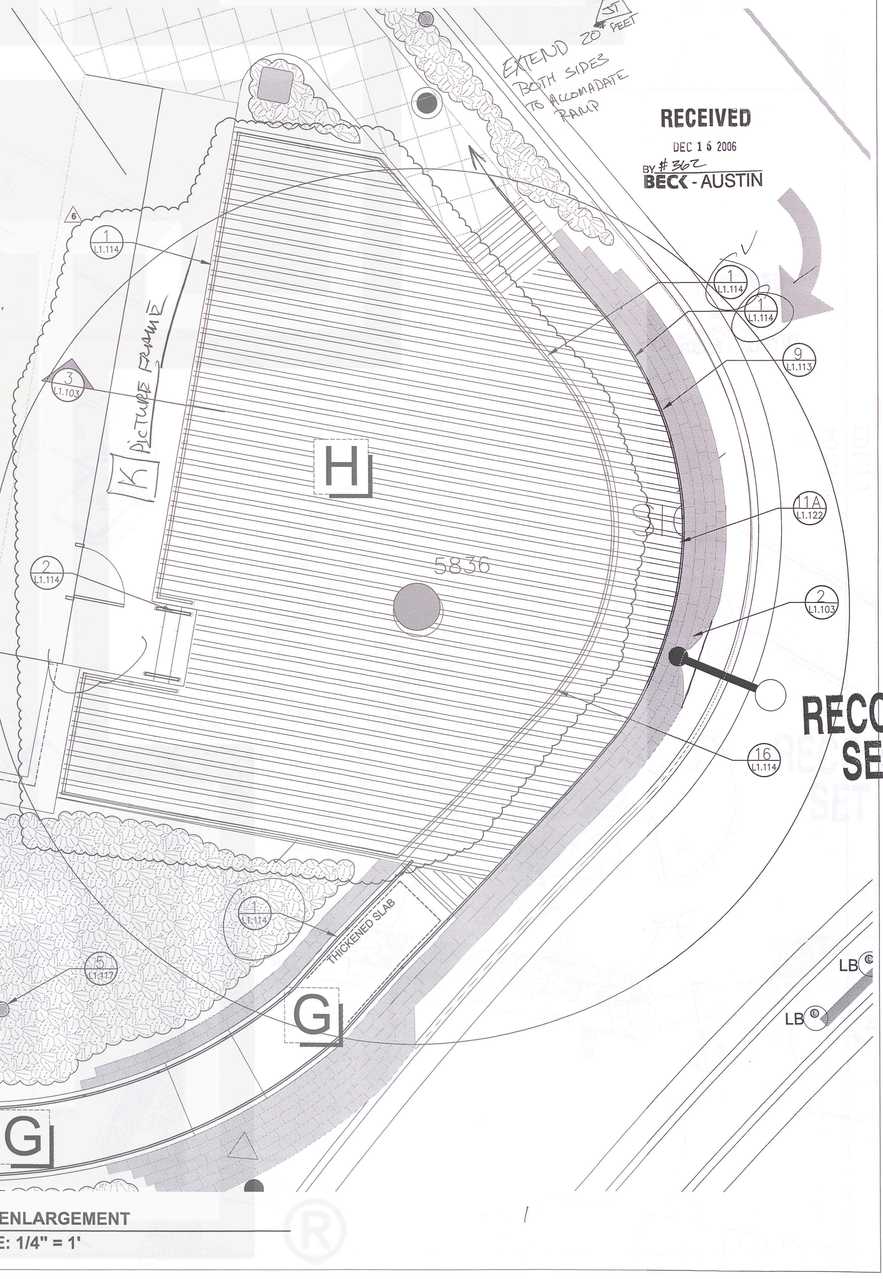

1 PLAN ENLARGEMENT
SCALE: 1/4" = 1'

REVISIONS		
DELTA	DATE	DESCRIPTION
1	03/24/06	REVISE HARDSCAPE ELEMENTS DUE TO VARIOUS CHANGES (OWNER-REQUESTED, CIVIL, ARCHITECTURAL)
2	05/10/06	GRANITE GRAVEL PATHS REMOVED FROM WEST PARKING AREA
3	08/08/06	UPDATE TO SITE FURNITURE KEY AND COUNTS
4	09/27/06	REVISE REST. #1/BLDG A DECK AREA LIGHT POLE BASE DETAIL AND DECK DETAIL
5	10/19/06	CLARIFIED SYMBOL FOR DRAIN
6	11/13/06	REVISED RETAINING WALL WEST REST. 1; CLARIFIED HANDRAILS NORTH REST. 1

J. Robert Anderson, FASLA
. landscape architects . austin. texas .
3718 MANCHACA ROAD
AUSTIN, TEXAS 78704
512.440.1049
440-8000 FAX

REGISTERED LANDSCAPE ARCHITECT J. ROBERT ANDERSON STATE OF TEXAS 754

11/13/06 SCALE: 1" = 20'
0 10' 20' 40' 60'

Project:
the domain
AUSTIN, TEXAS

RECORD SET

JPRA ARCHITECTS
31000 Northwestern Suite 100
Farmington Hills, Michigan 48334-2585
phone 248 737 0160 fax 248 737 9161

SHEET TITLE:
HARDSCAPE MATERIALS PLAN

Sheet No.
L1.103