


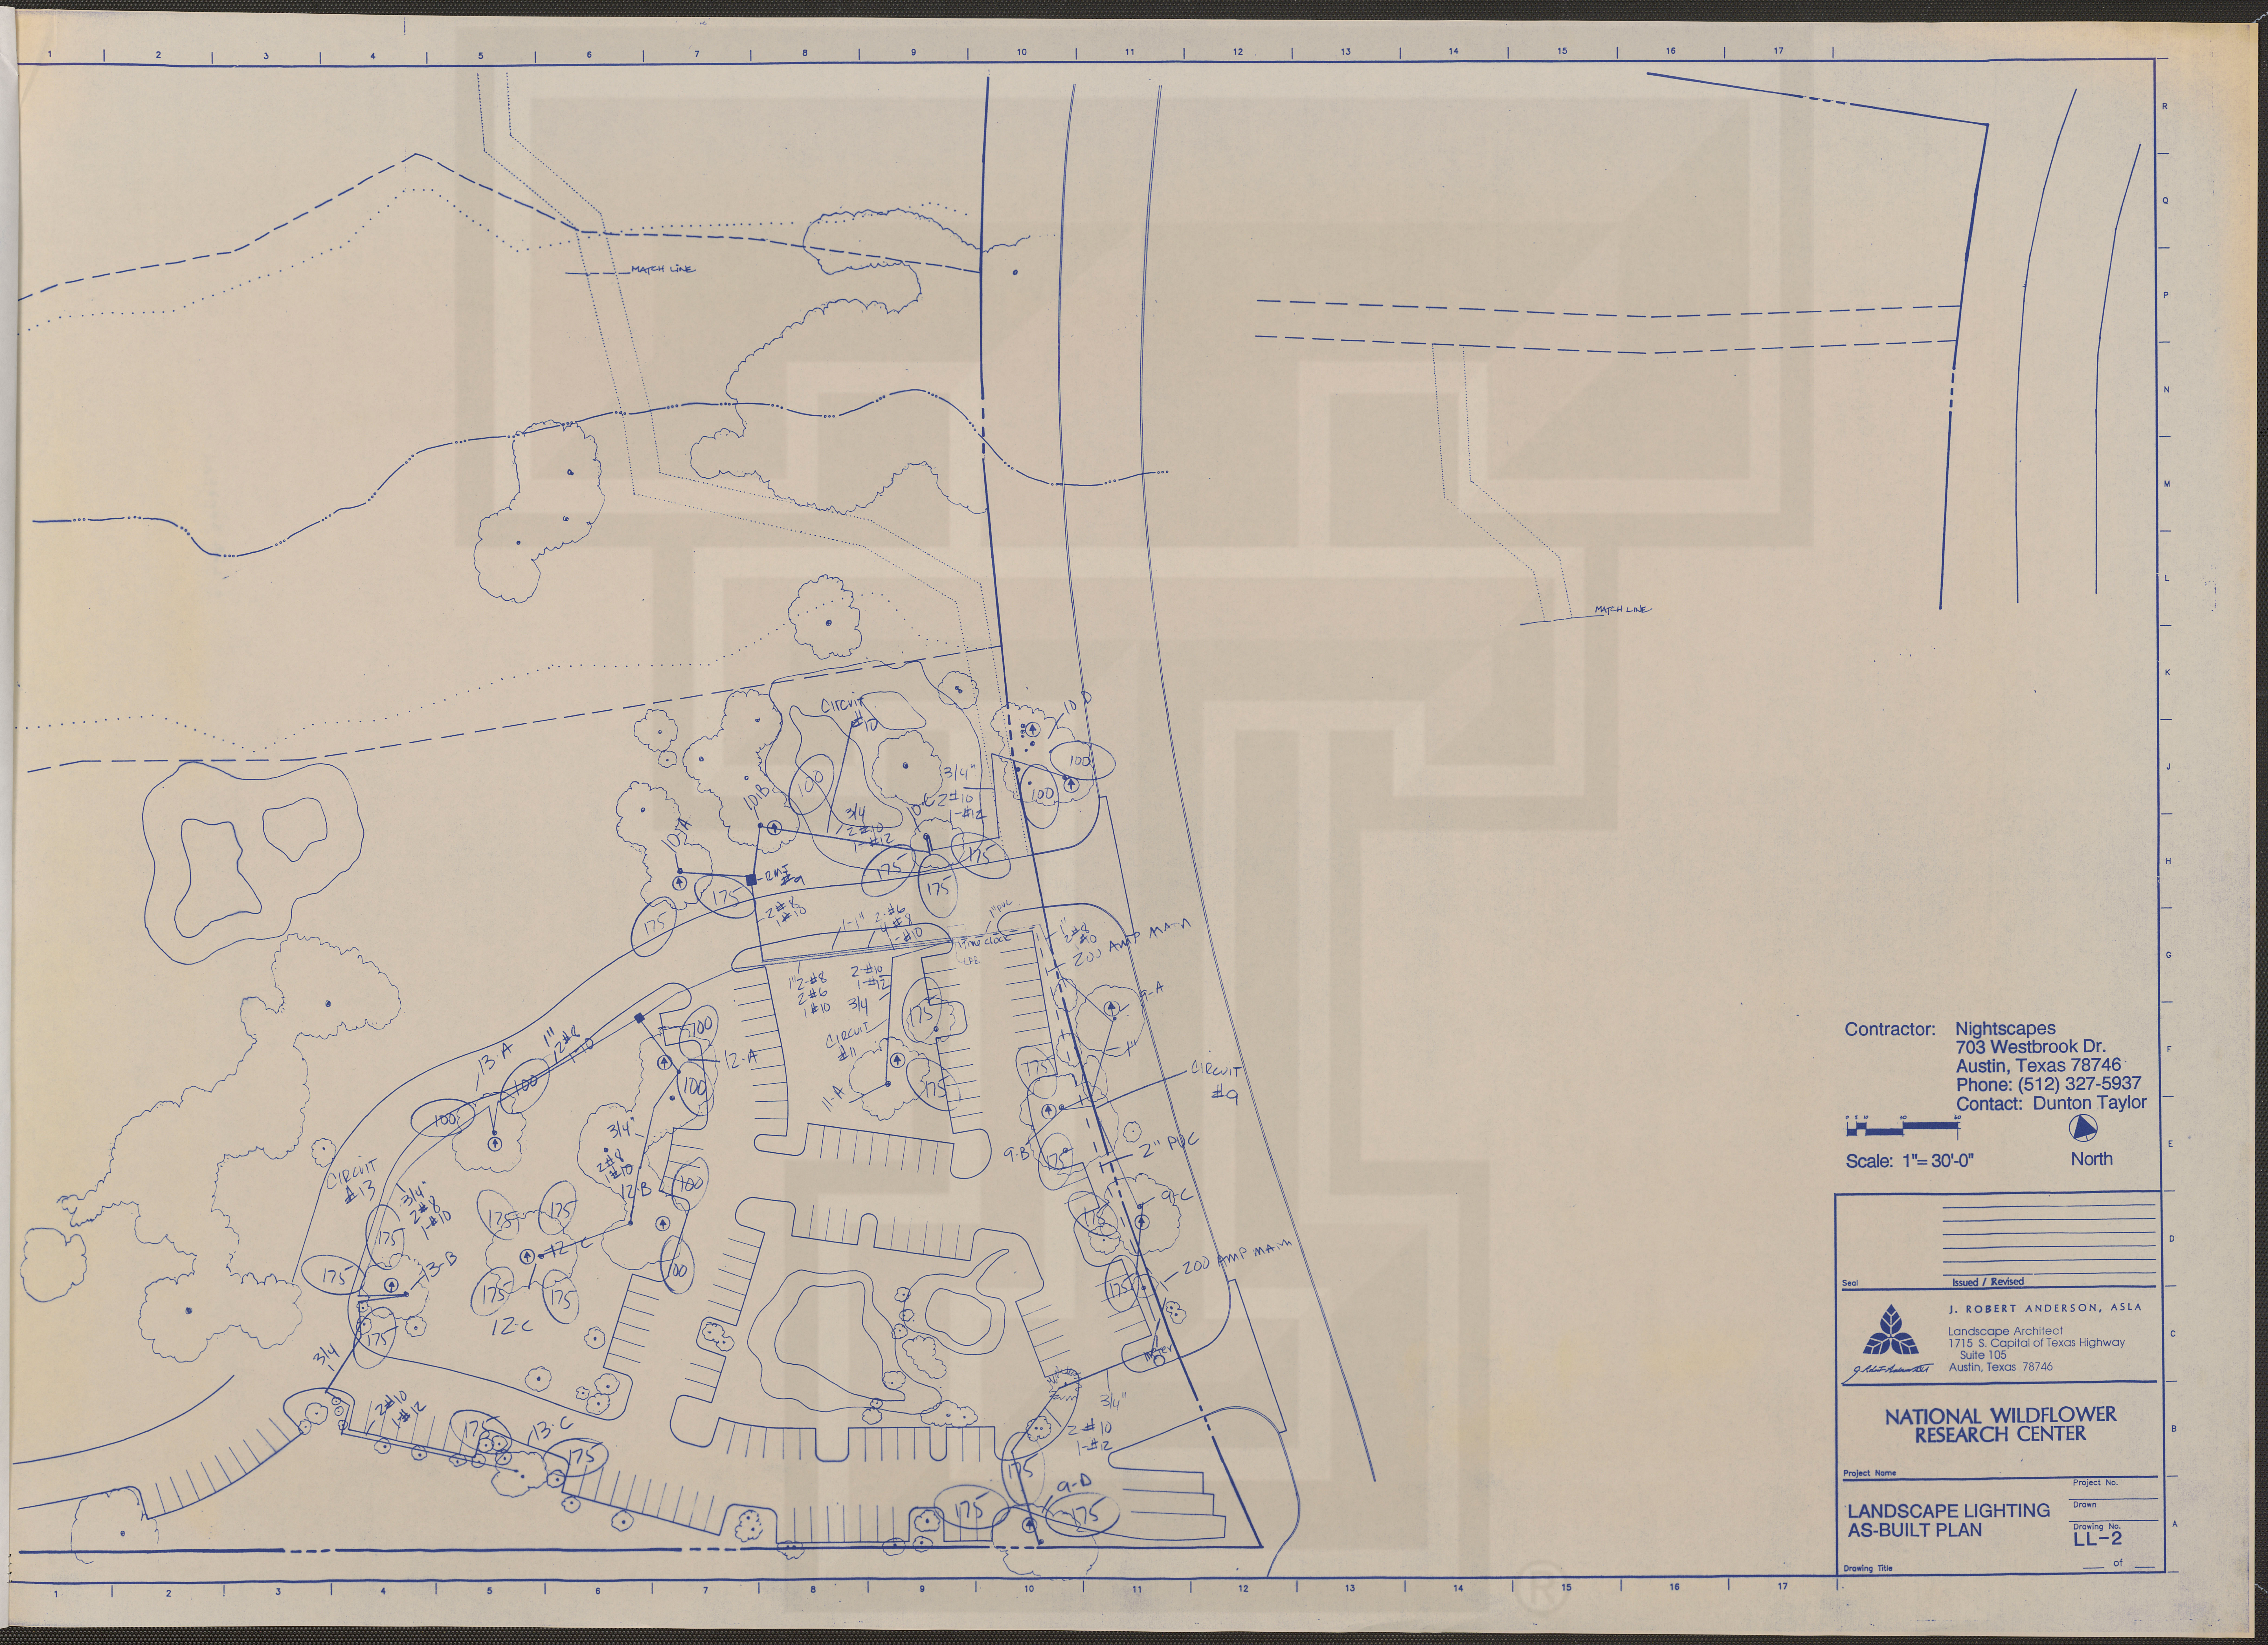

Contractor: Nightscapes
703 Westbrook Dr.
Austin, Texas 78746
Phone: (512) 327-5937
Contact: Dunton Taylor

Scale: 1" = 30'-0"  North

Seal		Issued / Revised	
		J. ROBERT ANDERSON, ASLA Landscape Architect 1715 S. Capital of Texas Highway Suite 105 Austin, Texas 78746	
NATIONAL WILDFLOWER RESEARCH CENTER			
Project Name		Project No.	
LANDSCAPE LIGHTING AS-BUILT PLAN		Drawn	
Drawing Title		Drawing No. LL-2	
		of	